

BUILDING NAME	DOORS							FRAMES:				C FIRE RATING	HDWE CODE	REMARKS
	DOOR NO. DOOR SIZE TYPE MAT'L FINISH LIGHT							TYPE MAT'L FINISH LIGHT						
MILLENNIUM LIBRARY	D101	914 X 2134	4	PS	PT	GL-2	EXISTING DOOR FRAME TO REMAIN					90 MINUTE	1.0	NEW DOOR PANEL
MILLENNIUM LIBRARY	D201	914 X 2134	3	PS	PT	GL-2	EXISTING DOOR FRAME TO REMAIN					45 MINUTE	2.0	NEW DOOR PANEL
MILLENNIUM LIBRARY	D202A / D202B	EXISTING DOOR PANELS TO REMAIN						EXISTING DOOR FRAME TO REMAIN				45 MINUTE	3.0	-
MILLENNIUM LIBRARY	D203A / D203B	EXISTING DOOR PANELS TO REMAIN						EXISTING DOOR FRAME TO REMAIN				45 MINUTE	4.0	-
266 GRAHAM	D204A / D204B	EXISTING DOOR PANELS TO REMAIN						EXISTING DOOR FRAME TO REMAIN				45 MINUTE	5.0	-
266 GRAHAM	D205	EXISTING DOOF PANELS SHALL AREA BY COW (BE STOF	RED IN DE	SIGNATE	SIDELIGHTS TO REMAIN						-	-	PROVIDE FACE PLATE(/S) TO COVER HOLES LEFT AFTER REMOVAL OF EXISTING DOOK PANELS/HARDWARE. FINISH TO MATCH EXISTING FRAME
266 GRAHAM	D206	1068 X 2235	1	ALUM	ANOD	GL-1	A	ALUM	ANOD	GL-1		-	7.0	NEW DOOR: KAWNEER 350 MEDIUM STILE STANDARD ENTRANCES OR APPROVED EQUAL. NEW FRAME: KAWNEER VERSAGLAZE 451 OR APPROVED EQUAL
266 GRAHAM	D207	1068 X 2235	1	ALUM	ANOD	GL-1	A	ALUM	ANOD	GL-1		-	11.0	NEW DOOR: KAWNEER 350MEDIUM STILE STANDARD ENTRANCES OR APPROVED EQUAL. NEW FRAME: KAWNEER VERSAGLAZE 451 OR APPROVED EQUAL
266 GRAHAM	D208	914 X 2134	3	PS	PT	GL-2	EXISTING DOOR FRAME TO REMAIN					90 MINUTE	10.0	NEW DOOR PANEL
266 GRAHAM	D209	914 X 2134	3	PS	PT	GL-2	EXISTING DOOR FRAME TO REMAIN					90 MINUTE	10.0	NEW DOOR PANEL
266 GRAHAM	D210	EXISTING DOOR PANELS TO BE REMOVED. DOOR PANELS SHALL BE STORED IN DESIGNATED AREA BY COW CONTRACT ADMINISTRATOR.						EXISTING DOOR FRAME AND SIDELIGHTS TO REMAIN				-	-	PROVIDE FACE PLATE(/S) TO COVER HOLES LEFT AFTER REMOVAL OF EXISTING DOOR PANELS/HARDWARE. FINISH TO MATCH EXISTING FRAME
266 GRAHAM	D211	2 X 914 X 2134	2	PS	PT	GL-2	EXISTING DOOR FRAME TO REMAIN					45 MINUTE	9.0	NEW DOOR PANELS

LEGEND

GL-1

GL-2

PΤ

DUAL TEMPERED GLAZED UNIT; INSULATING GLASS, 25MM OVERALL THICKNESS OR AS REQUIRED FOR DOOR FRAMING. GLASS: 6MM THICK TEMPERED. SINGLE PANEL WIRED GLAZED UNIT; 6MM THICK FIRE RATED GLAZING (PRODUCT: WIRELITE NT OR APPROVED EQUAL) HOLLOW METAL

FIRE RATING PS


PRESSED STEEL PAINT FINISH


STC SOUND TRANSMISSION CLASS (Non-tested) DECORATIVE STICKER FILM. FINAL COLOUR TBD. F-1

* GLAZING TO BE FIRE RESISTIVE-RATED GLAZING TO MAX SIZES BY NBC

HARDWARES


REFER HARDWARE SETS TO SPECIFICATIONS. ALL DOOR OPERATORS AND CLOSERS REQUIRE FORCE TO BE ADJUSTED TO NOT MORE THAN 66 N (13.8 LB.) TO STOP DOOR MOVEMENTS IN ACCORDANCE WITH WADS SECTION 3.1.3 AND ENSURE PROPER SELF-LATCHING IN RATED CONDITIONS

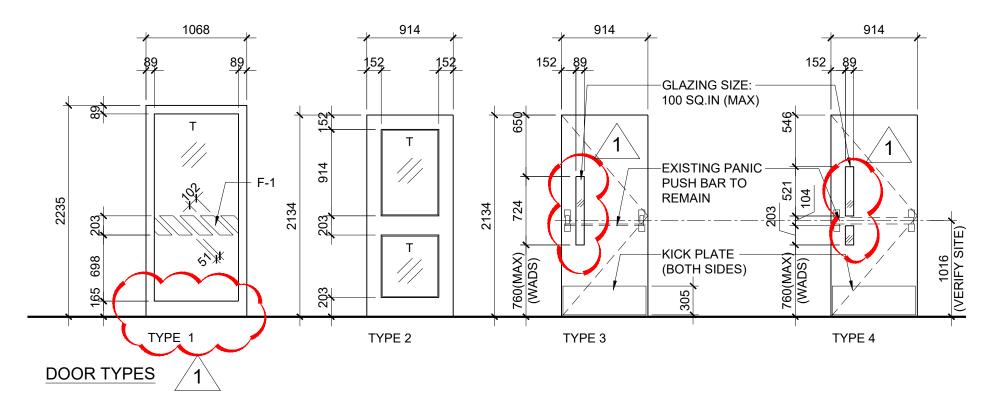

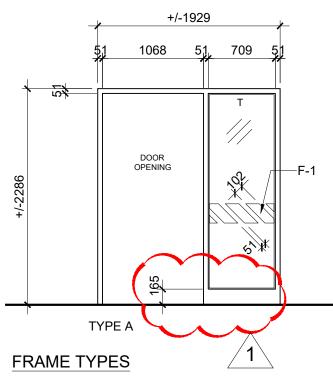


**NOTES TO APPROVED EQUIVALENTS:

- 1. THE OPERATOR CAN FIT UNDER THE PIPES ON DOORS D202A/B WITHOUT SACRIFICING HEAD SPACE. SECTION DRAWING (RA.02) SHOWS ADO'S FROM HORTON AND NABCO ARE BIGGER IN COMPARISON TO THE ADO FROM ASSA ABLOY. THE HEADER (HORTON 4100) WILL HAVE TO MOUNT LOWER AND HUNG INTO THE OPENING FURTHER. MANUFACTURER TO CONFIRM THAT THE EXISTING HEAD SPACE (BETWEEN EXISTING STANDPIPE AND DOOR FRAME) WILL BE ENOUGH TO MOUNT THE ADO. EXISTING FIRE STANDPIPE TO REMAIN IN PLACE.
- 2. THE OPERATOR CAN ACHIEVE AN INFINITE HOLD-OPEN PERIOD WITHOUT TIMING OUT AND CLOSING OR REQUIRING RESET - REQUIREMENT FOR THE CARD ACCESS HALLWAY DOORS. THE "TIME OUT" FUNCTION OF THE DOOR OPERATOR MUST ACHIEVE THE INFINITE HOLD OPEN REQUIRED.
- 3. IT IS THE CONTRACTORS / MANUFACTURER / SUPPLIERS RESPONSIBILITY TO CONFIRM COMPLIANCE TO ABOVE AND UNLESS THE CONDITIONS ABOVE ARE MET, THE PROPOSED MATERIAL WILL NOT BE CONSIDERED APPROVED EQUAL

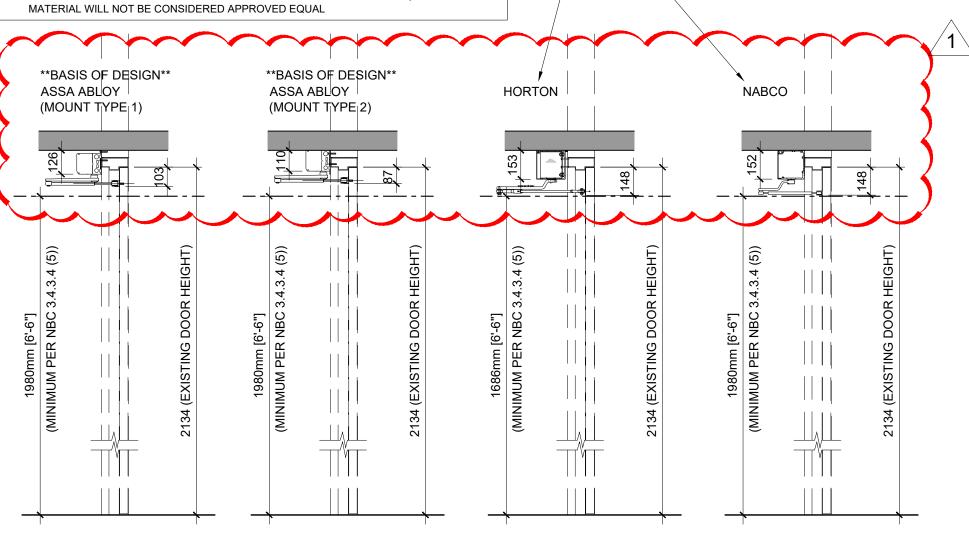


4 DOORS D202a AND D202b SECTION (INCLUDING ADDED EQUAL REQUEST) A3.0 SCALE 1:20

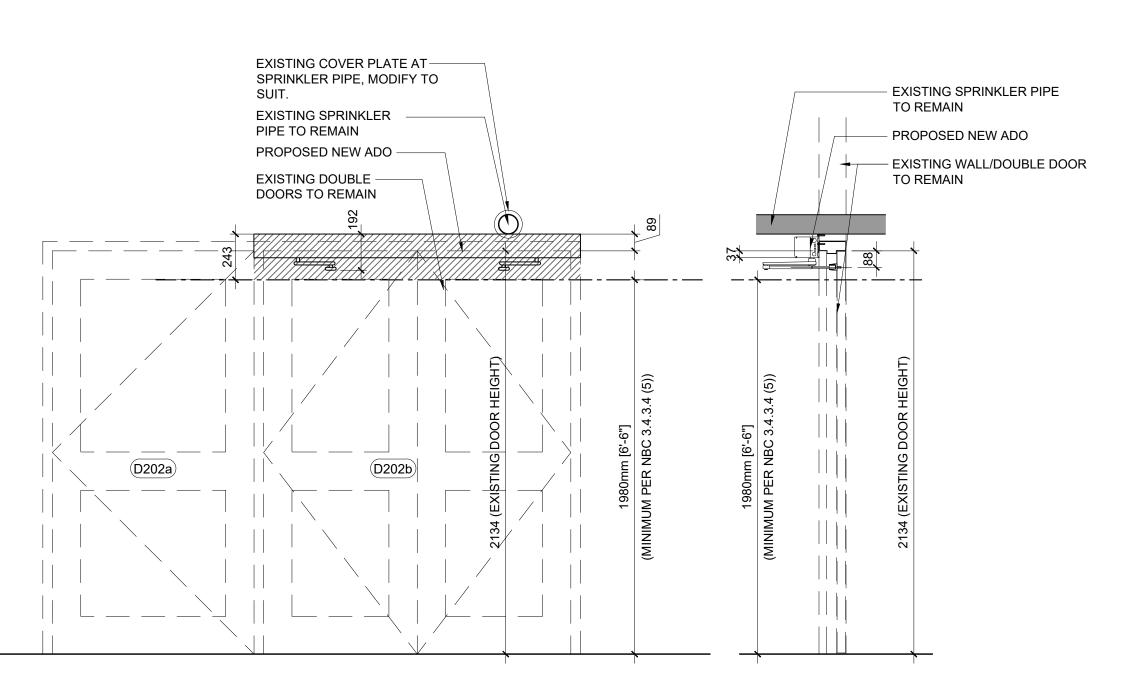

3 DOORS D202a AND D202b SECTION AND ELEVATION A3.0 SCALE 1:20



SHEET TITLE DOOR SCHEDULE, ENLARGED PLANS, DOOR AND FRAME TYPES

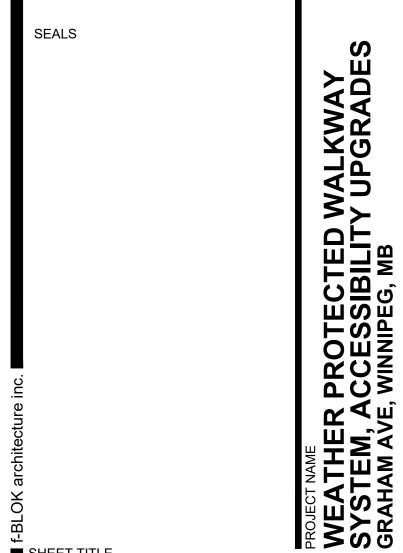

DATE

DATE ISSUED FEBRUARY 22, 2022


2022/02/22 ISSUED FOR TENDER

REVISION/ISSUANCE 2022/03/22 ISSUED FOR ADDENDUM 2 32 Z

S

FOR TENDER ONLY NOT TO BE USED FOR CONSTRUCTION

CONTRACTOR

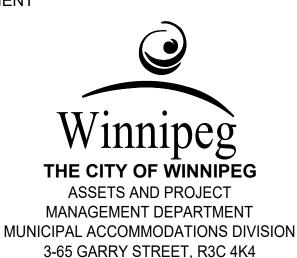

f-BLOK architecture inc 217-1460 Chevrier BLVD Winnipeg | Manitoba | CANADA | R3T 1Y6 204.943.5087 | www.f-BLOK.ca | info@f-BLOK.ca

CLIENT

