


LAST SAVE: 2021/06/01 - 2:58pm  
PATH: P:\Projects\2021\21-0107-003 Dwg\Elec\1-0102-ESLD-P003.dwg  
A1 SIZE - 594mm x 841mm

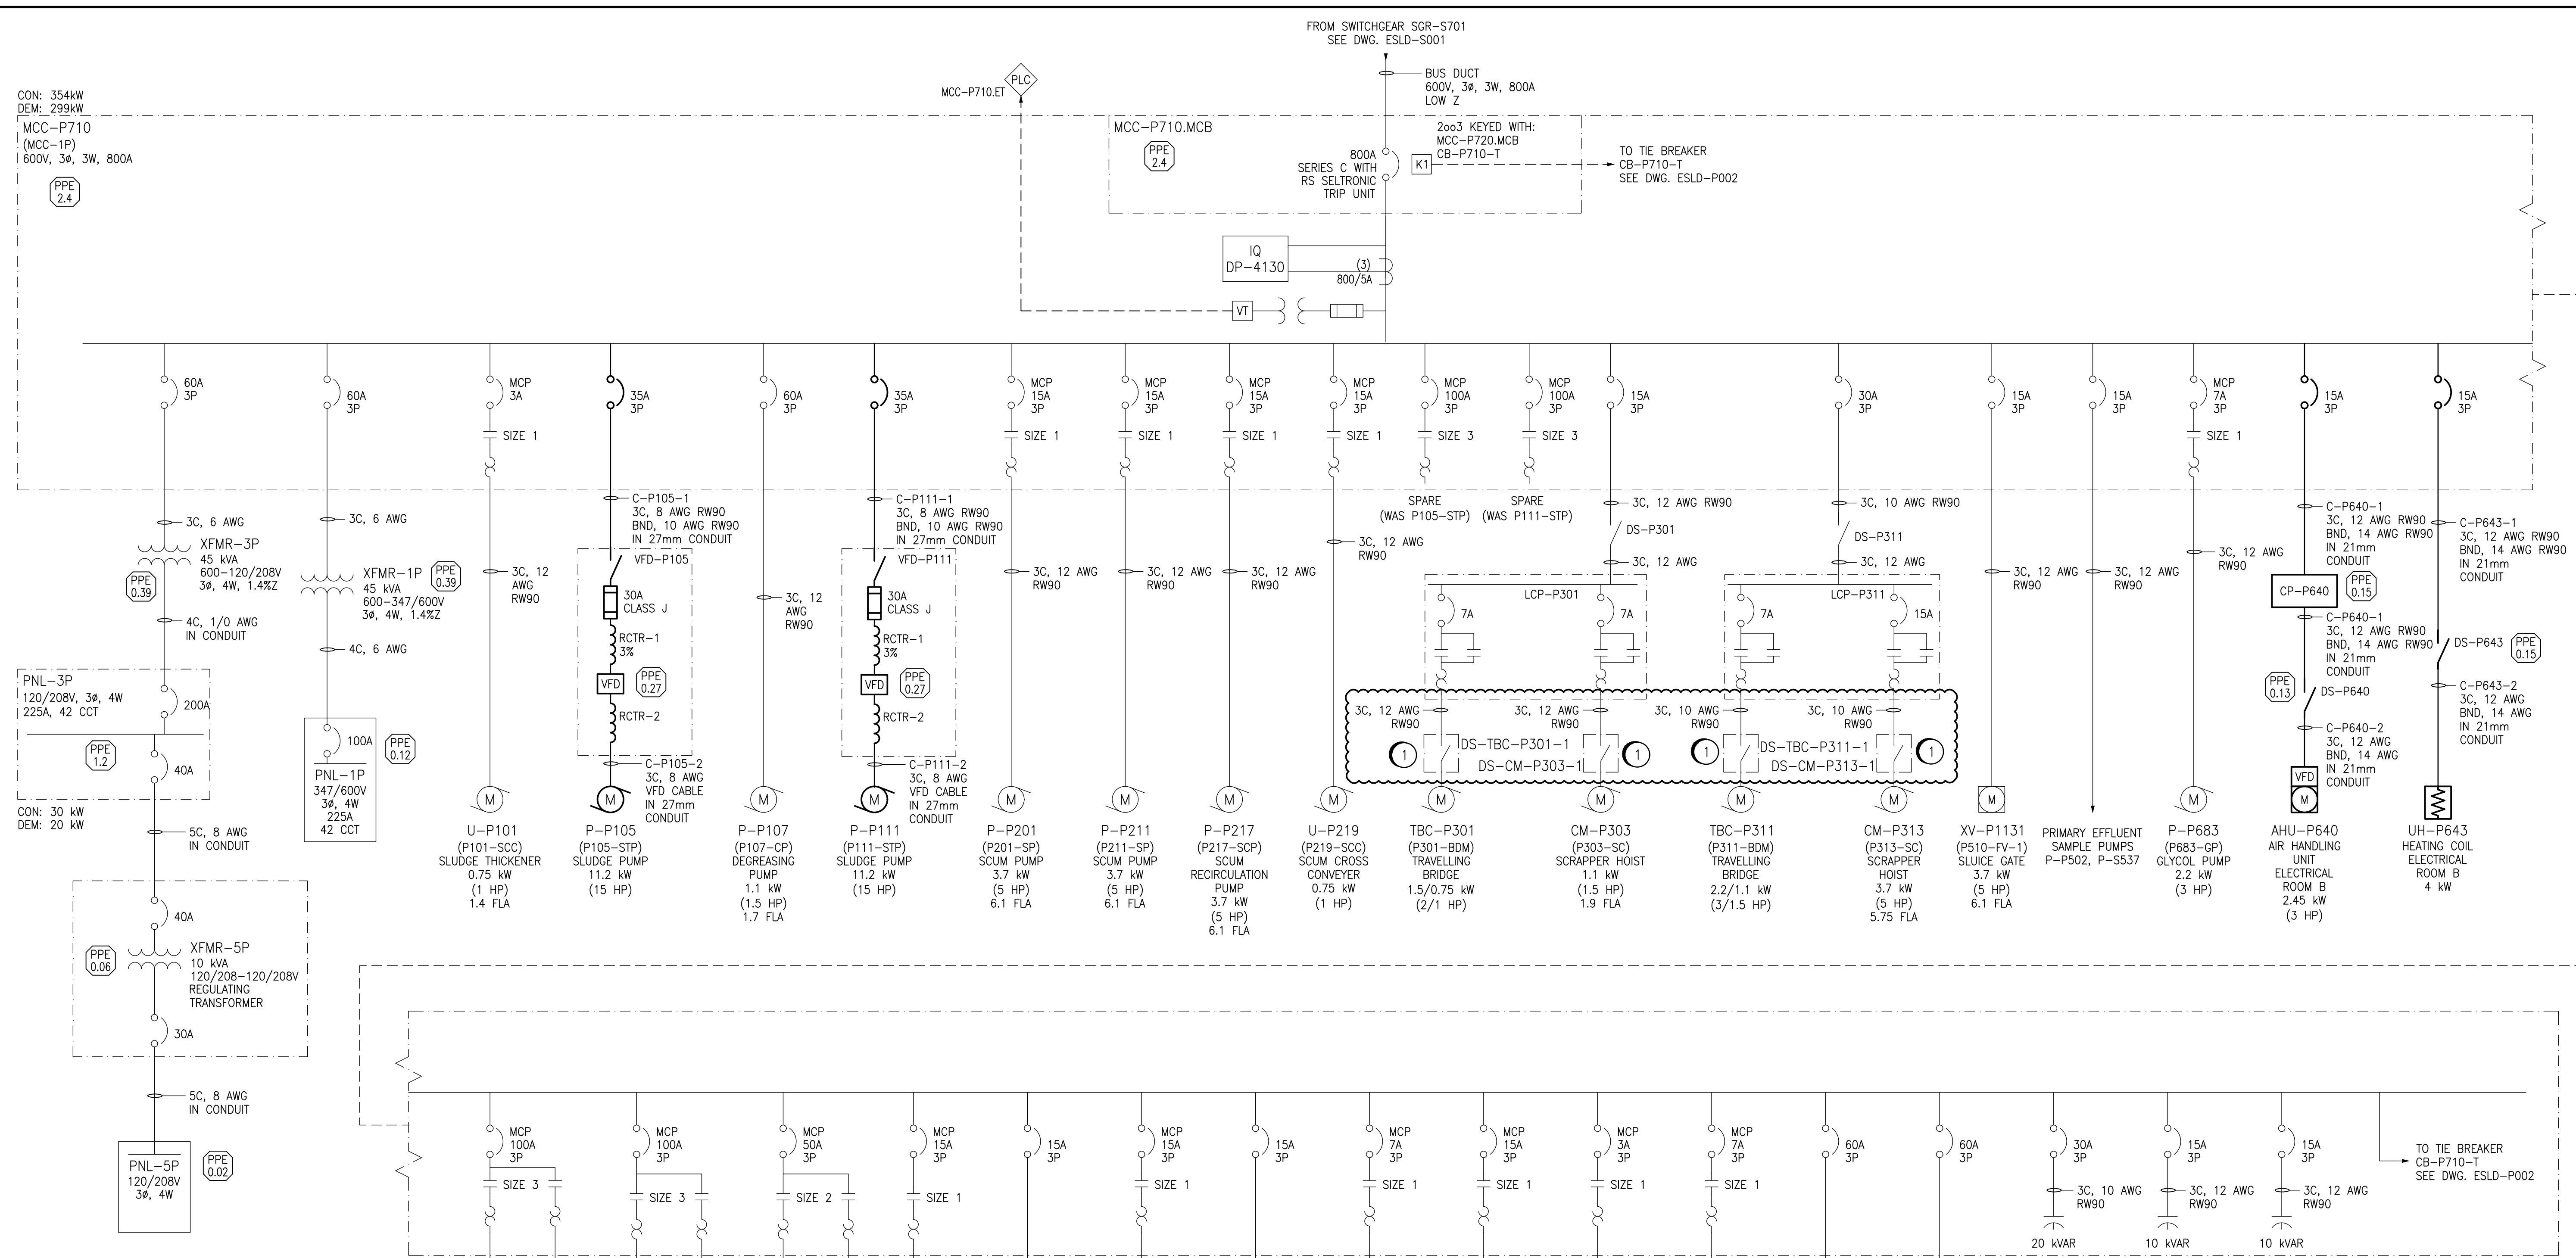

- GENERAL NOTES:**

  - THIS DRAWING SUPERSEDES PART OF DWG. 1-0102P-E0010.
  - RE-TAG SWITCHGEAR, DISTRIBUTION EQUIPMENT, AND ALL LOADS. PROVIDE NEW LAMACIDS. PREVIOUS IDENTIFIERS SHOWN IN PARENTHESES. THESE ITEMS ARE NOT SHOWN CLOUDED.
  - THIS DRAWING IS BASED UPON EXISTING DOCUMENTATION, OF THE EXISTING FACILITY.
  - CLOUDED PORTION INDICATES NEW WORK / MODIFICATIONS TO EXISTING EQUIPMENT, EXCEPT AS NOTED. ALL CLOUDED PORTIONS OF WIRING, CONDUIT ARE NEW AND ARE TO BE PROVIDED BY THE CONTRACTOR.
  - P. ENG. SEAL PERTAINS TO THE CLOUDED AREAS ONLY.
- SPECIFIC NOTES:**

  - DISCONNECT AND REMOVE EXISTING WIRING, CONDUIT AND ASSOCIATED ACCESSORIES. PROVIDE NEW LOCKABLE DISCONNECT SWITCH AND NEW WIRING IN CONDUIT.

1-0102-EGAD-P004		ELECTRICAL POWER AND INSTRUMENTATION MAIN FLOOR PLAN PRIMARY CLARIFIERS 3 ELEV 234M																					
REFERENCE DRAWINGS		DESCRIPTION																					
Certificate of Authorization KGS Group No. 245		<table><tr><td colspan="2">DESIGNED BY: D. GUEVARRA</td><td colspan="2">CHECKED BY: J. BOUCHARD</td></tr><tr><td colspan="2">DRAWN BY: D. SHABATAEV</td><td colspan="2">APPROVED BY: J. BOUCHARD</td></tr><tr><td colspan="2">SCALE: NTS</td><td colspan="2">ISSUED FOR CONSTRUCTION BY: T. TURZAK</td></tr><tr><td colspan="2">DATE: 2021/05/11</td><td colspan="2">DATE: 2021/06/01</td></tr><tr><td colspan="2">CONSULTANT NO.: 21-0107-003_E01</td><td colspan="2"></td></tr>
00 ISSUED FOR CONSTRUCTION		2021/06/01																					
NO. REVISIONS		DATE DESIGN CHECK																					

ENGINEER'S SEAL

SOUTH END SEWAGE TREATMENT PLANT (SEWPPC)  
PRIMARY CLARIFIERS REFURBISHMENT WORKS  
ELECTRICAL - SINGLE LINE DIAGRAM  
PRIMARY CLARIFIERS  
MCC-P710

CITY DRAWING NUMBER  
1-0102-ESLD-P003

SHEET  
00

REV.  
A1

SIZE  
A1