


**A SECTION - STA. 1+590 (NORTHBOUND)**  
 SCALE: H=1:100, V=1:50

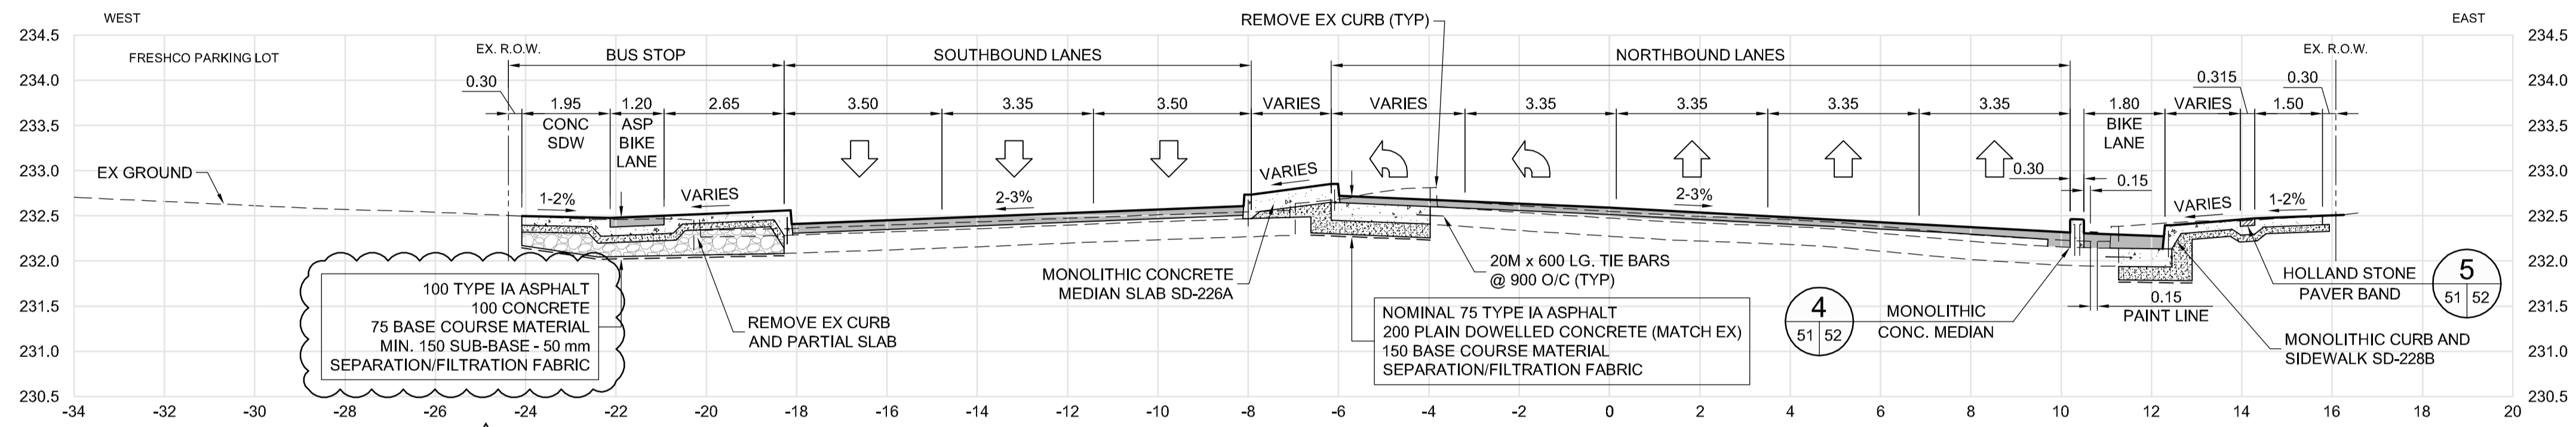

**B SECTION - STA. 2+130 (NORTHBOUND)**  
 SCALE: H=1:100, V=1:50

**ENGINEERS  
 GEOSCIENTISTS  
 MANITOBA**  
 Certificate of Authorization  
**Dillon Consulting Limited (MB)**  
 No. 1789 Date: 2021/12/17

**PRELIMINARY ONLY  
 NOT FOR CONSTRUCTION**

UNDERGROUND STRUCTURES  SUPV. U/G STRUCTURES      DATE  <small>LOCATION OF UNDERGROUND STRUCTURES AS SHOWN ARE BASED ON THE BEST INFORMATION AVAILABLE, BUT NO GUARANTEE IS GIVEN THAT ALL EXISTING UTILITIES ARE SHOWN OR THAT THE GIVEN LOCATIONS ARE EXACT. CONFIRMATION OF EXISTENCE AND EXACT LOCATION OF ALL SERVICES MUST BE OBTAINED FROM THE INDIVIDUAL UTILITIES BEFORE PROCEEDING WITH CONSTRUCTION.</small>	B.M. ELEV.  <table border="1"> <tr><td> </td><td> </td><td> </td><td> </td></tr> <tr><td> </td><td> </td><td> </td><td> </td></tr> <tr><td> </td><td> </td><td> </td><td> </td></tr> <tr><td> </td><td> </td><td> </td><td> </td></tr> </table>																	DESIGNED BY      RTP/TJH DRAWN BY         TJH CHECKED BY       TS APPROVED BY      MRD		ENGINEER'S SEAL 		<b>THE CITY OF WINNIPEG</b> PUBLIC WORKS DEPARTMENT  <b>2020 PAVEMENT RENEWALS</b> PEMBINA HIGHWAY REHABILITATION CHEVRIER BLVD TO MCGILLIVRAY BLVD	CITY DRAWING NUMBER P-3550-51
1 ISSUED FOR ADDENDUM #4      22/01/24      MRD 0 ISSUED FOR TENDER            21/12/17      MRD NO.    REVISIONS                    DATE    BY	HOR. SCALE    AS NOTED VERTICAL       AS NOTED	RELEASED FOR CONSTRUCTION  DATE	CONSULTANT PROJECT NUMBER <b>20-2434</b>	SHEET      OF <b>51         73</b>	CONSULTANT DRAWING NUMBER																		

C:\pwworking\directory\projects\2020\40jph\mst18167\202434-PEM-CI-CON-SECTIONS.dwg