


1 SECTION - WASHROOM
S301 1 : 64

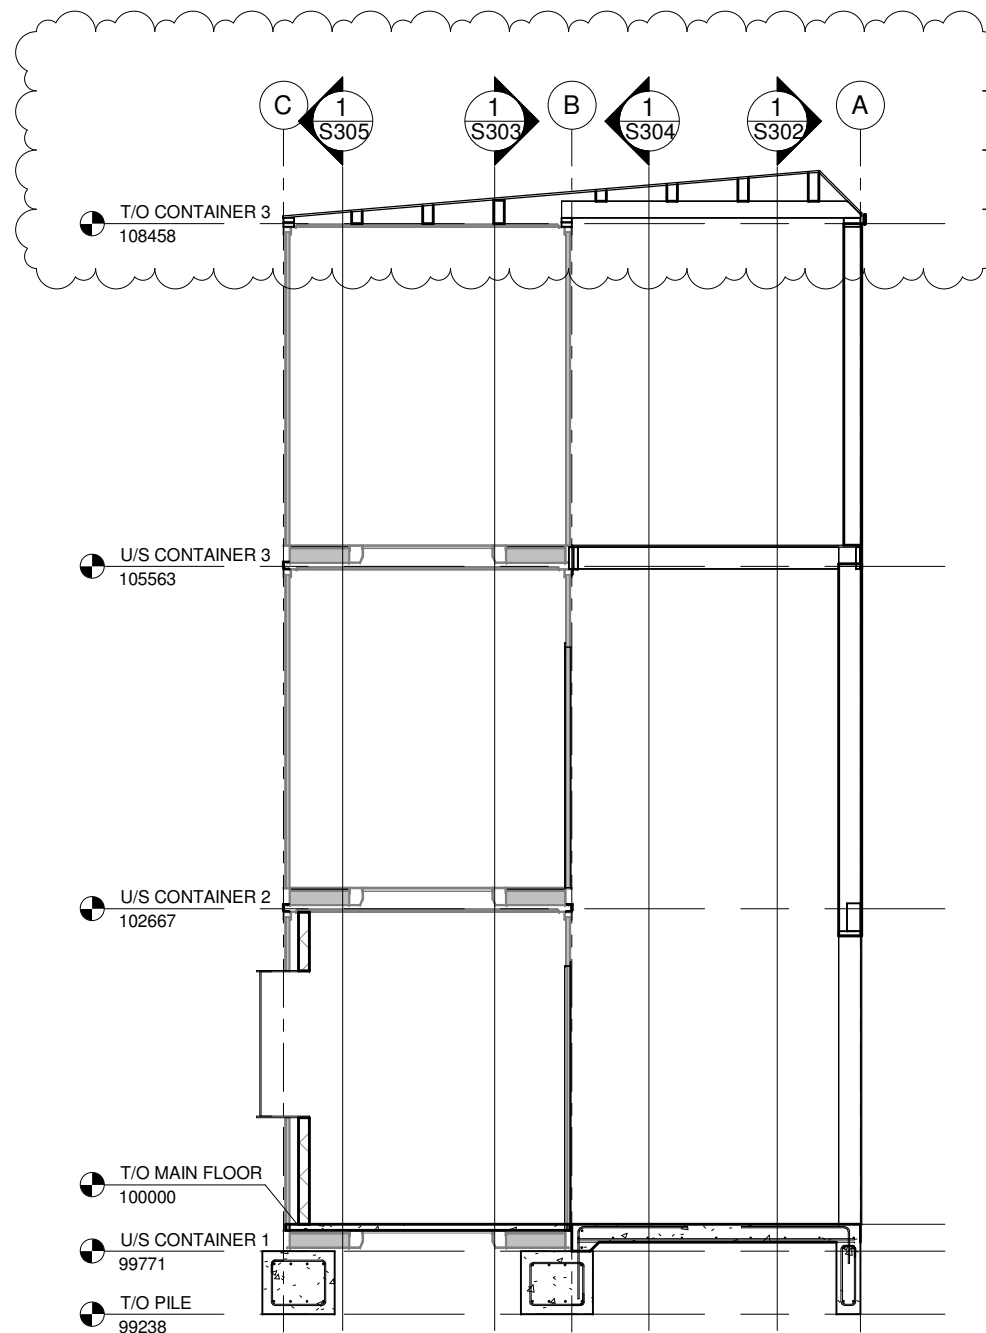

2 SECTION - OFFICE
S301 1 : 64

**ENGINEERS
GEOLOGISTS
MANITOBA**
Certificate of Authorization
SWP Projects Ltd.
No. 6036 Expiry: April 30, 2021



SWP PROJECTS LTD.
678 MAIN STREET - 2ND FLR WINNIPEG, MB R3B 1E4
(P) 204.586.3636
(C) 204.330.2611
(E) david@totalprojectmgmt.ca

715 MAIN STREET PUBLIC TOILET
THE CITY OF WINNIPEG
BID OPPORTUNITY 54-2021

No.	Description	Date
1	ISSUED FOR CONSTRUCTION	21-03-04
2	ROOF REVISION	21-03-18

BUILDING SECTIONS

Project number	20-104	S301
Date	2021-03-18	
Drawn by	DP	
Checked by	DP	
Scale 1 : 64		

2021-03-18 4:24:12 PM