



**1 ROOF SECTION - LOW SIDE**  
S402 1 : 12

**2 ROOF SECTION - GRID B**  
S402 1 : 12

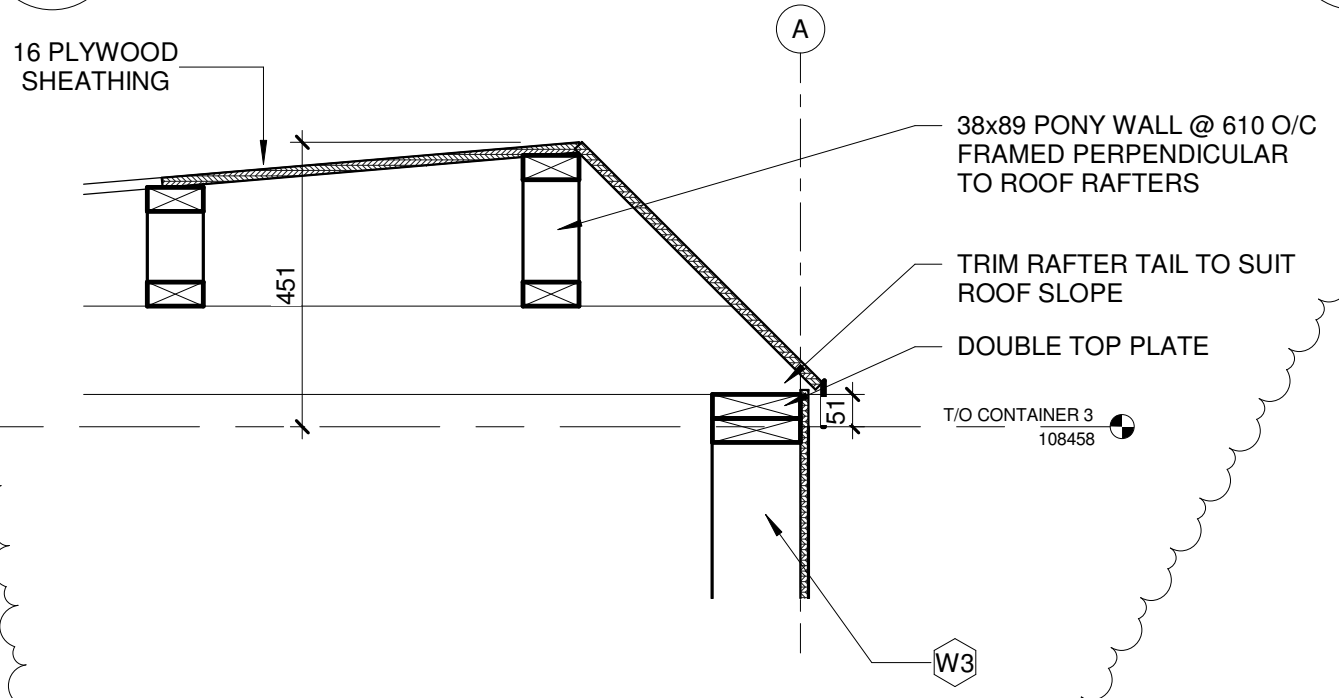

**3 ROOF SECTION - HIGH SIDE**  
S402 1 : 12

**ENGINEERS  
GEOSCIENTISTS  
MANITOBA**  
 Certificate of Authorization  
 SWP Projects Ltd.  
 No. 6036 Expiry: April 30, 2021

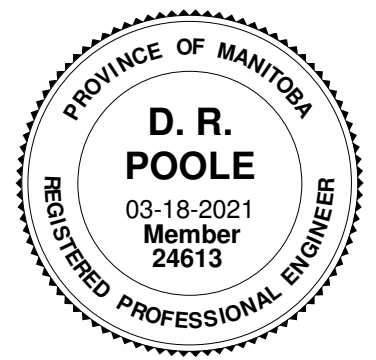

**SWP PROJECTS LTD.**  
 678 MAIN STREET - 2ND FLR WINNIPEG, MB R3B 1E4  
 (P) 204.586.3636  
 (C) 204.330.2611  
 (E) david@totalprojectmgmt.ca

**715 MAIN STREET PUBLIC TOILET**  
 THE CITY OF WINNIPEG  
 BID OPPORTUNITY 54-2021

No.	Description	Date
1	ISSUED FOR CONSTRUCTION	21-03-04
2	ROOF REVISION	21-03-18

**SECTIONS AND DETAILS**

Project number	20-104	<b>S402</b>
Date	2021-03-18	
Drawn by	DP	
Checked by	DP	
Scale 1 : 12		

2021-03-18 4:24:17 PM