



NOTE: CONTRACTOR SHALL REFER TO CITY OF WINNIPEG STANDARD CONSTRUCTION SPECIFICATIONS

NOTES:

1. THESE DRAWINGS SHALL NOT BE SCALED.
2. THE CONTRACTOR SHALL VISIT THE SITE AND SATISFY ONESELF ALL DIMENSIONS, DATUM, AND DETAILED INFORMATION SHOWN ARE CORRECT.
3. ALL PRODUCTS AND MATERIALS TO BE USED AND INSTALLED SHALL CONFORM WITH MANUFACTURER'S SPECIFICATIONS & APPLICABLE CODES.
4. THE CONTRACTOR SHALL BE RESPONSIBLE TO PATCH AND MAKE GOOD ALL EXISTING CONSTRUCTION AFFECTED BY THE REMOVAL OF ALL ITEMS FORMING THE PART OF THE RENOVATION WORK.
5. USE SPECIFIED BACKFILL IN ALL TRENCHES RUNNING BELOW ALL STRUCTURES, PAVING, WALKWAYS ETC.
6. ALL EXISTING ROADS, SIDEWALKS, FENCING, PAVING & APPROACHES TO REMAIN TO BE PROTECTED DURING CONSTRUCTION TO THE CITY OF WINNIPEG STANDARDS AT THE CONTRACTORS OWN COSTS.
7. FILL ALL HOLES & LOW AREAS TO DESIGN SUB-GRADE W/ COMPACTED FILL (SUITABLE TO SURFACE FINISH). FOR PAVED AREAS USE COMPACTED GRANULAR BASE (REFER TO SPECIFICATIONS).

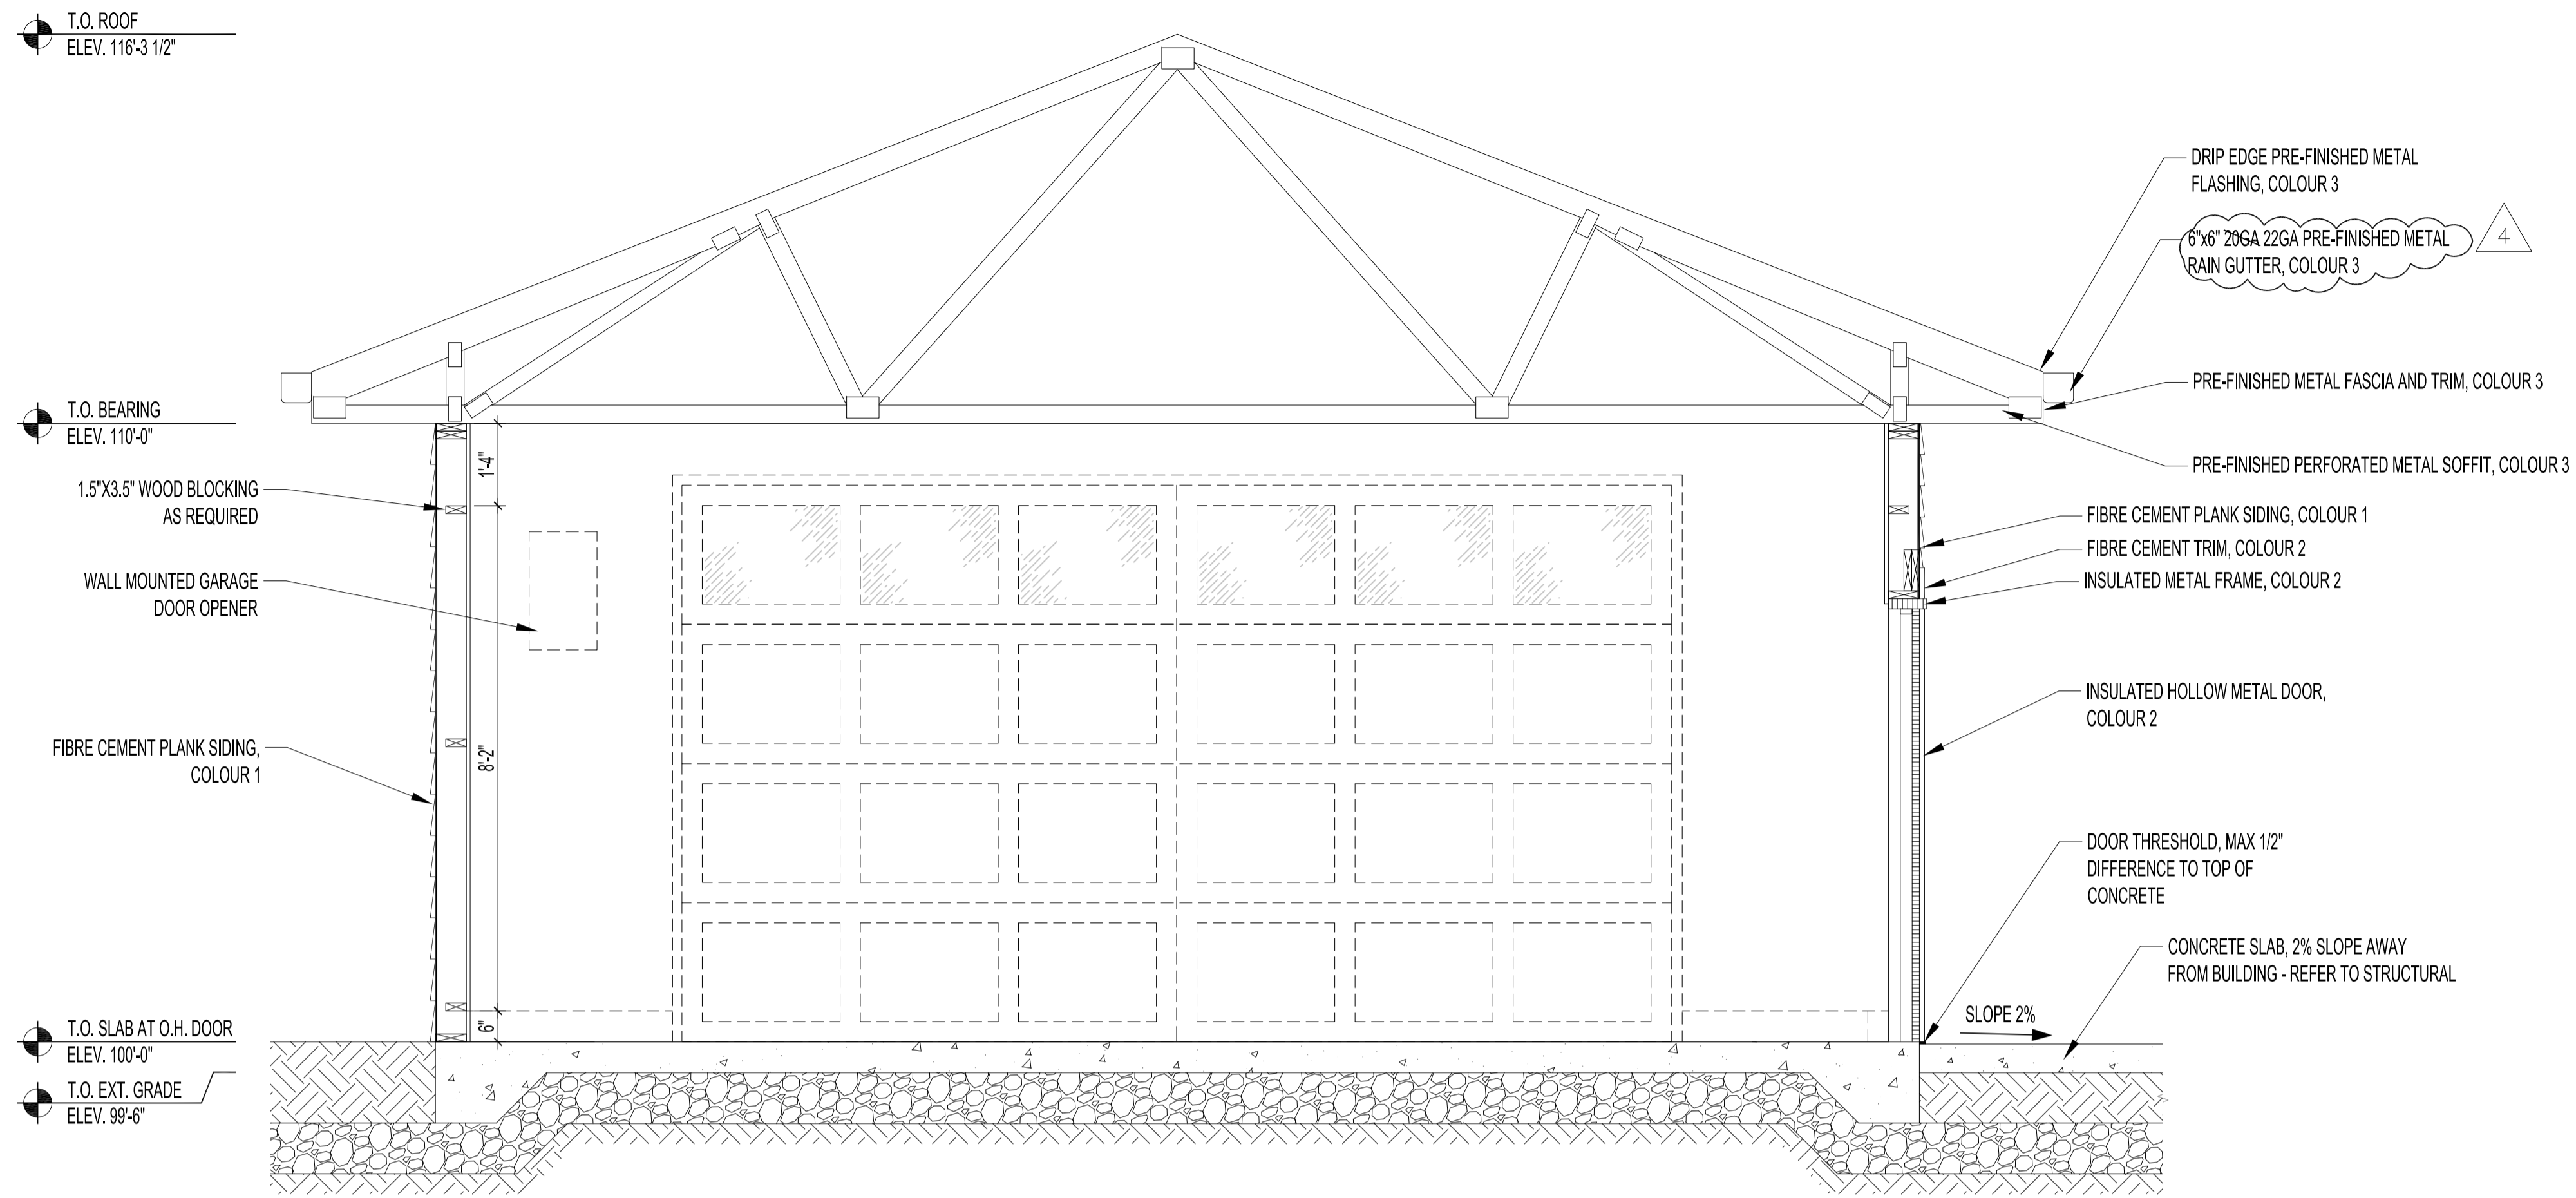

1 BUILDING SECTION SCALE: 1/2"=1'-0"

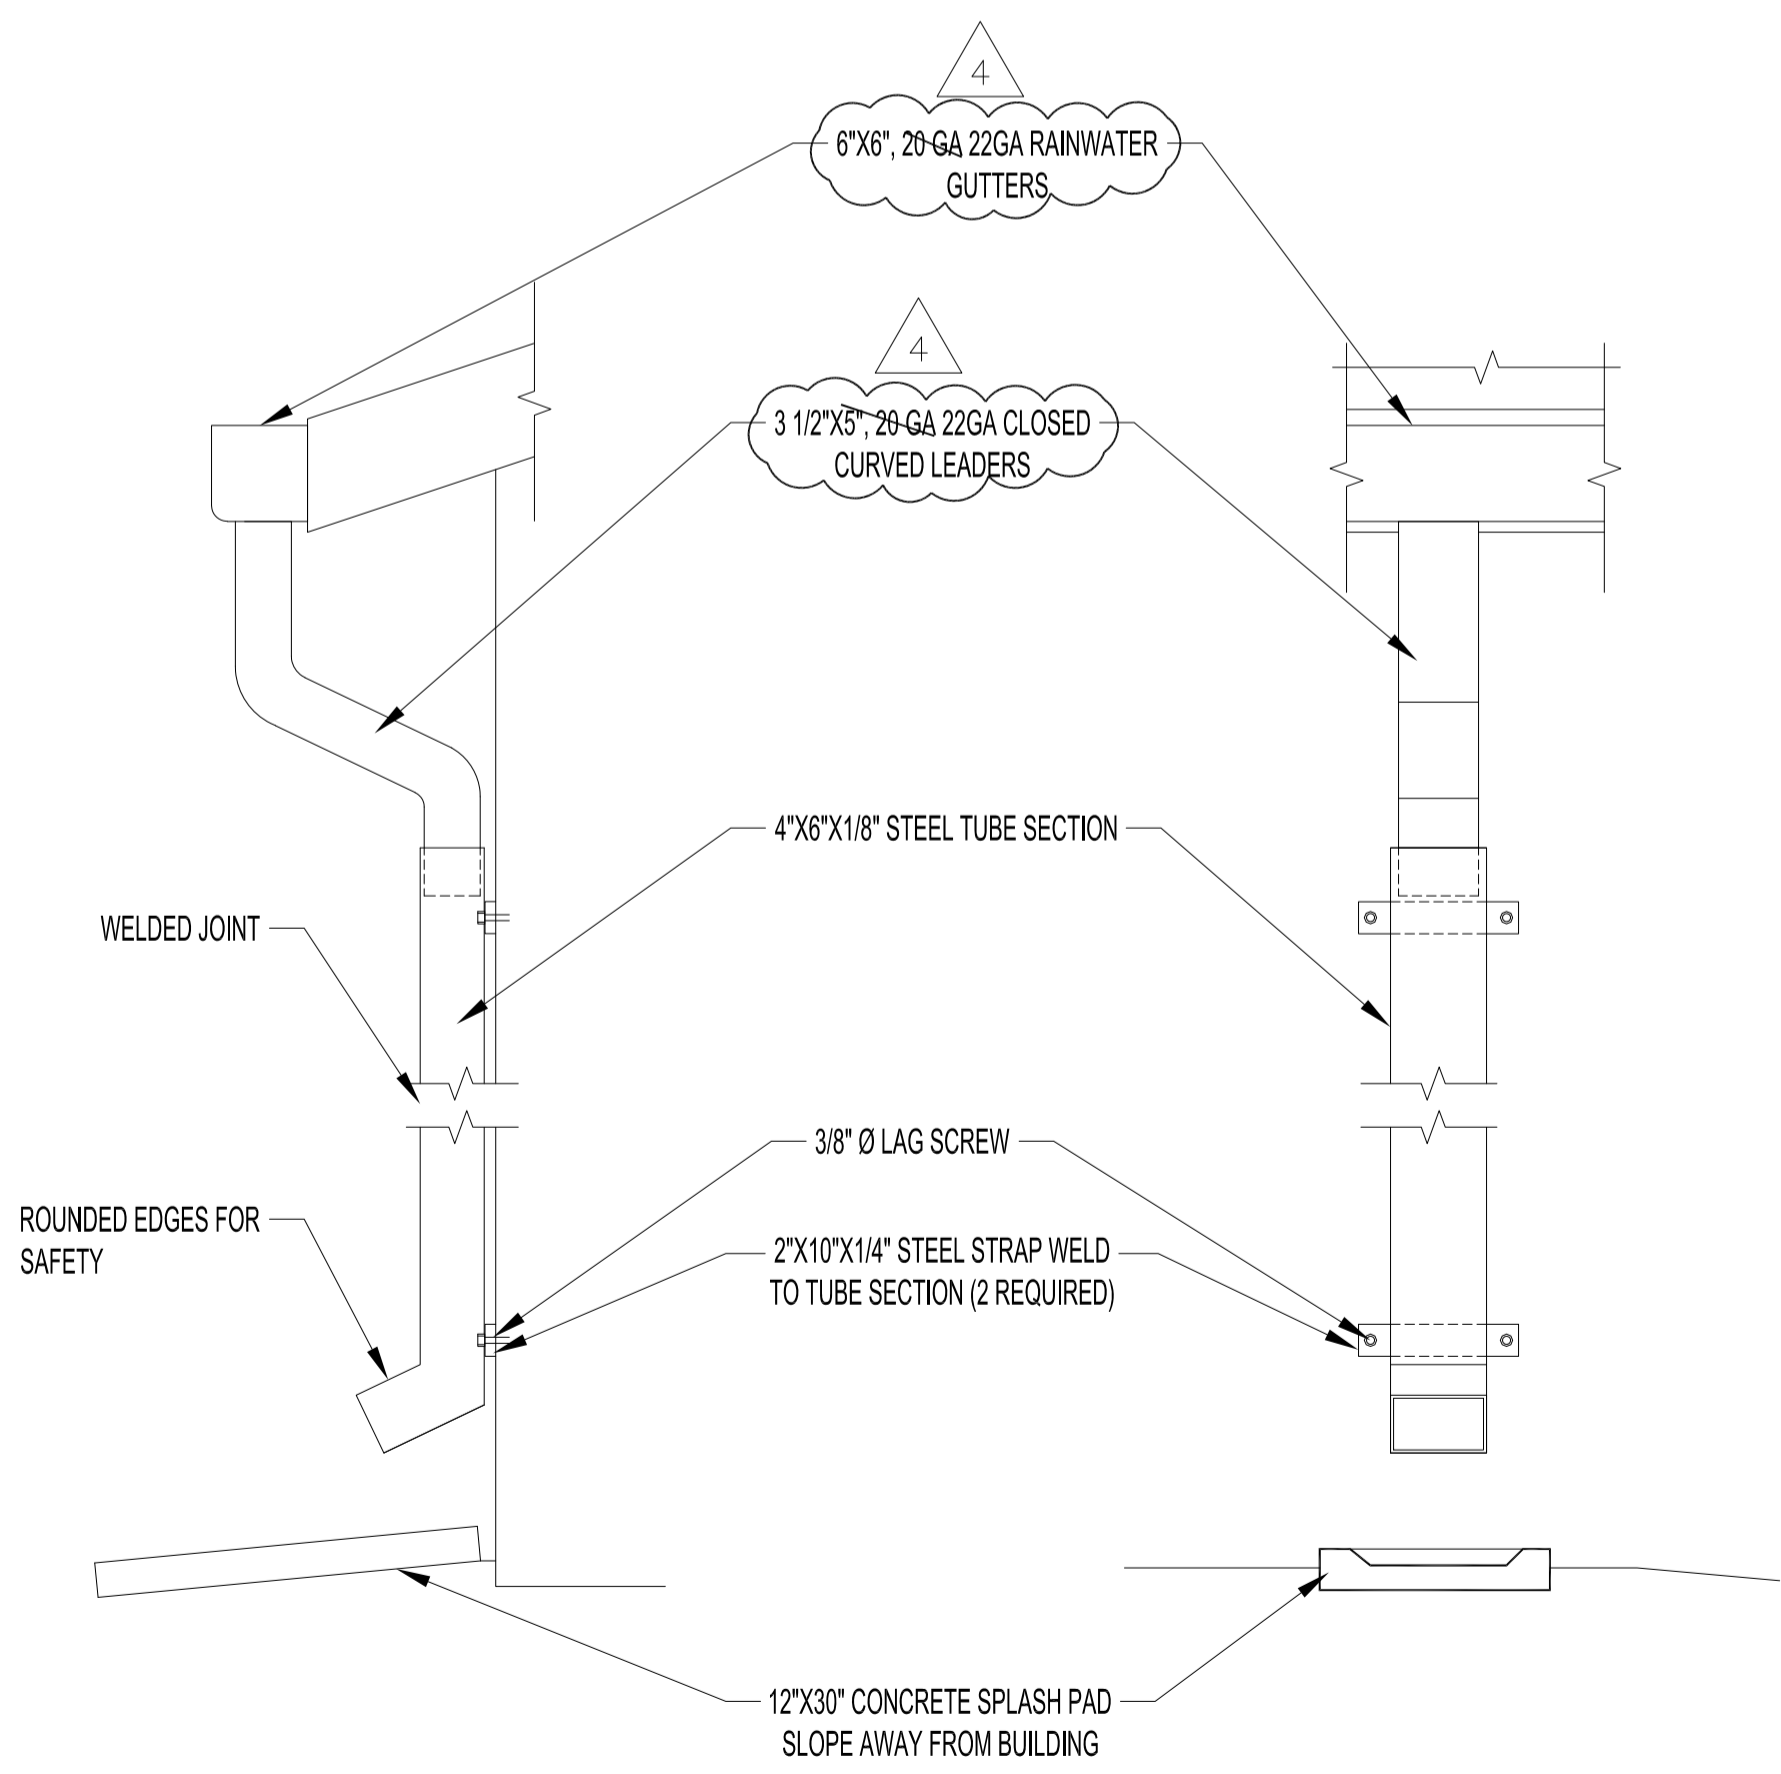

2 DETAIL - RAINWATER GUTTERS AND LEADERS SCALE: 1\"/>

NOTE: GUTTERS & LEADERS TO BE GALVANIZED PRE-FINISHED COLOUR. COLOUR TO BE CHOSEN BY CONTRACT ADMINISTRATOR

1	ISSUED FOR ADDENDUM #4	JKR	DEC 01, 2021
0	ISSUED FOR CONSTRUCTION	JKR	SEP 15, 2021
No.	REVISION/DESCRIPTION	BY	DATE

SEAL



DRAWN	JKR	CHECKED	BGP	DESIGNED	BGP	APPROVED	BGP
DATE	2021.09.15	USER APPROVAL					

THE CITY OF WINNIPEG  
 PLANNING, PROPERTY AND  
 DEVELOPMENT DEPARTMENT  
 MUNICIPAL ACCOMMODATIONS DIVISION  
 3-65 GARRY STREET, R3C 4K4

PROJECT  
**PARKS AND OPEN SPACE  
 AMBER TRAILS - STORAGE BUILDING**

10 ALLAN BLYE DRIVE  
 SHEET TITLE

**BUILDING SECTION AND DETAILS**

SCALE	PROJECT No:	SHEET No:
AS SHOWN	2020-126	<b>A2.1-R1</b>