



PLAN

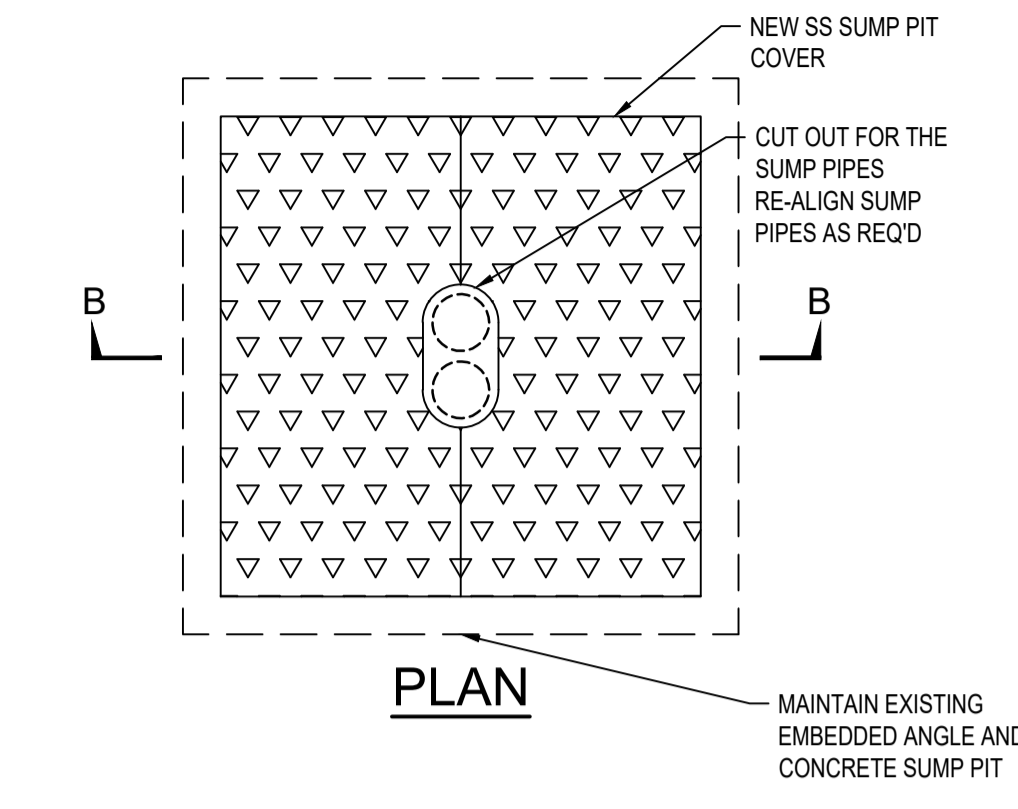


PLAN

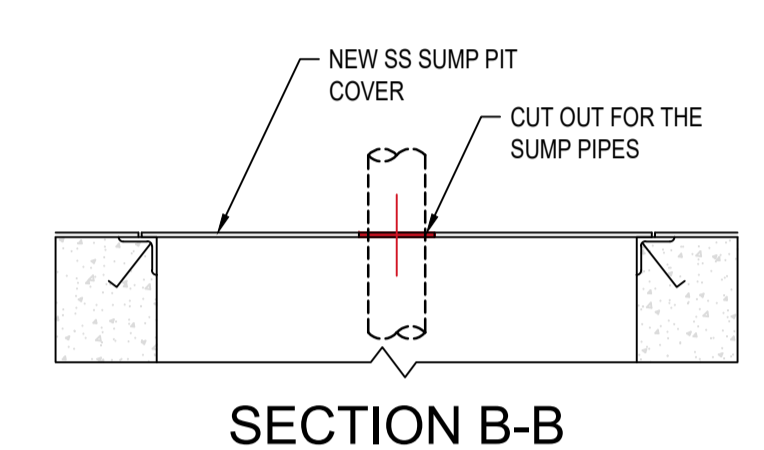

SECTION B-B

2 SUMP COVER PLATE DETAIL
SCALE: 1:10

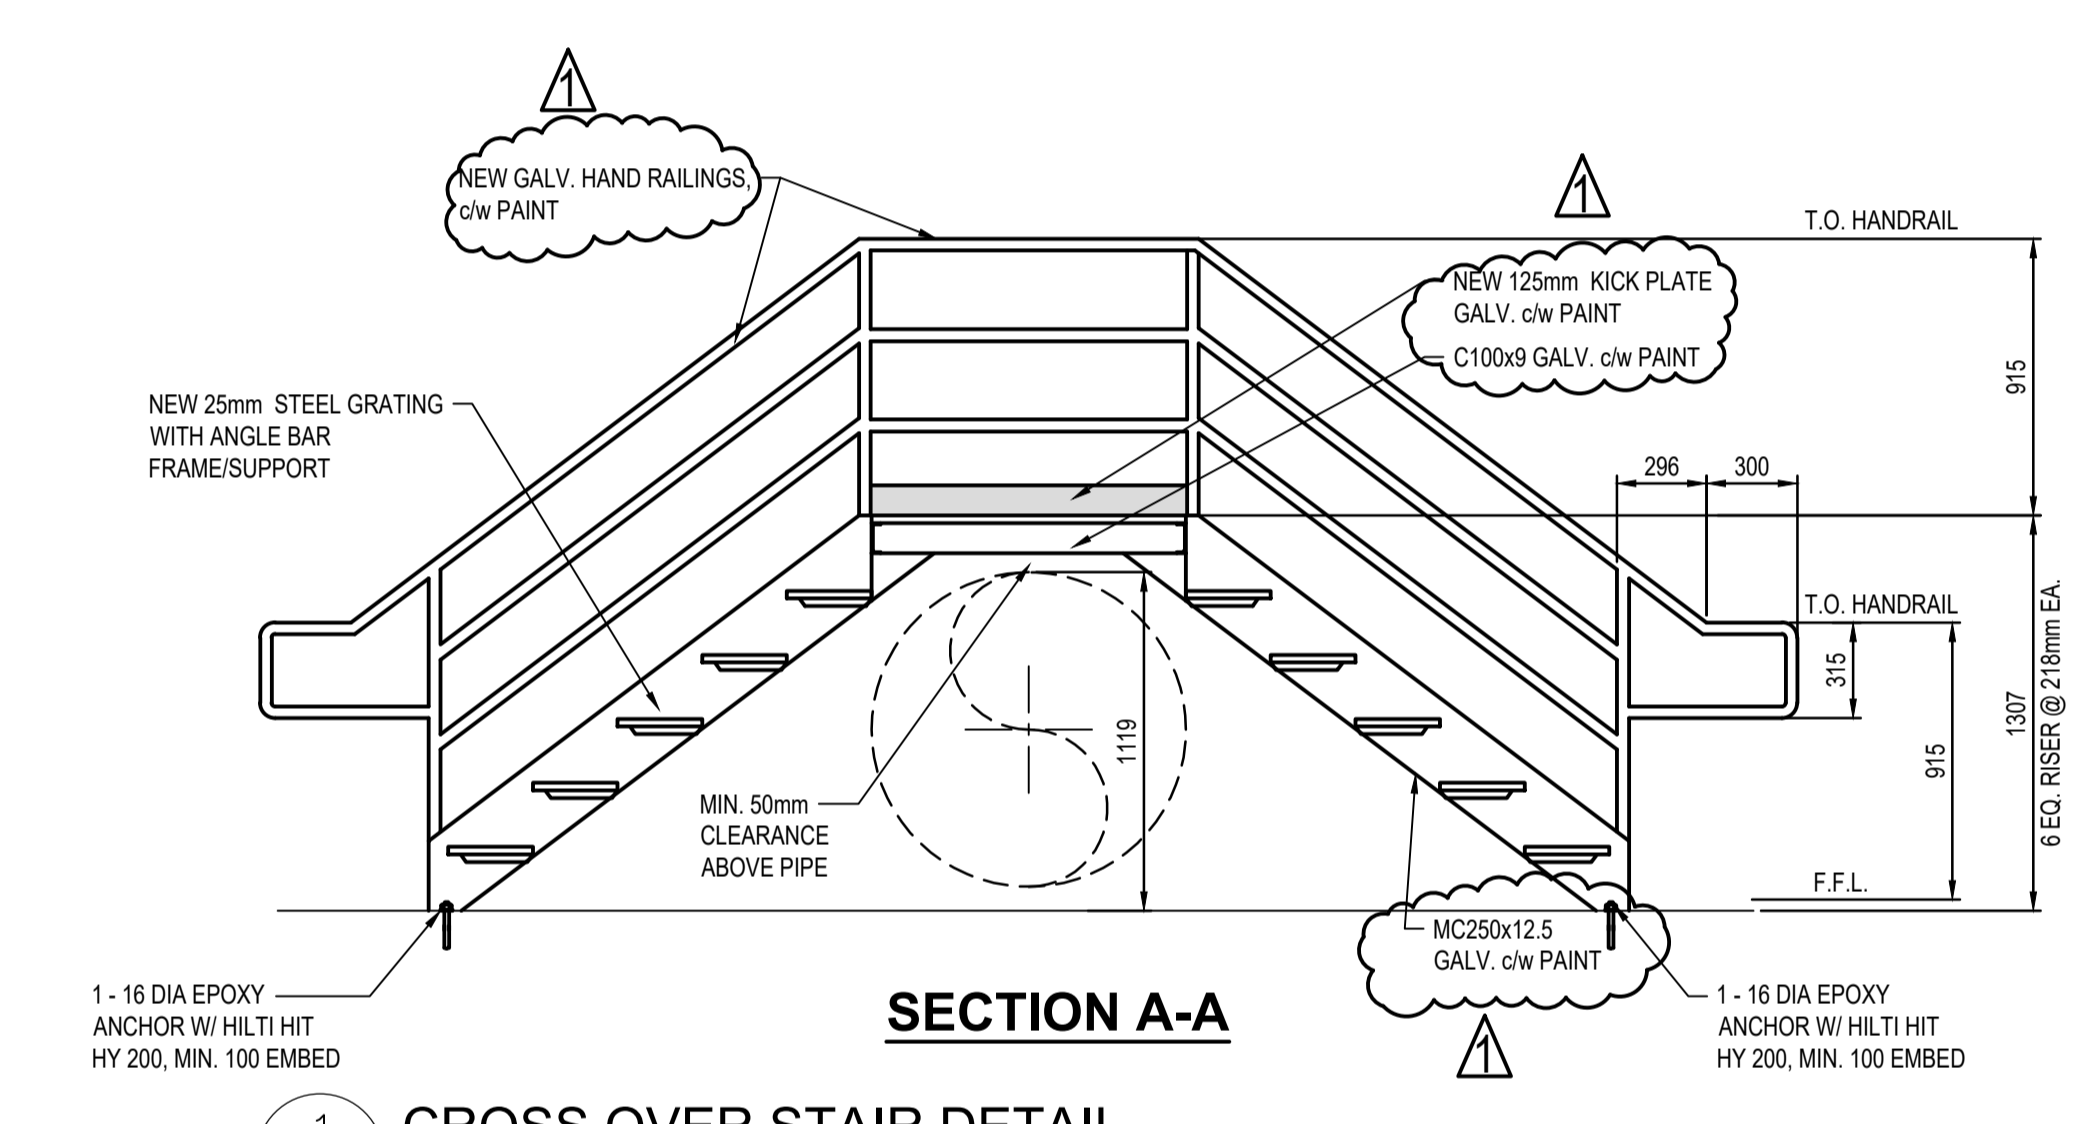

SECTION A-A

1 CROSS OVER STAIR DETAIL
SCALE: 1:25



NO.	REVISIONS	DATE	DESIGN	CHECK
1	ISSUED FOR ADDENDUM 4	2022-11-14	KS	MH
0	ISSUED FOR CONSTRUCTION	2022-10-11	KS	MH

AECOM	
DESIGNED BY: K. SIDDALL	CHECKED BY: M. HOQUE
DRAWN BY: G. PROFETA	APPROVED BY:
SCALE:	RELEASED FOR CONSTRUCTION BY:
DATE: 2022-11-14	DATE:
CONSULTANT NO.: 60661011	

THE CITY OF WINNIPEG
WATER AND WASTE DEPARTMENT

TACHE BOOSTER PUMPING STATION
AND SURGE TOWER UPGRADES
ARCHITECTURAL
TACHE BOOSTER PUMPING STATION REMEDIATION
MISCELLANEOUS DETAILS

CITY DRAWING NUMBER 1-0660R-B0001-001	SHEET 7 of 13	REV. 1	SIZE A1
---	-------------------------	------------------	-------------------

LAST SAVE: 2022/11/10 12:47 PM
 PATH: L:\Logos\CA\WPS\F1001\Drawings\111906\CAD_GIS\10-CAD\20-SHEETS\Architectural\CAD_Line_15/22/2022\0007.dwg