



NORTH ARROW

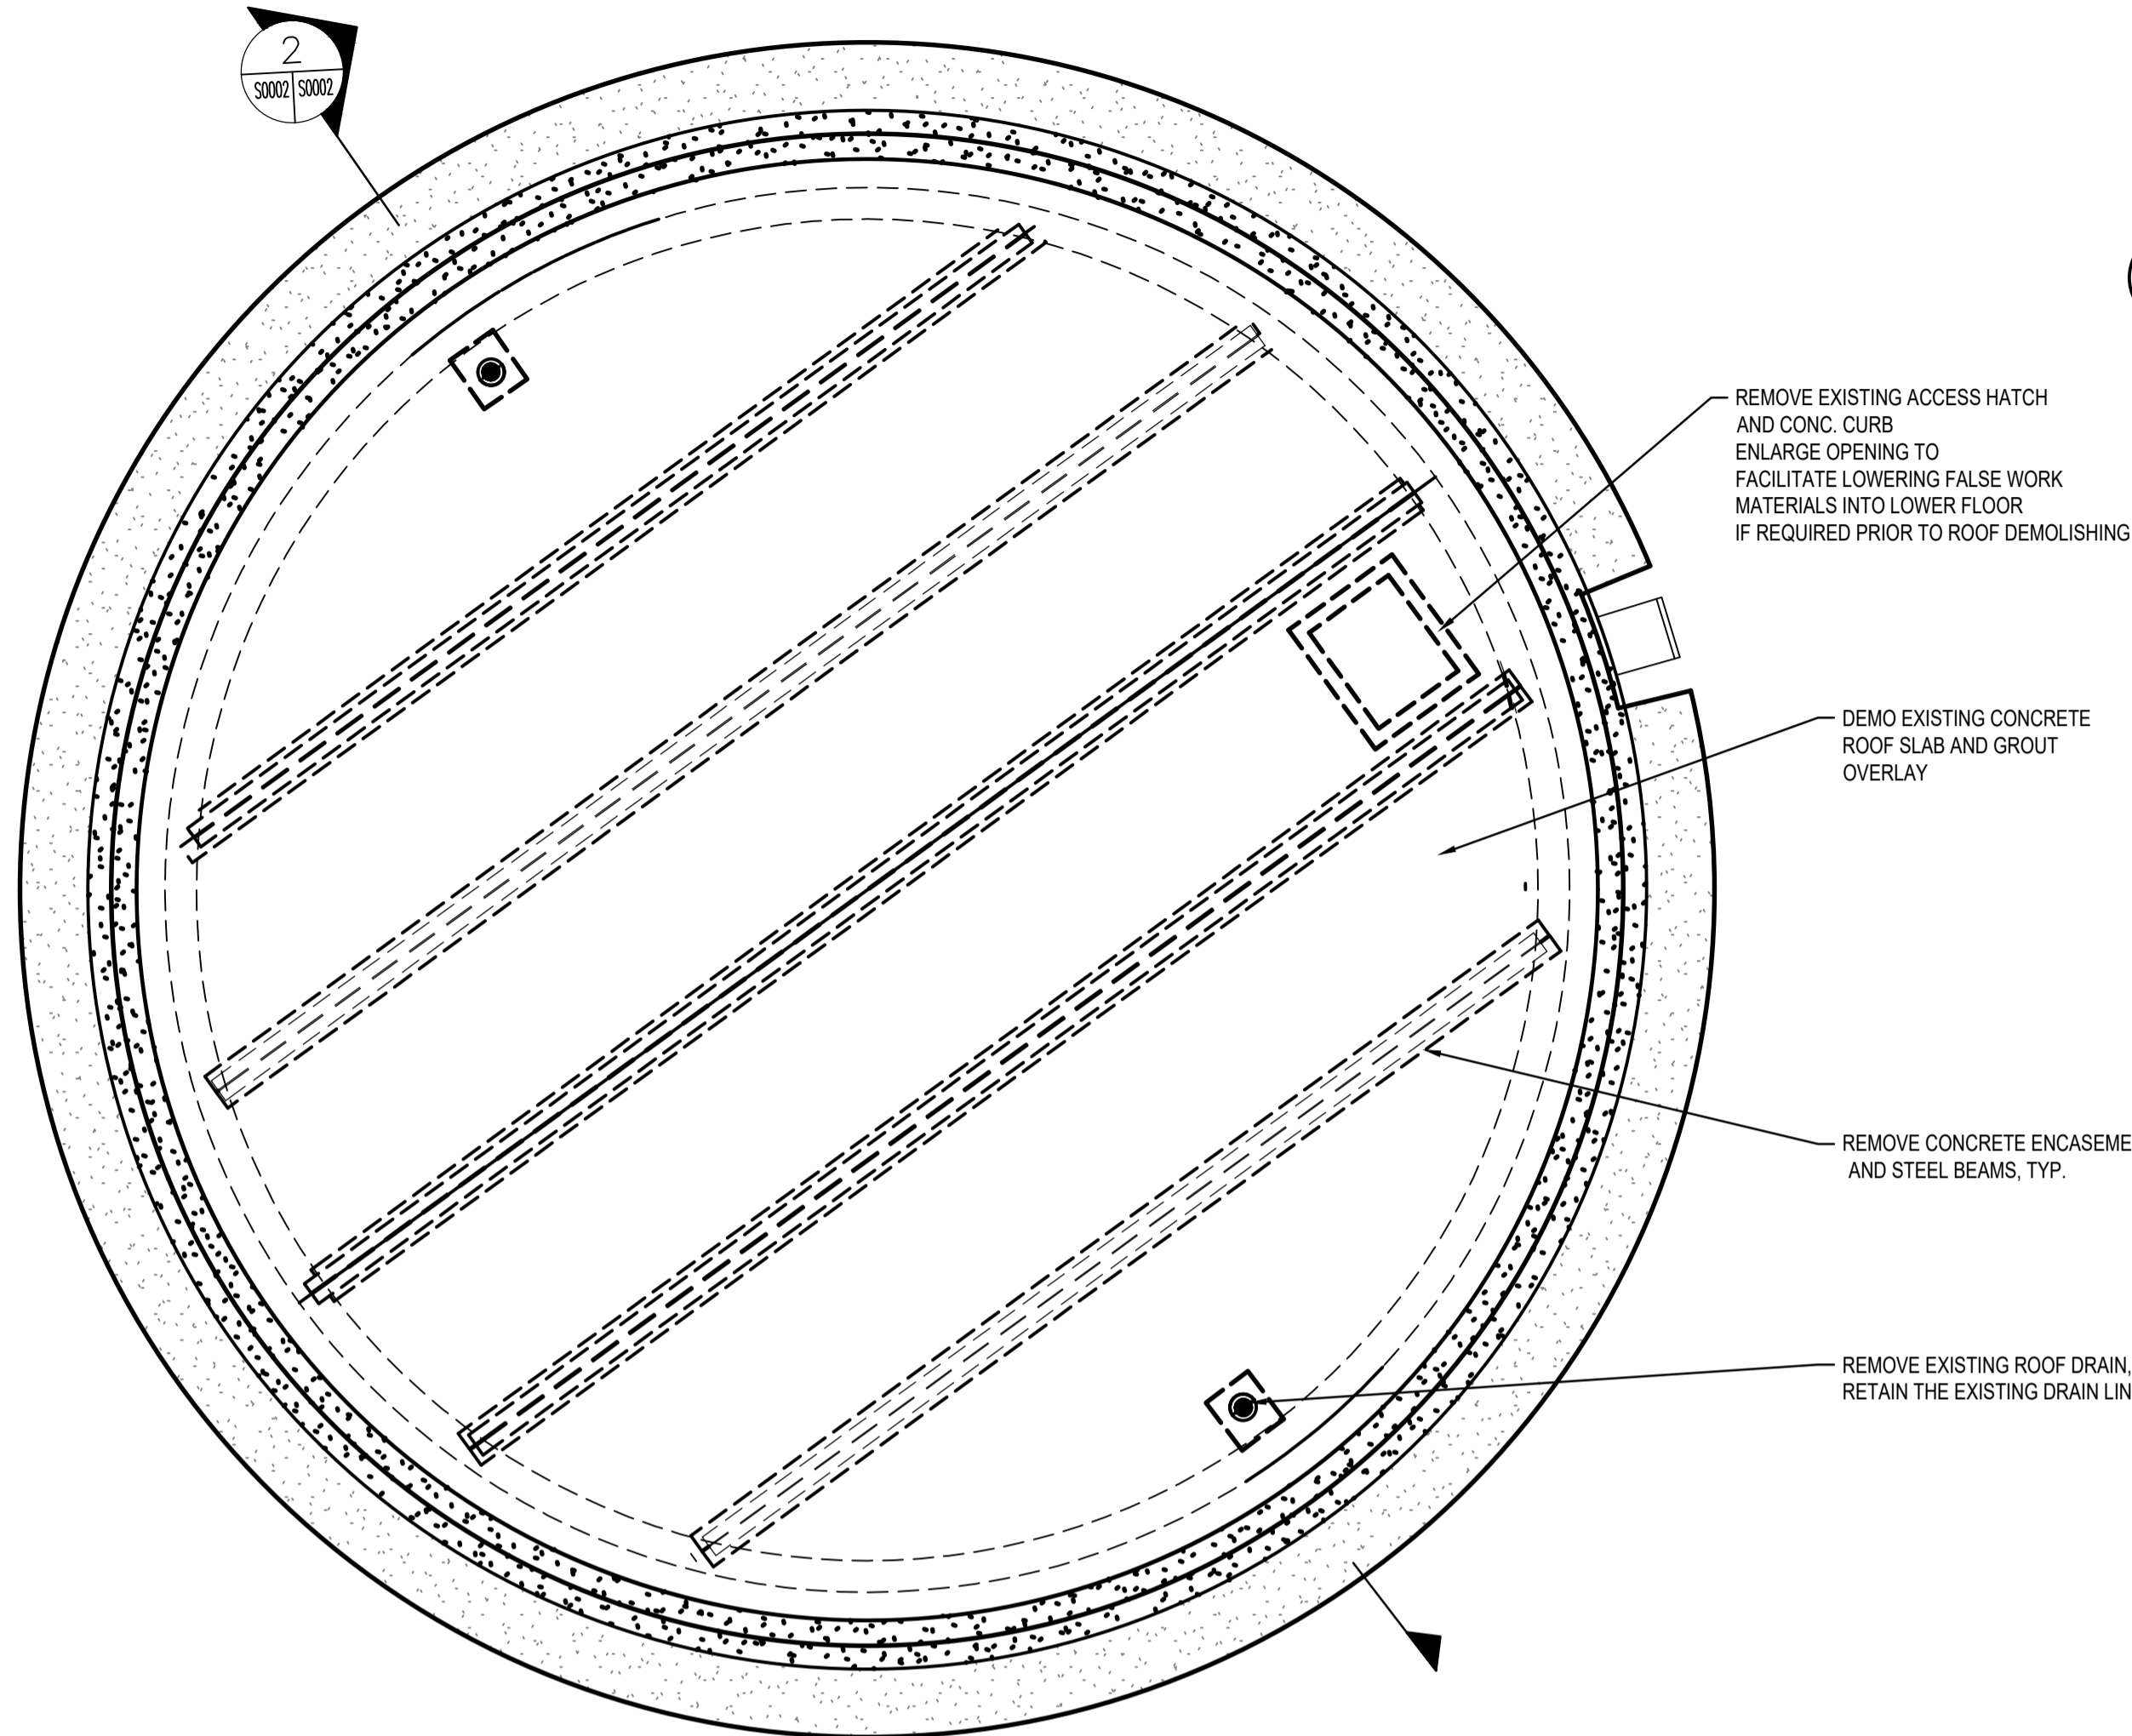


1 SURGE TOWER ROOF - DEMOLITION  
SCALE: 1:50

DEMOLITION NOTES

- DO ALL WORK TO LOCAL AND GOVERNMENT CODES.
- THIS FACILITY WILL BE IN FULL OPERATION DURING CONSTRUCTION. EXTREME CAUTION TO BE TAKEN TO PROTECT THE WELL FROM CONTAMINATION.
- TEMPORARY ENGINEERING SUPPORT STRUCTURE AND A DUST HOARDING (REFER TO DWG 1-0660R-S0002-001) IS TO BE INSTALLED PRIOR TO COMMENCEMENT OF ANY WORK.
- CONTRACTOR WILL BE FULLY RESPONSIBLE TO ENSURE THAT NO LARGE DEBRIS WILL BE ALLOWED TO DAMAGE THE HOARDING.
- IT IS RECOMMENDED (BUT NOT DIRECTED) THAT THE EXISTING CONCRETE ROOF SLAB BE SAW CUT AND LIFTED OUT. CONTRACTOR TO SUBMIT ENGINEERING DEMOLITION PLAN DRAWING SHOWING THE SAW CUT LOCATION AND SLAB REMOVAL SEQUENCE. ALL ALTERNATIVE METHODS SHALL BE SUBMITTED TO THE CONTRACT ADMINISTRATOR FOR REVIEW AND APPROVAL.
- THE EXISTING CONCRETE ENCASED STEEL BEAMS ARE TO BE FREED AT BOTH ENDS AND LIFTED OUT INTACT.
- CONTRACTOR TO SUBMIT DEMOLITION PROCEDURE DRAWINGS SIGNED AND SEALED BY AN ENGINEER REGISTERED IN MANITOBA FOR REVIEW AND APPROVAL BY THE CONTRACT ADMINISTRATOR.
- ALL RULES AND REGULATION "WORKING OVER OPEN WATER" SHALL APPLY.

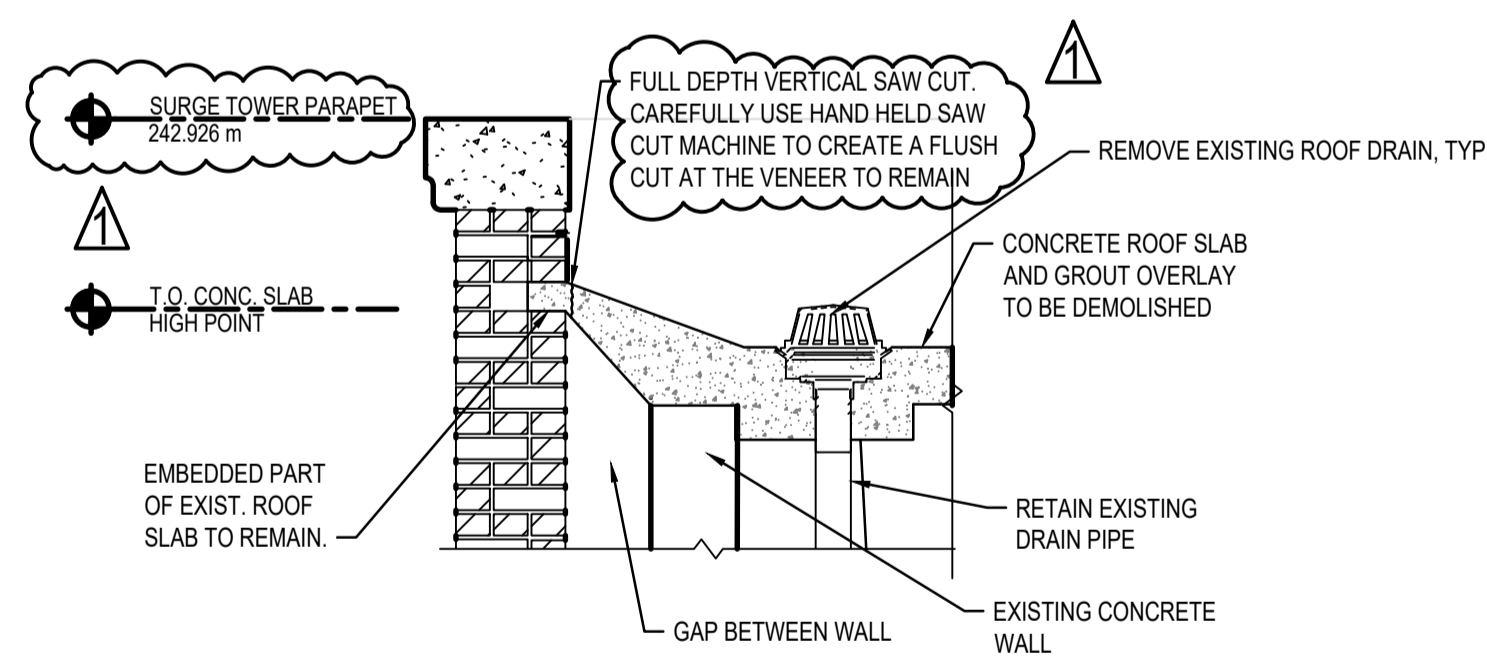


3 SECTION DETAIL  
SCALE: 1:20

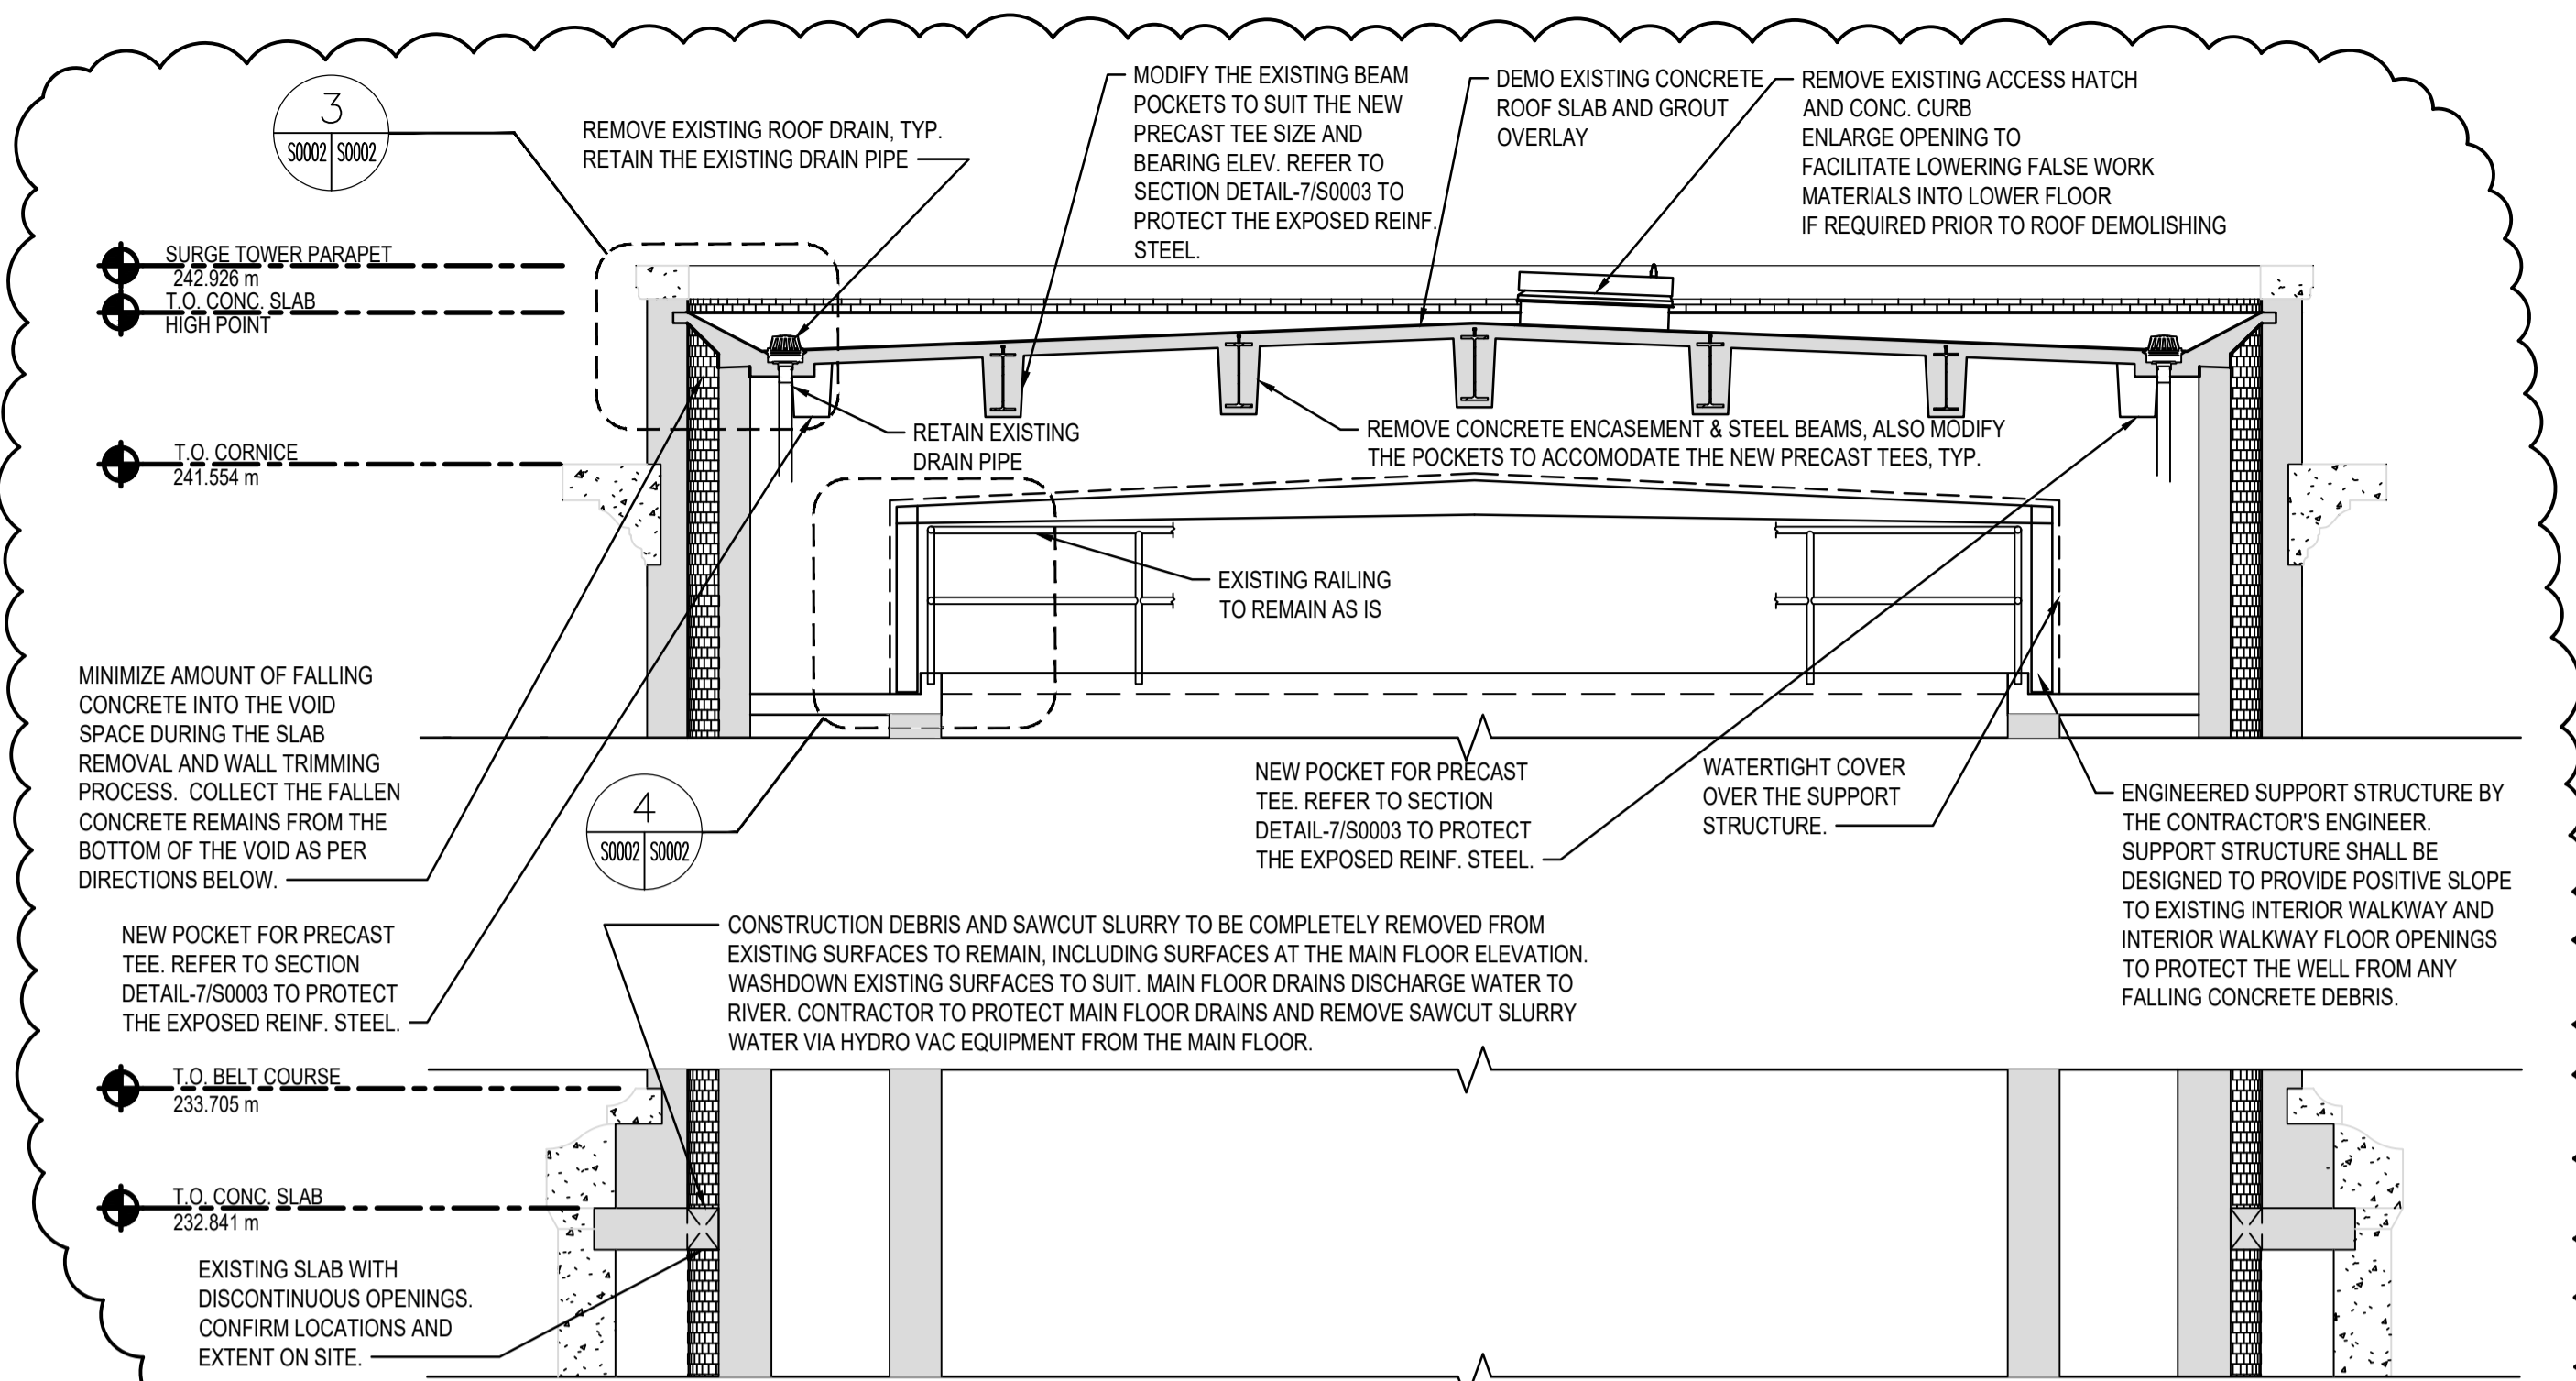

2 BUILDING SECTION  
SCALE: 1:50

NOTE:  
1. TOWER SCAFFOLDING FROM GRADE UTILIZED FOR REPOINTING ACTIVITIES OR CONSTRUCTION ROOF ACCESS SHALL NOT BE SECURED TO THE TOWER'S SURFACES. REPOINTING ACTIVITIES AND CONSTRUCTION ROOF ACCESS VIA MOBILE EQUIPMENT SHALL TAKE INTO ACCOUNT THE CRITICAL PIPELINES AND WATER INFRASTRUCTURE FOR THIS PROJECT.

ENGINEERED SUPPORT STRUCTURE BY CONTRACTOR'S ENGINEER. SUPPORT STRUCTURE SHALL BE DESIGNED TO PROVIDE POSITIVE SLOPE TO TARP AND TO PROTECT ANY CONCRETE DEBRIS FALLING INTO THE WELL.

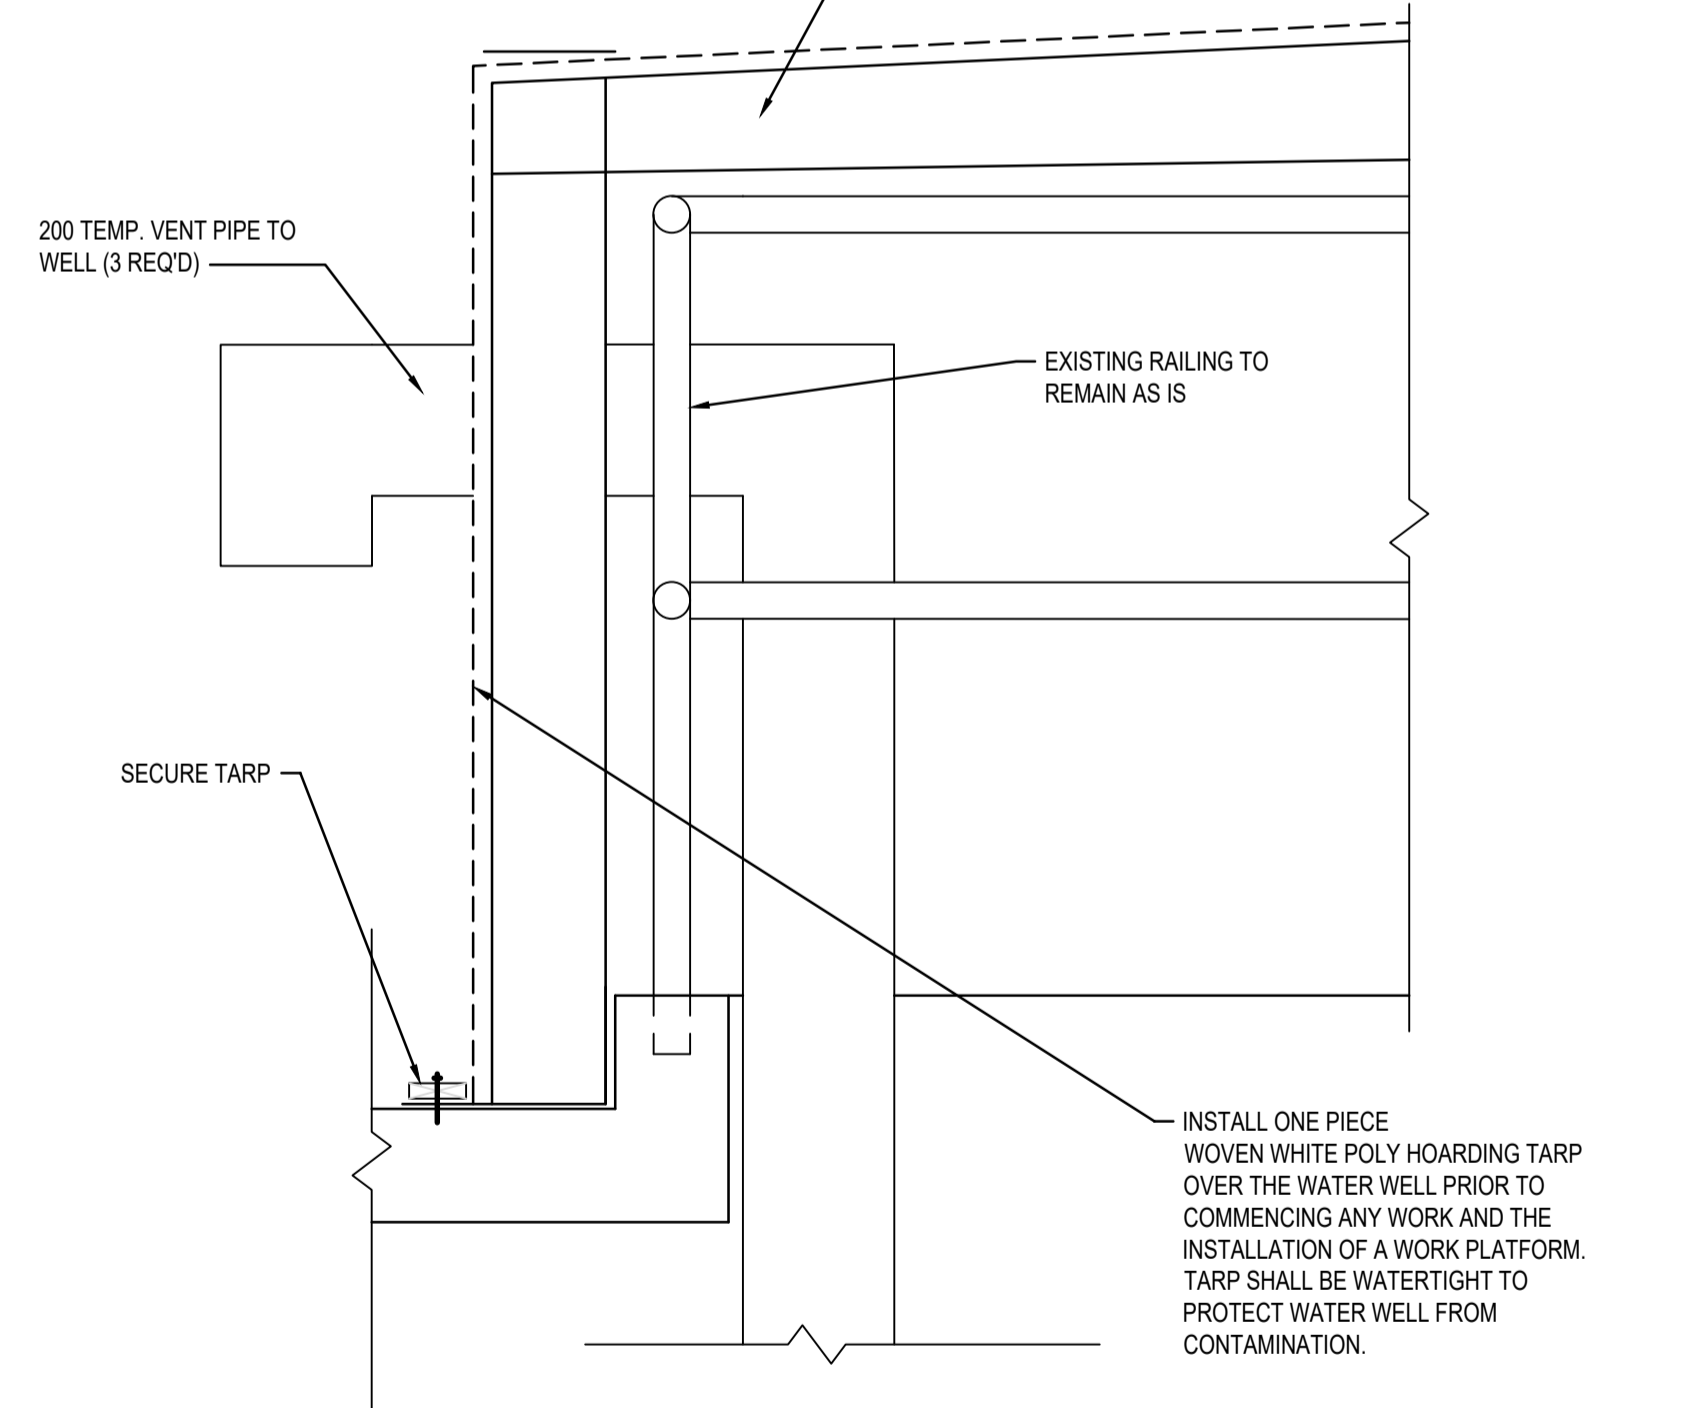

4 SECTION DETAIL  
SCALE: 1:10

				ENGINEER'S SEAL		<p>THE CITY OF WINNIPEG WATER AND WASTE DEPARTMENT</p>	
				DESIGNED BY: G. PROFETA			
DRAWN BY: J. SANGREO		APPROVED BY:		RELEASED FOR CONSTRUCTION		<p>TACHE BOOSTER PUMPING STATION AND SURGE TOWER UPGRADES STRUCTURAL TACHE SURGE TOWER ROOF RECONSTRUCTION ROOF DEMOLITION</p>	
SCALE:		DATE: 2022-11-14		BY:			
1 ISSUED FOR ADDENDUM 4		2022-11-14		GPP MH		CITY DRAWING NUMBER	
0 ISSUED FOR CONSTRUCTION		2022-10-11		GPP MH		SHEET	
NO. REVISIONS		DATE		DESIGN CHECK		REV.	
						1	
						SIZE	
						A1	
				CONSULTANT NO.: 60661011		1-0660R-S0002-001	