


GENERAL NOTES:

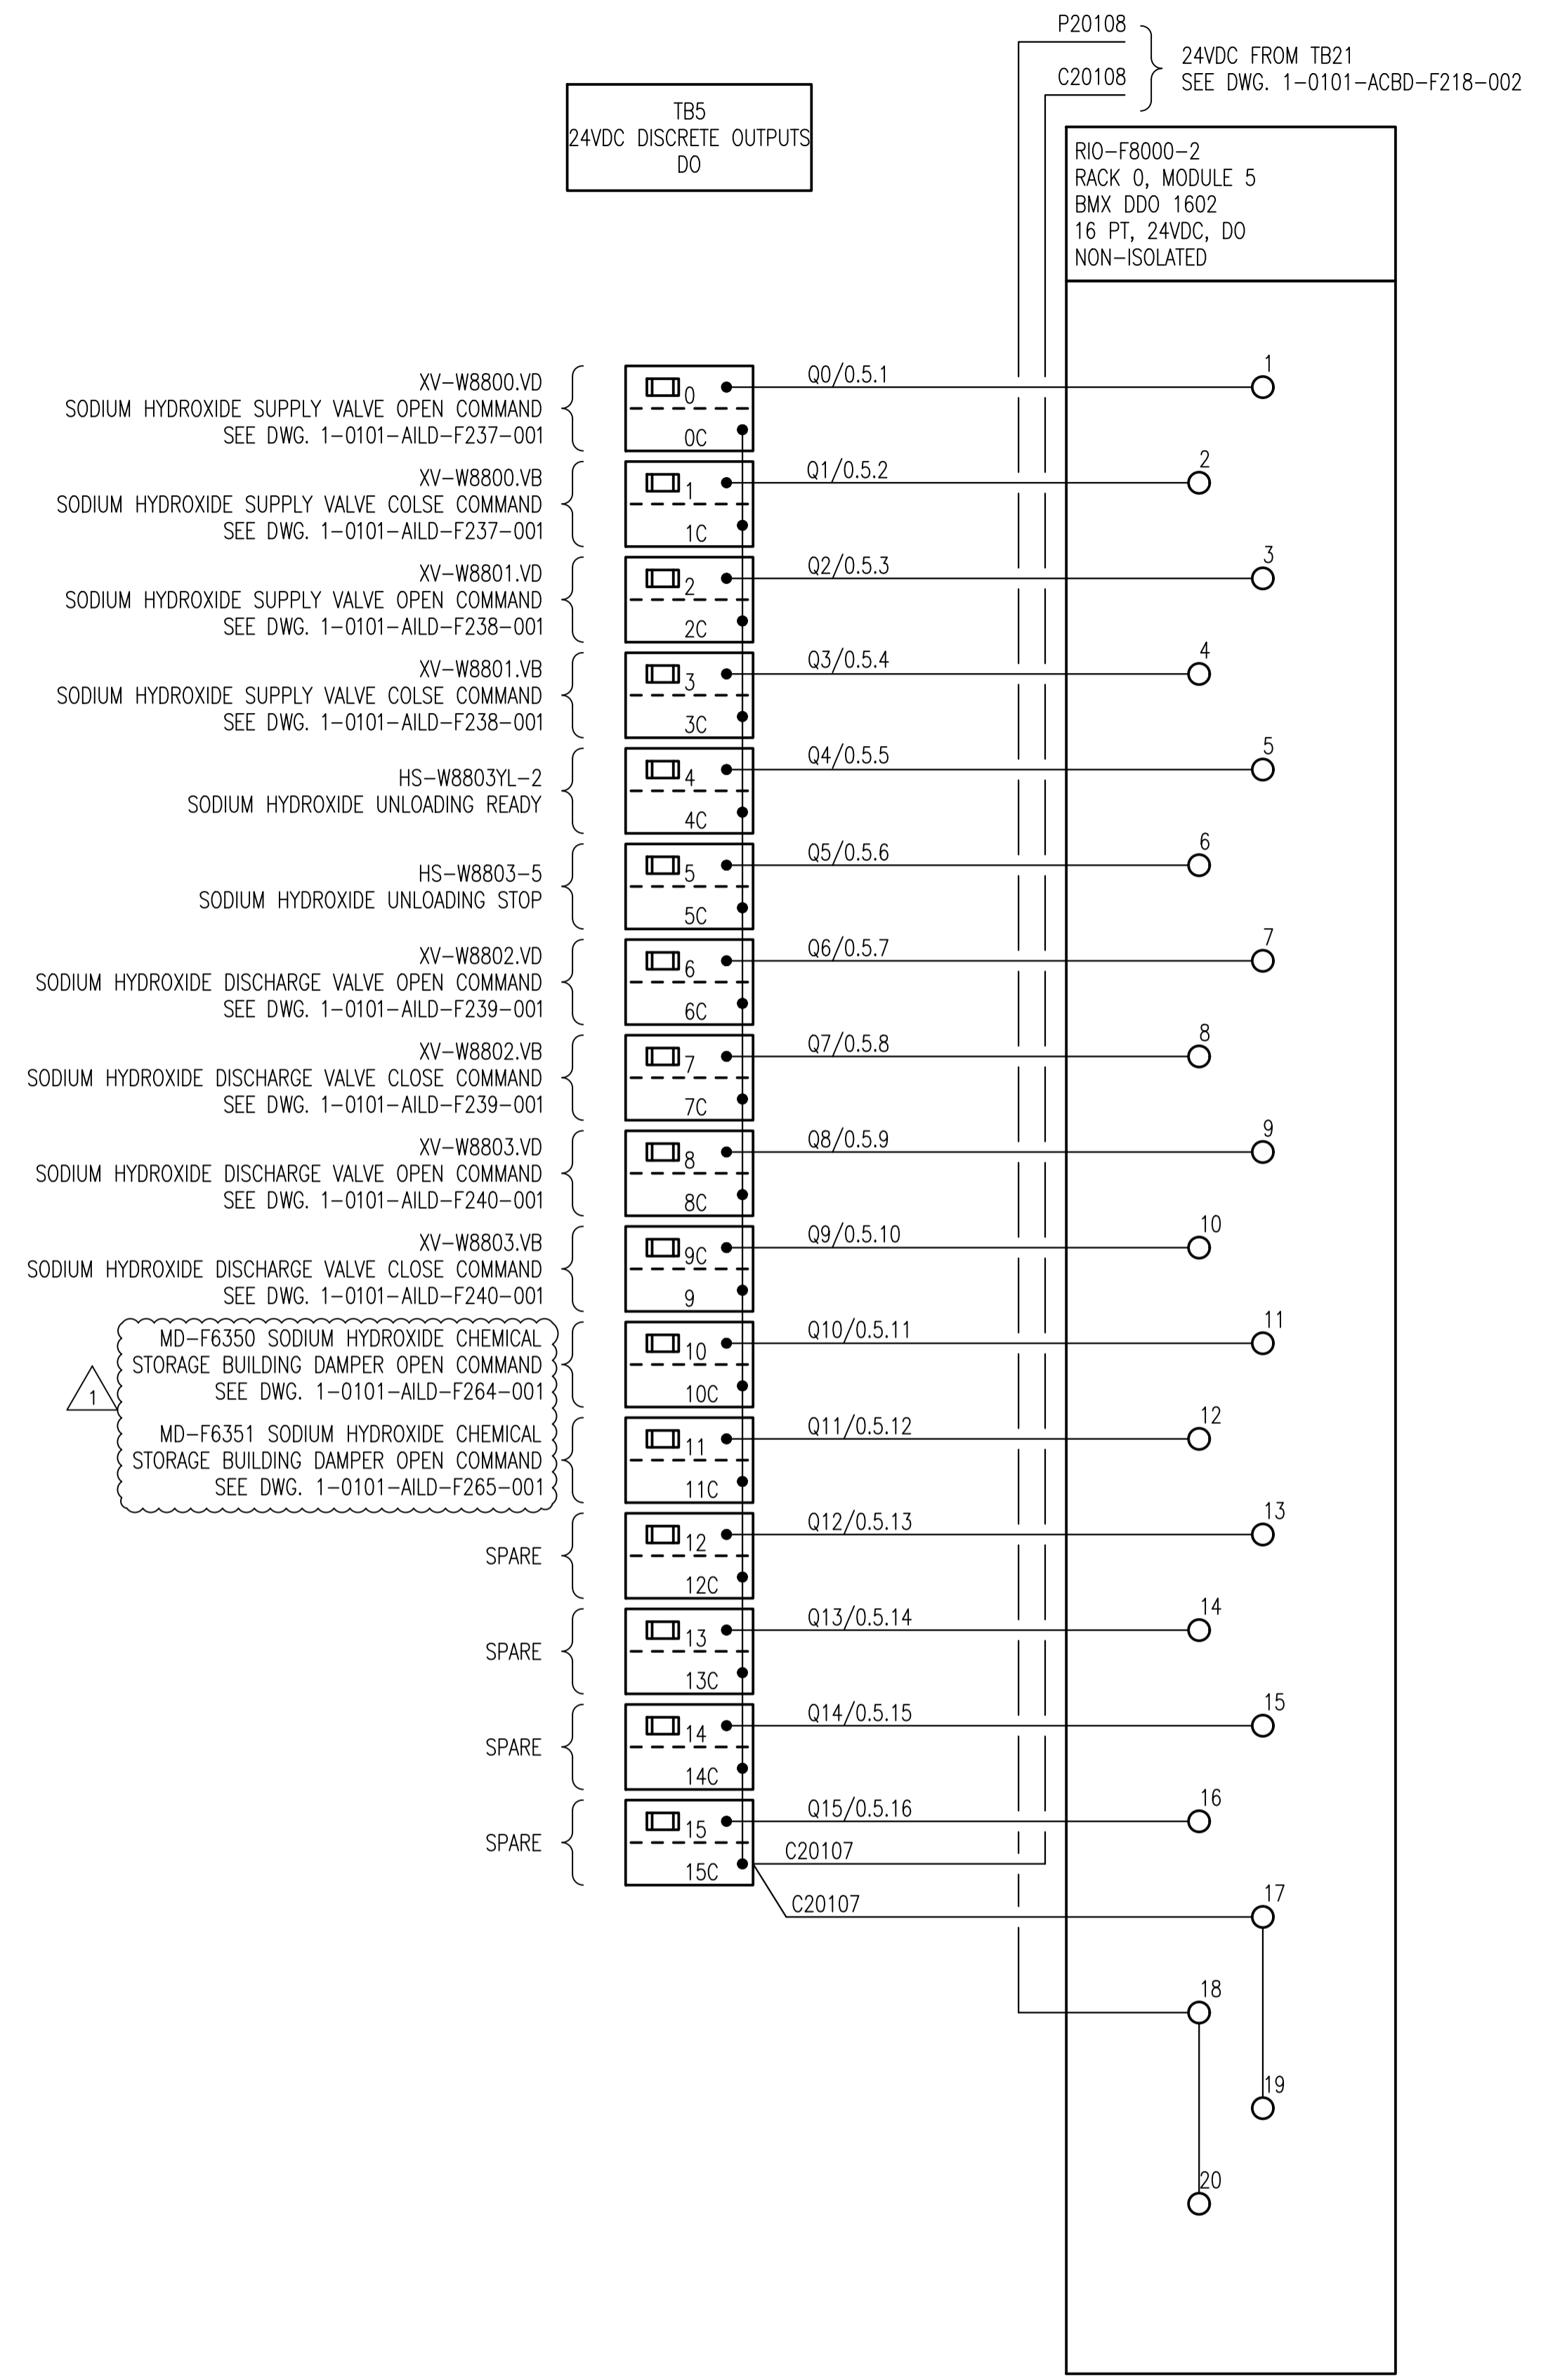

FUSE SCHEDULE			
TB	IDENTIFIER	SIZE	RATED CURRENT (A) FA
TB5	0	5x20mm	0.50
	1	5x20mm	0.50
	2	5x20mm	0.50
	3	5x20mm	0.50
	4	5x20mm	0.50
	5	5x20mm	0.50
	6	5x20mm	0.50
	7	5x20mm	0.50
	8	5x20mm	0.50
	9	5x20mm	0.50
	10	5x20mm	0.50
	11	5x20mm	0.50
	12	5x20mm	0.50
	13	5x20mm	0.50
	14	5x20mm	0.50
	15	5x20mm	0.50

MD-F6350 SODIUM HYDROXIDE CHEMICAL STORAGE BUILDING DAMPER OPEN COMMAND SEE DWG. 1-0101-AILD-F264-001

MD-F6351 SODIUM HYDROXIDE CHEMICAL STORAGE BUILDING DAMPER OPEN COMMAND SEE DWG. 1-0101-AILD-F265-001

10	-	-
9	-	-
8	-	-
7	-	-
6	-	-
5	-	-
4	-	-
3	-	-
2	-	-
1	-	-
NO.	DRAWING NUMBER	REFERENCE DRAWING TITLE
REFERENCE DRAWINGS		



B.M. ELEV.			
CONSTRUCTION COMPLETION DATE: YYYY MM DD			
NO.	REVISIONS	DATE	BY
1	RE-ISSUED FOR CONSTRUCTION	2022 07 05	JAB
0	ISSUED FOR CONSTRUCTION	2022 05 18	JAB

DESIGNED BY DG		CHECKED BY JAB	
		APPROVED BY JAB	
DRAWN BY RG		RELEASED FOR CONSTRUCTION	
SCALE: NTS		DATE	
DATE 2022 04 04		DATE	

ENGINEER'S SEAL
CONSULTANT DRAWING NUMBER
21-0107-015_A5.205

THE CITY OF WINNIPEG
 WATER AND WASTE DEPARTMENT
 ENGINEERING DIVISION
 NORTH END SEWAGE TREATMENT PLANT (NEWPCC)
 INTERIM PHOSPHOROUS REMOVAL
 AUTOMATION
 BUILDING 102
RIO-F8000-2 WIRING DIAGRAM - DISCRETE OUTPUT

CITY DRAWING NUMBER: 1-0101-ACBD-F220-001

SHEET 6 OF 9