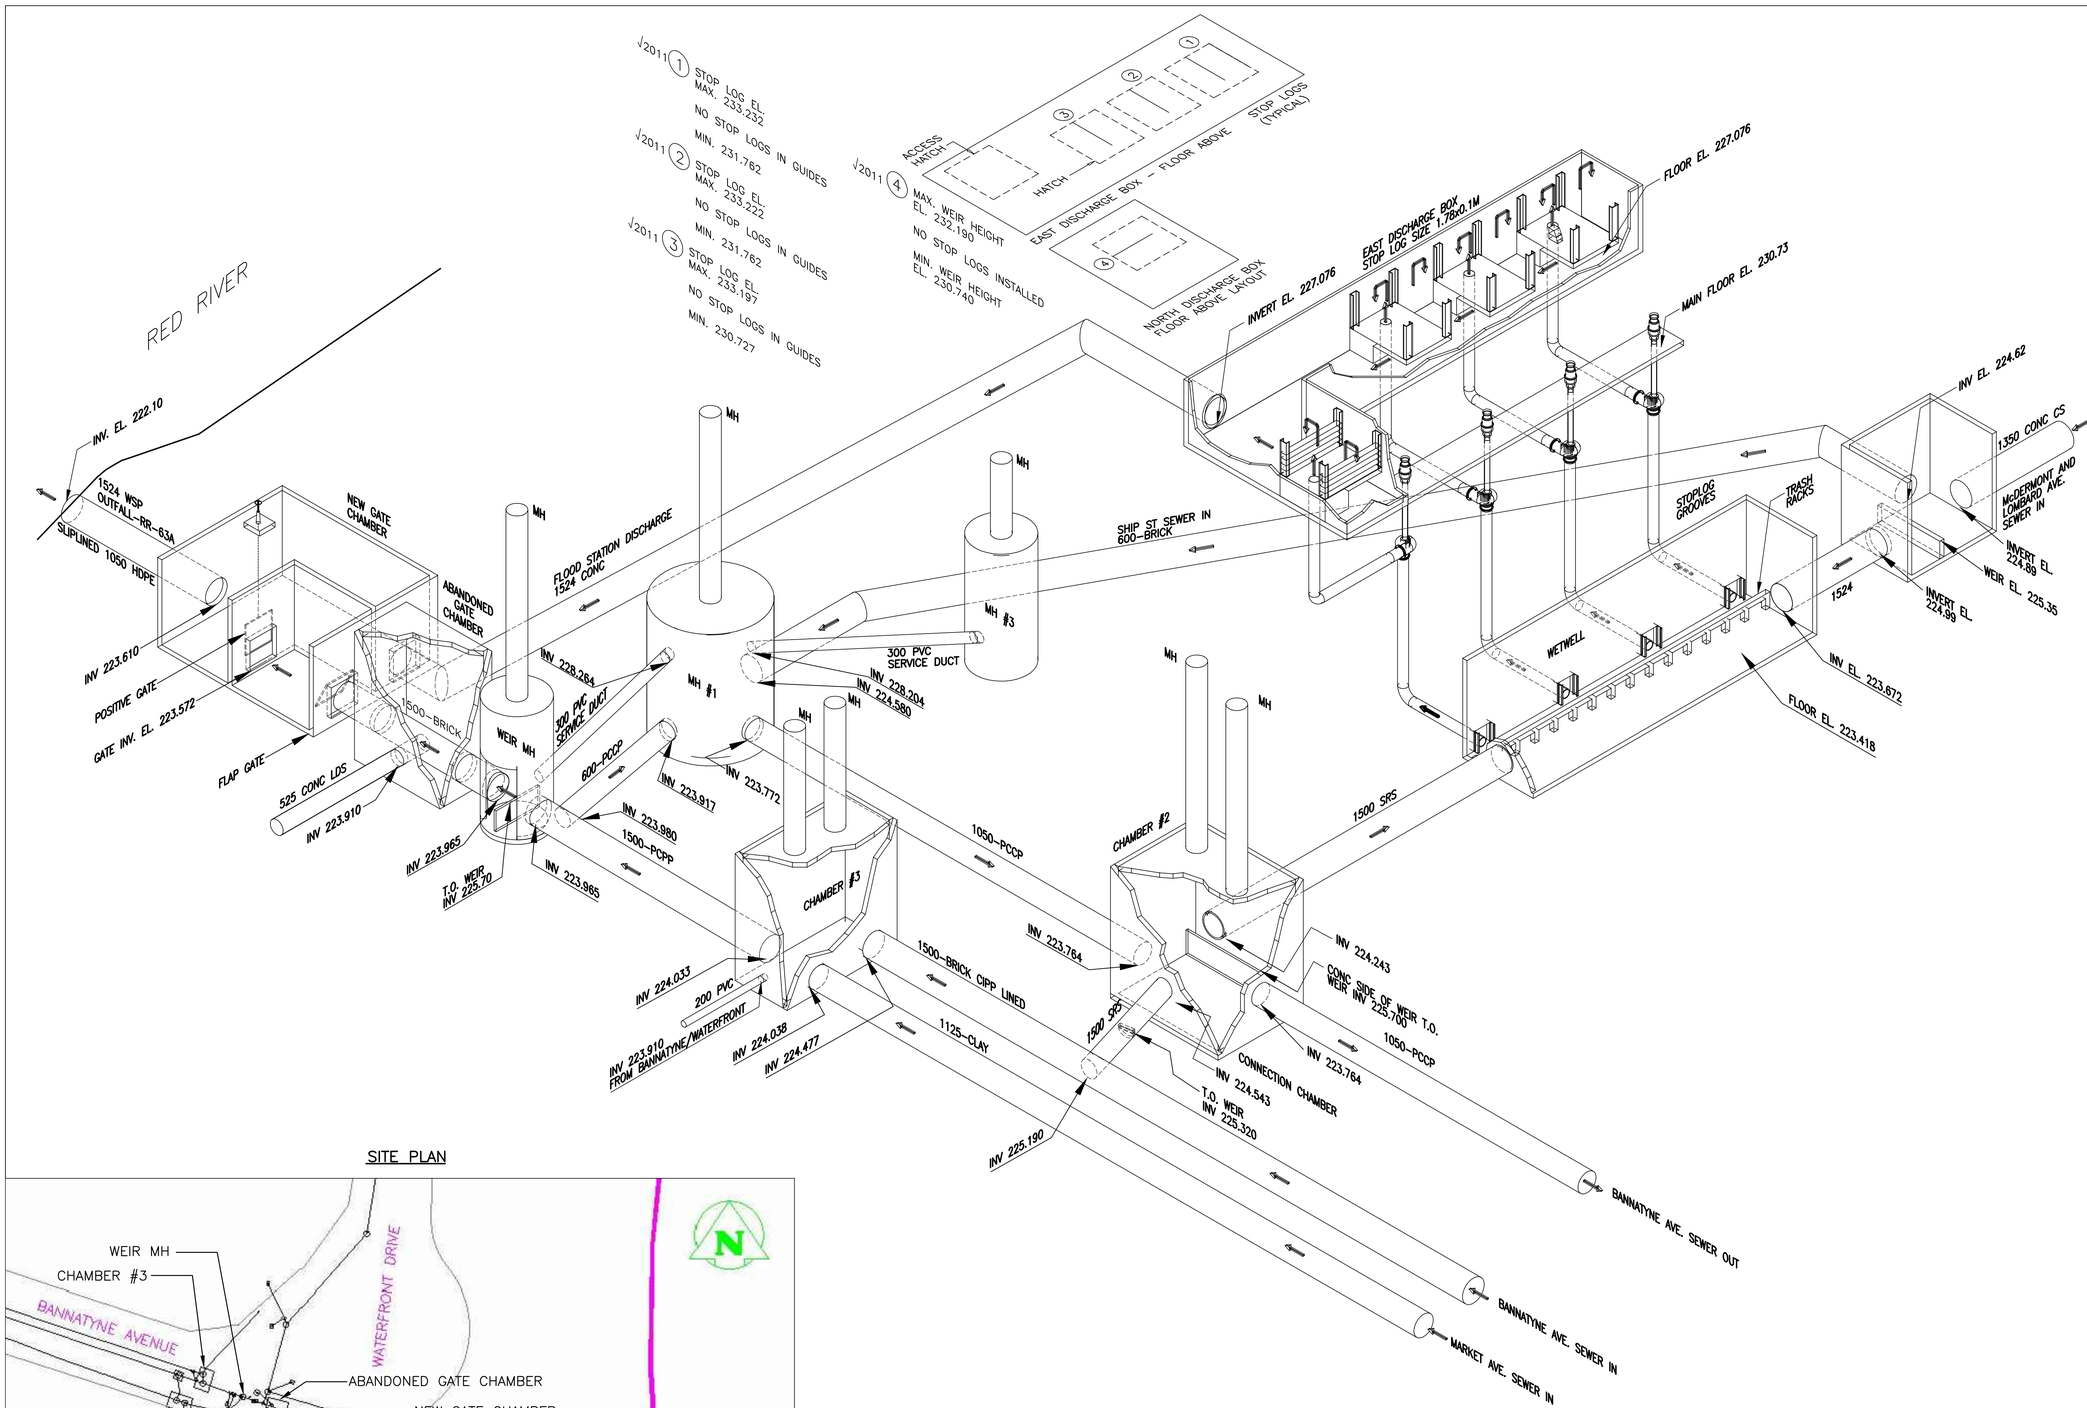

LOCATION

- AREA NORTH
- SECTOR 12
- ADDRESS

KEY ELEVATIONS

- JAMES ST. 25.8 FT. = 7.864m
- LOW BASEMENT 228.3
- MAXIMUM ACTIVATION
- ACTUAL ACTIVATION
  - JAMES . . . . . 15 Ft
  - SITE RIVER 226.33
- PUMP START/STOP 1 . . . . . 226.41/225.64
  2 . . . . . 226.41/225.80
  3 . . . . . 226.56/225.95
  4 . . . . . 226.71/226.10
- HIGH ALARM . . . . . .

NOTES

1. SOURCE OF DATA SHOWN CAN BE TRACED BY REFERRING TO THE BASELINE DATA SPREADSHEETS. FOR SPECIFIC CROSS REFERENCES ON THE DRAWING (IE. 40), REFER TO THE FPS BASELINE DATA SPREADSHEET–SUPERSCRIPT CROSS–REFERENCE SHEET.

PUMP INFORMATION

PUMP REF No.	HP	CAPACITY	
		NO STOPLOGS (CMS)	FULL STOPLOGS (CMS)
5	45	0.33	0.24
6	100	0.76	0.64
7	125	1.12	0.97
8	125	1.12	0.97
TOTAL		3.34	2.83

√2011 – INDICATES FIELD CONFIRMED

SITE PLAN

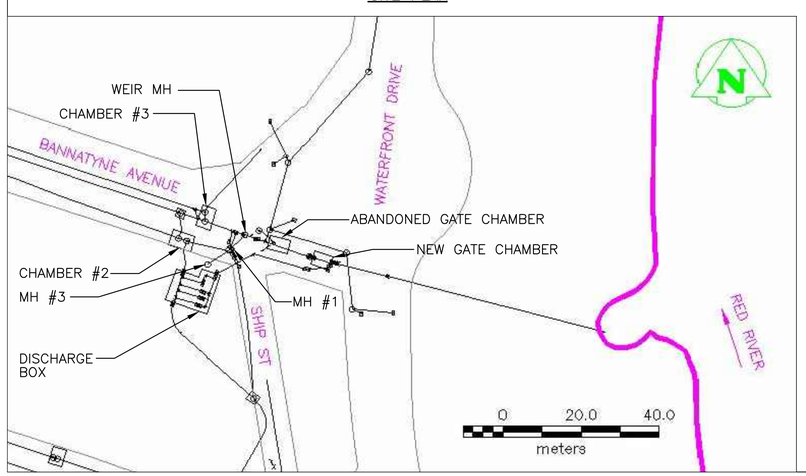

NO.	D / M / Y	DESCRIPTION	BY
4	10/12/20	UPDATED	DW
3	19/05/17	UPDATED	RED
2	30/04/13	UPDATED	RED
1	10/03/05	UPDATED	RED

REVISIONS / ISSUE

Winnipeg THE CITY OF WINNIPEG
WATER AND WASTE DEPARTMENT
AECOM KGS GROUP

FLOOD ACTIVITY / EMERGENCY MANUAL

TITLE:	BANNATYNE FPS ISOMETRIC		
JOB No.	020–08–09–09–00	DATE:	MAR. 19, 2003
SCALE:	N.T.S.	DWG. No.	M006
CHECKED:	HW/DW		