

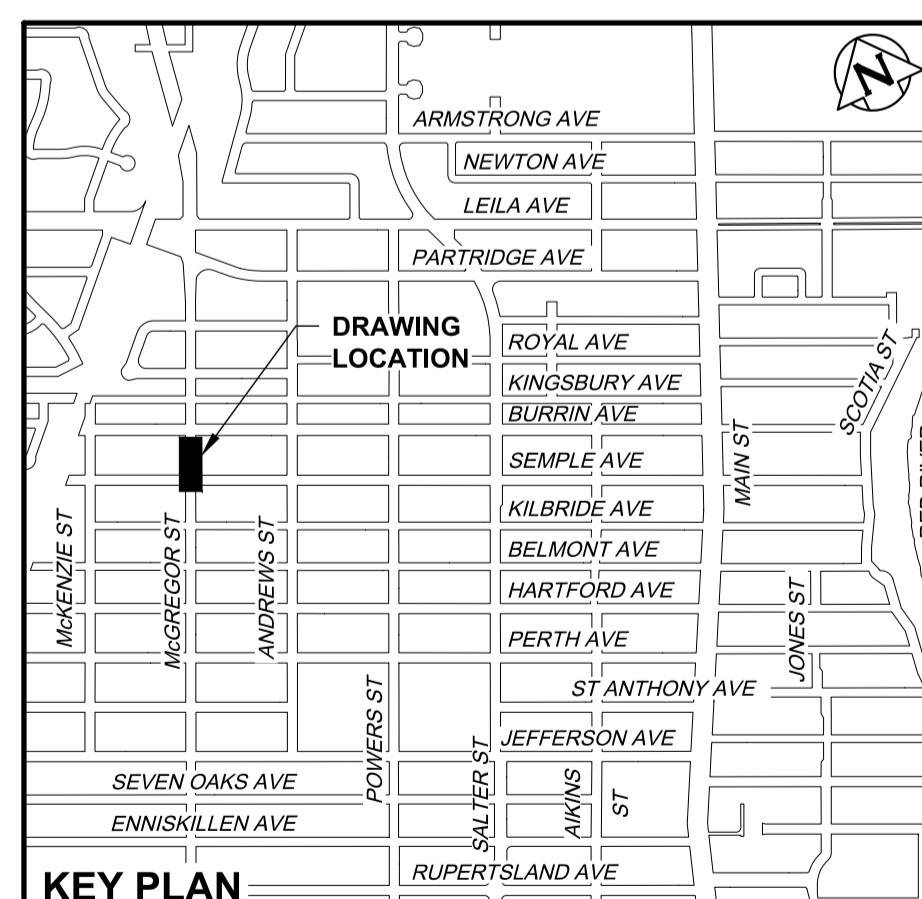


NOTE: CHAINAGES SHOWN ARE ALONG E. P. OF McGREGOR STREET
 STA. 1+000.000 = N P. SEMPLE AVENUE

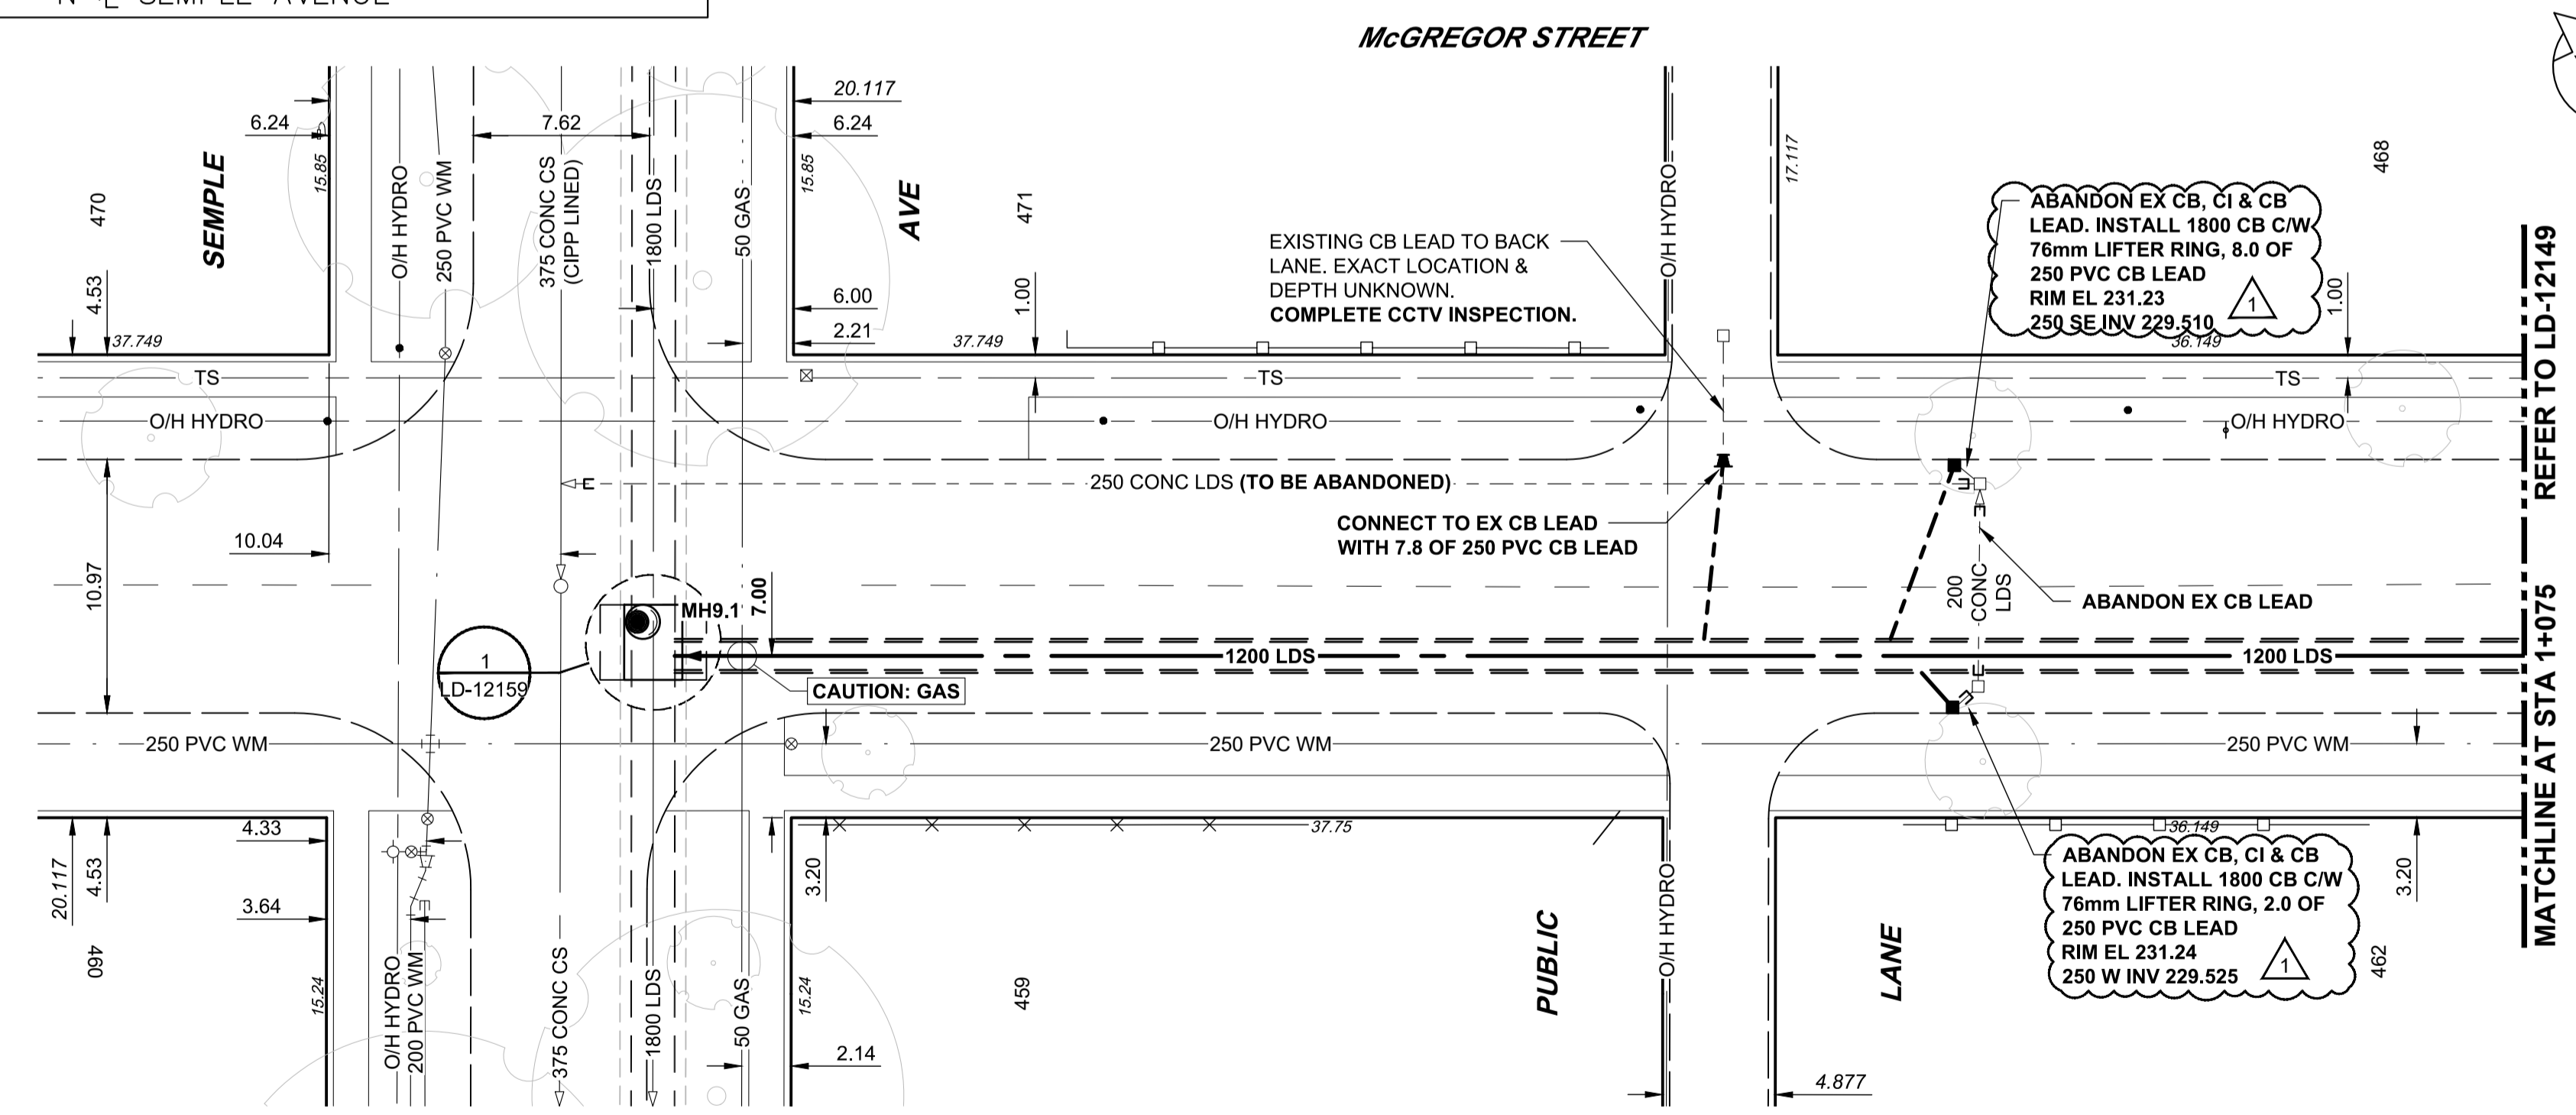

**ENGINEERS
 GEOSCIENTISTS
 MANITOBA**
 Certificate of Authorization
 AECOM Canada Ltd.
 No. 4671 Date: 23/09/20

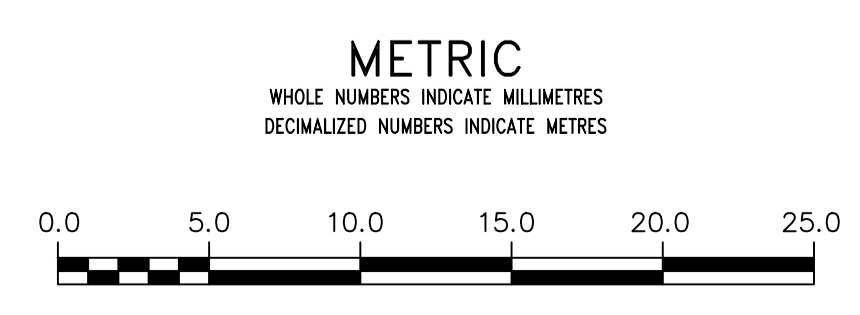

WARNING
 IF POWER EQUIPMENT OR EXPLOSIVES ARE TO BE USED FOR EXCAVATION ON THIS PROJECT THE CONTRACTOR MUST:
 1) NOTIFY THE GAS COMPANY OF THE PROPOSED LOCATION OF EXCAVATION.
 2) TAKE PRECAUTION TO AVOID DAMAGE TO GAS COMPANY INSTALLATIONS.
 SEE PROVINCIAL REGULATION 21072 FOR DETAILS

**LOCATION APPROVED
 UNDERGROUND STRUCTURES**
 SUPV. U/G STRUCTURES COMMITTEE DATE
 NOTE:
 LOCATION OF UNDERGROUND STRUCTURES AS SHOWN ARE BASED ON THE BEST INFORMATION AVAILABLE BUT NO GUARANTEE IS GIVEN THAT ALL EXISTING UTILITIES ARE SHOWN OR THAT THE GIVEN LOCATIONS ARE EXACT. CONFIRMATION OF EXISTENCE AND EXACT LOCATION OF ALL SERVICES MUST BE OBTAINED FROM THE INDIVIDUAL UTILITIES BEFORE PROCEEDING WITH CONSTRUCTION.

B.M. ELEV.			
CONSTRUCTION COMPLETION DATE: YYYY MM DD			
NO.	REVISIONS	DATE	BY
1	ISSUED FOR ADDENDUM 2	23/10/11	ADL
0	ISSUED FOR TENDER	23/09/20	ADL

AECOM

DESIGNED BY	JAT	CHECKED BY	MPG
DRAWN BY	ADL	APPROVED BY	KWF
SCALE:		RELEASED FOR CONSTRUCTION	
HORIZONTAL	1:250	S Cournoyer	
VERTICAL	1:50	DATE 23 09 20	
DATE 2023 10 11		DATE 23 09 20	

ENGINEER'S SEAL
 ORIGINAL SIGNED BY J.A. THOMPSON
 23/09/20
 CONSULTANT DRAWING NUMBER C-1001

THE CITY OF WINNIPEG
 WATER AND WASTE DEPARTMENT
 ENGINEERING DIVISION
 JEFFERSON EAST COMBINED SEWER RELIEF
 CONTRACT 9
 McGREGOR STREET
 SEMPLE AVENUE
 TO 5m SOUTH OF BURRIN AVENUE

SHEET 3 OF 14
 CITY DRAWING NUMBER LD-12148