

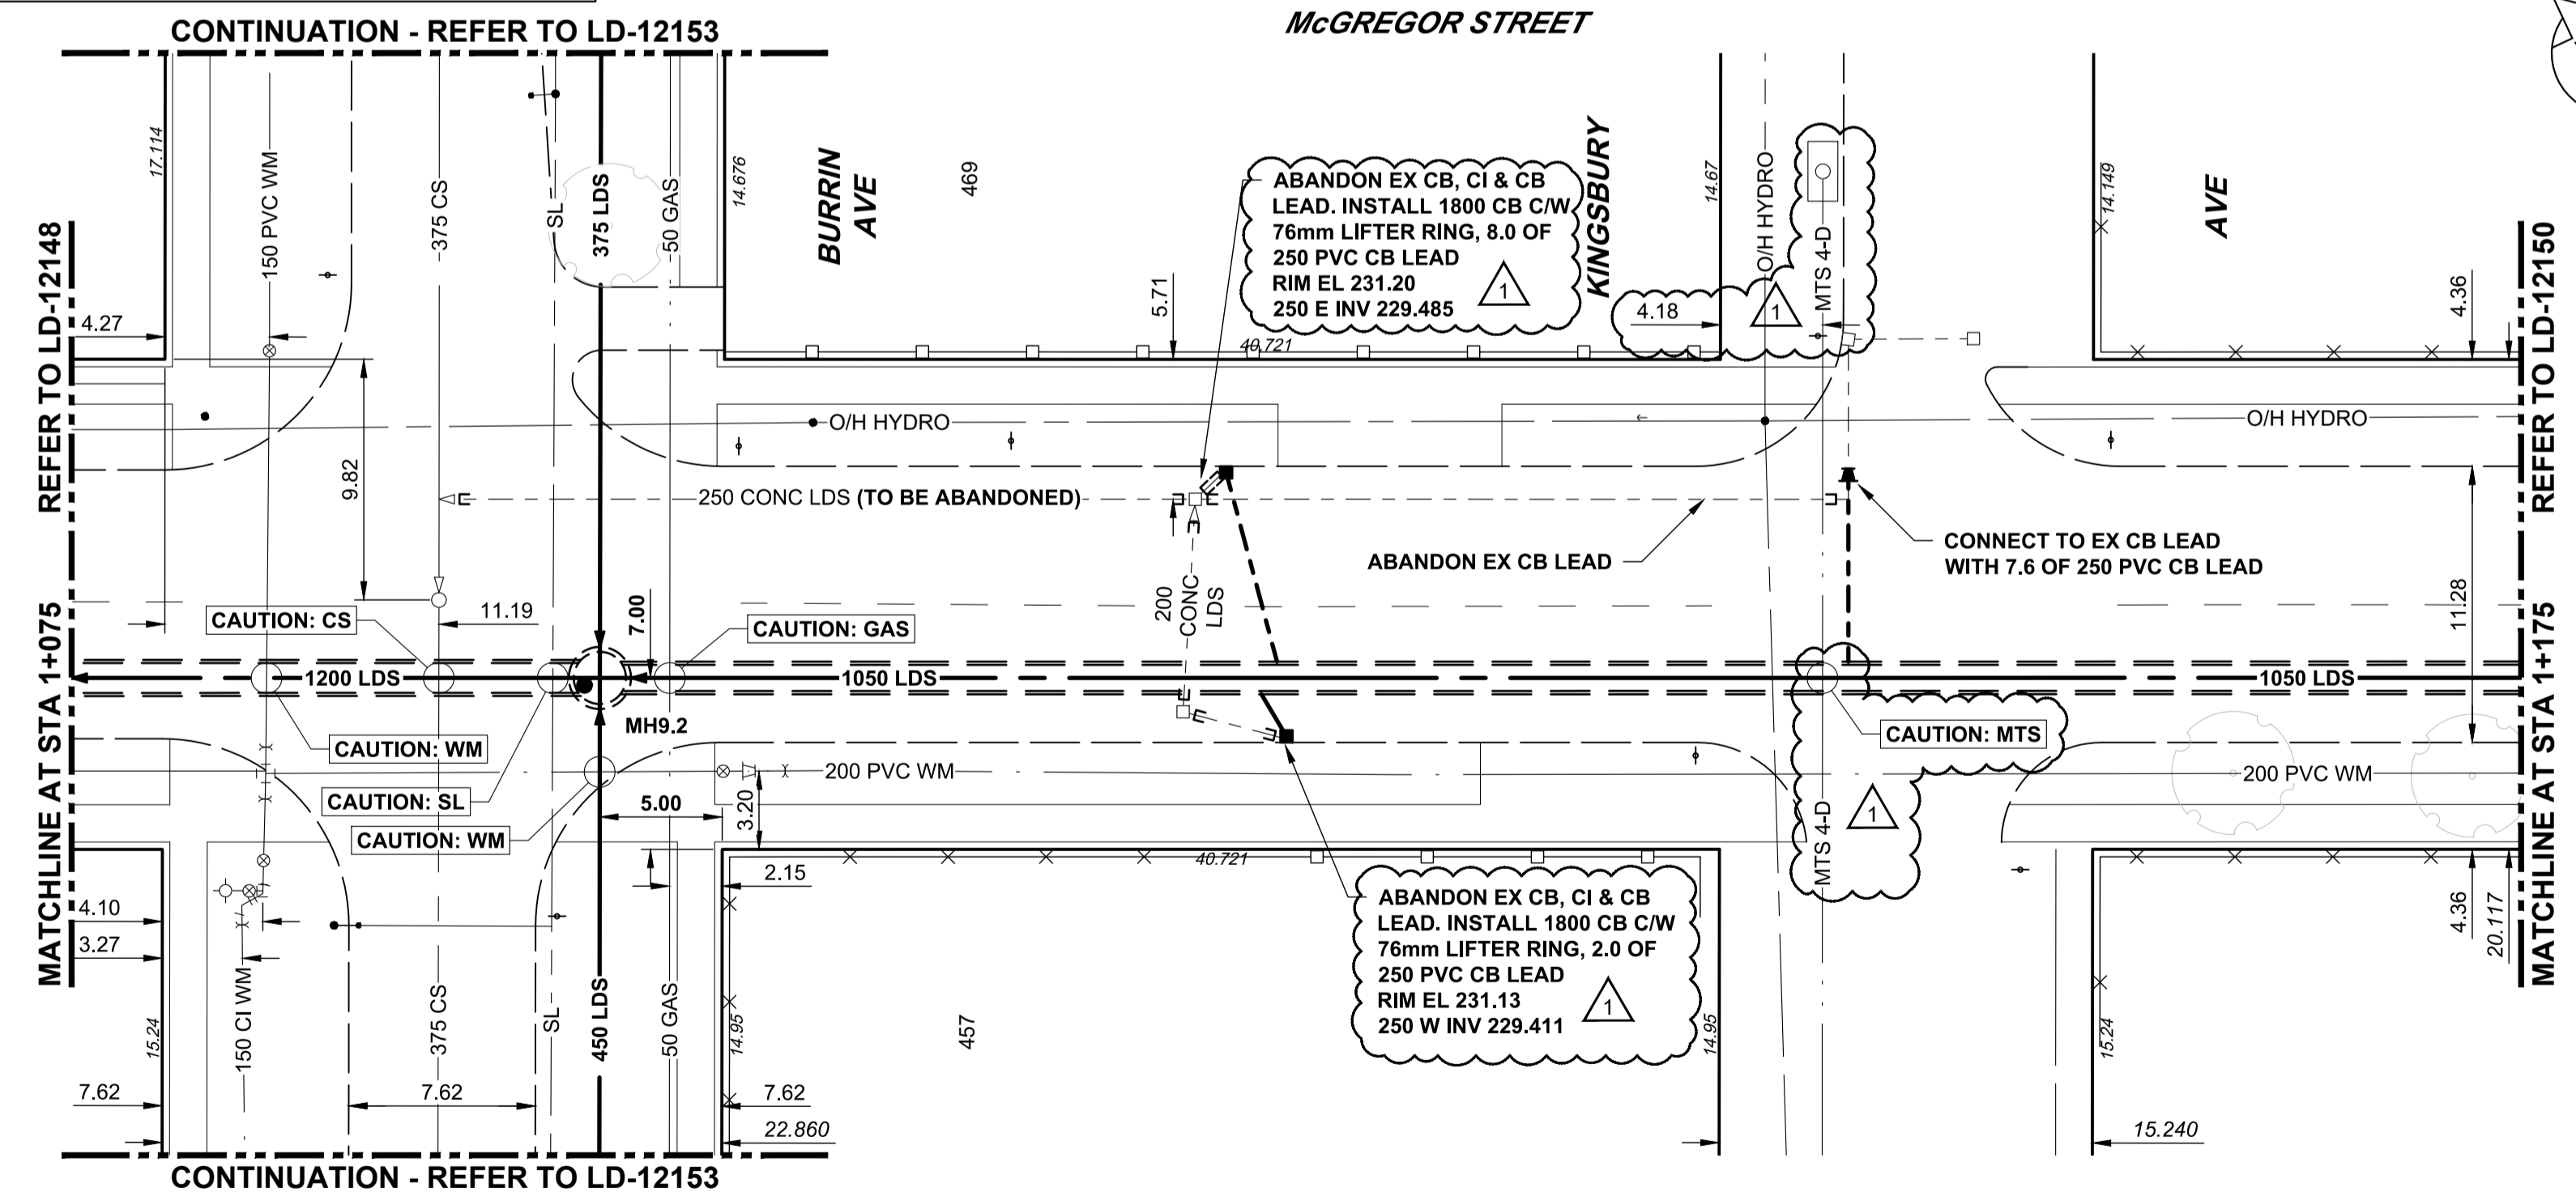


NOTE: CHAINAGES SHOWN ARE ALONG E. P.L. OF MCGREGOR STREET  
STA. 1+000.000 = N.P.L. SEMPLE AVENUE

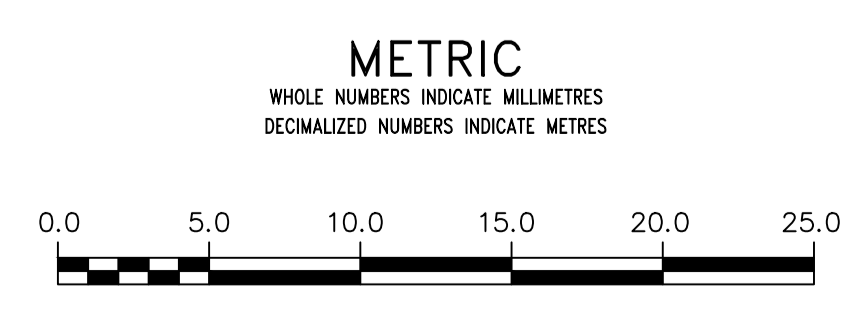

**ENGINEERS  
GEOSCIENTISTS  
MANITOBA**  
Certificate of Authorization  
AECOM Canada Ltd.  
No. 4671 Date: 23/09/20

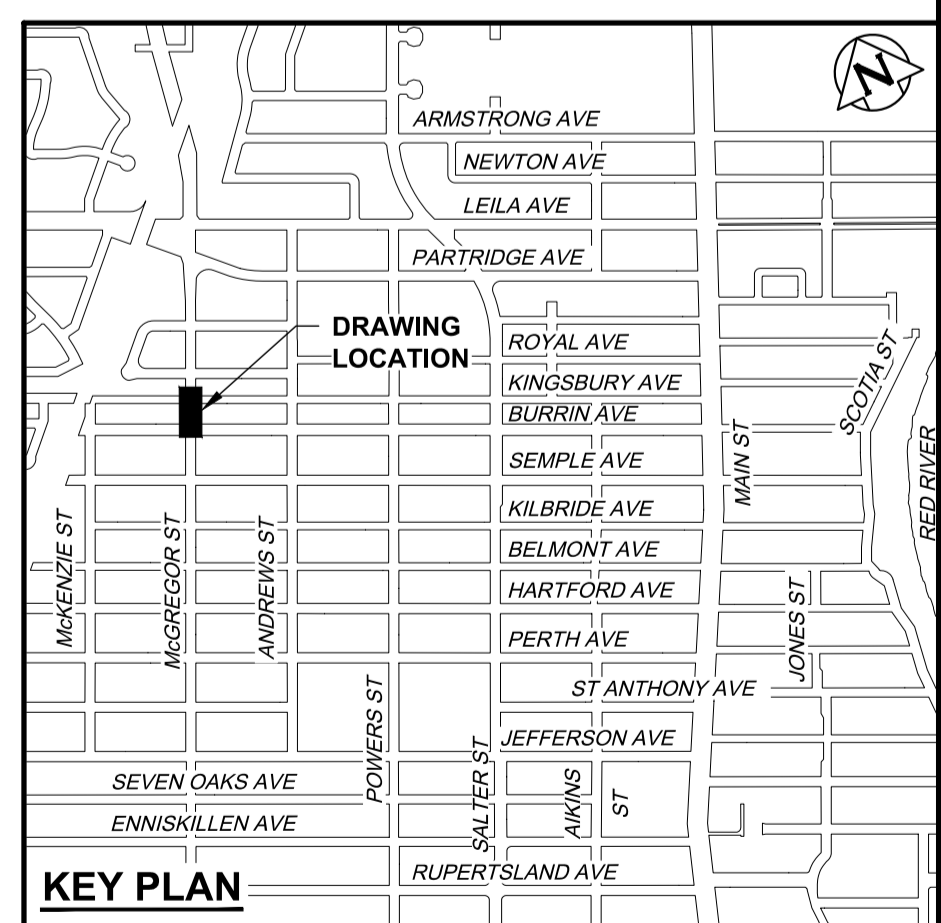

**WARNING**  
IF POWER EQUIPMENT OR EXPLOSIVES ARE TO BE USED FOR EXCAVATION ON THIS PROJECT THE CONTRACTOR MUST:  
1) NOTIFY THE GAS COMPANY OF THE PROPOSED LOCATION OF EXCAVATION.  
2) TAKE PRECAUTION TO AVOID DAMAGE TO GAS COMPANY INSTALLATIONS.  
SEE PROVINCIAL REGULATION 210/72 FOR DETAILS

**LOCATION APPROVED**  
UNDERGROUND STRUCTURES  
SUPV. U/G STRUCTURES COMMITTEE DATE  
NOTE:  
LOCATION OF UNDERGROUND STRUCTURES AS SHOWN ARE BASED ON THE BEST INFORMATION AVAILABLE BUT NO GUARANTEE IS GIVEN THAT ALL EXISTING UTILITIES ARE SHOWN OR THAT THE GIVEN LOCATIONS ARE EXACT. CONFIRMATION OF EXISTENCE AND EXACT LOCATION OF ALL SERVICES MUST BE OBTAINED FROM THE INDIVIDUAL UTILITIES BEFORE PROCEEDING WITH CONSTRUCTION.

| B.M. ELEV. |                       | CONSTRUCTION COMPLETION DATE: YYYY MM DD |     |
|------------|-----------------------|------------------------------------------|-----|
| NO.        | REVISIONS             | DATE                                     | BY  |
| 1          | ISSUED FOR ADDENDUM 2 | 23/10/11                                 | ADL |
| 0          | ISSUED FOR TENDER     | 23/09/20                                 | ADL |

**AECOM**

|             |                                   |                           |             |
|-------------|-----------------------------------|---------------------------|-------------|
| DESIGNED BY | JAT                               | CHECKED BY                | MPG         |
| DRAWN BY    | ADL                               | APPROVED BY               | KWF         |
| SCALE:      | HORIZONTAL 1:250<br>VERTICAL 1:50 |                           |             |
| DATE        | 2023 10 11                        | RELEASED FOR CONSTRUCTION | S Cournoyer |
| PLOT DATE:  | 2023 10 11                        | DATE                      | 23 09 20    |

ENGINEER'S SEAL  
ORIGINAL SIGNED BY J.A. THOMPSON  
23/09/20  
CONSULTANT DRAWING NUMBER C-1002

**THE CITY OF WINNIPEG**  
WATER AND WASTE DEPARTMENT  
ENGINEERING DIVISION  
JEFFERSON EAST COMBINED SEWER RELIEF  
CONTRACT 9  
McGREGOR STREET  
75m NORTH OF SEMPLE AVENUE  
TO 15m SOUTH OF ROYAL AVENUE

SHEET 4 OF 14  
CITY DRAWING NUMBER LD-12149