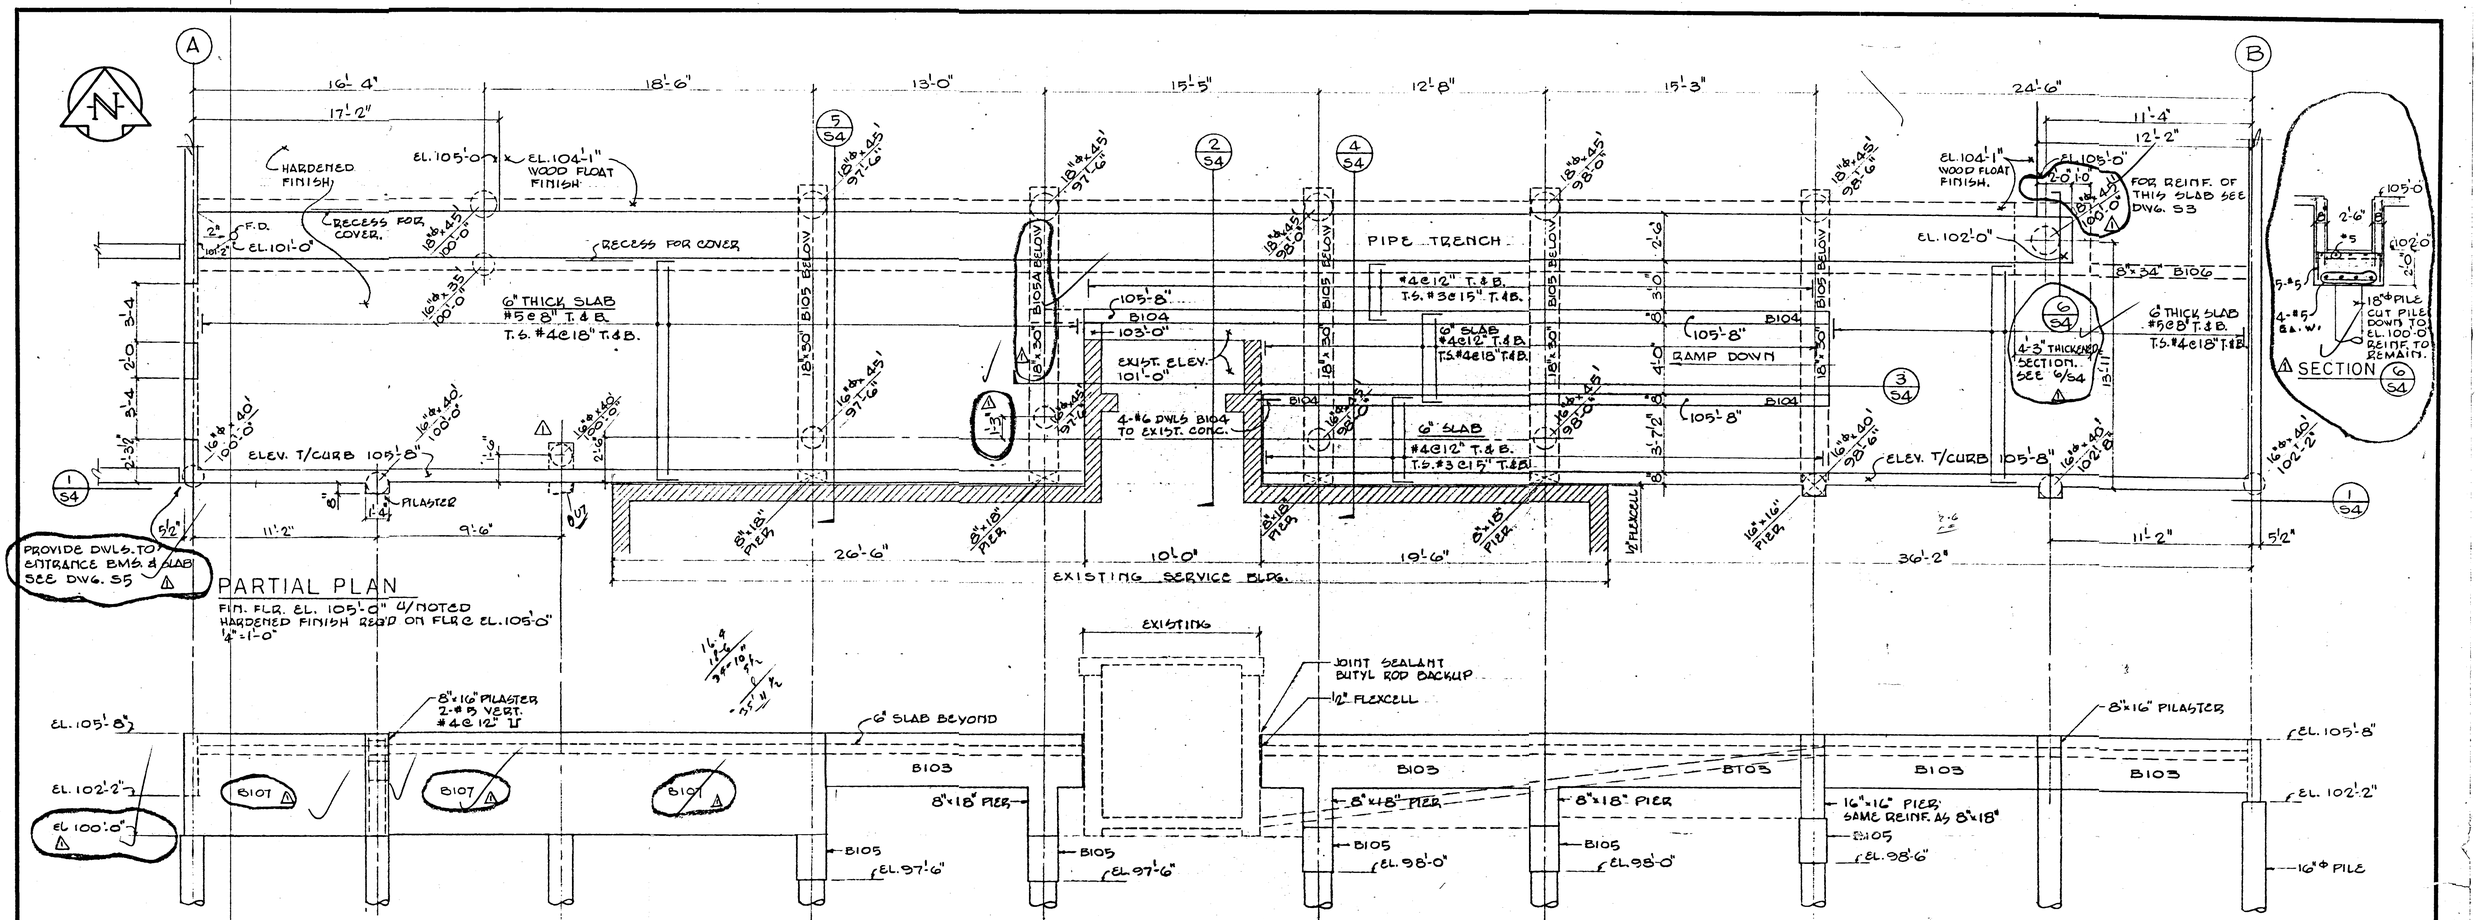

B-14 FILE

RETURN TO CIVIC PROPERTIES BUILDING INVENTORY.

3074

NOTE:
△1 ALL CONCRETE & DEMOLITION WORK ON THIS DRAWING BY "CONCRETE CONTRACTOR"

BEAM SCHEDULE			
MARK	SIZE	REINFORCING	REMARKS
△1 B107	8"x68"	2-#6 TOP & BTM. 4-#4 MIDDLE HORIZ. #4@18" E.F. VERT. 2-#5 IN CURB HORIZ.	
B101	8"x42"	2-#8 TOP & BOT. 2-#5 HORIZ. E.F. #3@12"	SHOWN ON DWG. S3
B102 B103	8"x36"	2-#8 TOP & BOT. 2-#5 HORIZ. E.F. #3@12"	B102, SHOWN ON DWG. S3
B104	8"x56"	2-#6 TOP & BOT. 2-#5 HORIZ. E.F. #4@18" VERT. E.F.	
B105 △1 B105A	18"x30"	2-#9 TOP & BOT. STIRR. - #3@6" IN 2'-0" CANTILEVER #3@12" REM.	REINF. FOR B105A, SAME AS B105, EXCEPT △1 PROVIDE 3#9 TOP.
B106	8"x34"	2-#8 TOP & BOT. 1-#5 HORIZ. E.F. #3@12"	

NO.	DESCRIPTION	DATE	BY
△1	GRADE BM & BMS REVISED REINF. ADDED & IDENTIFIED SECTION 6/S4 ADDED.	APR 7/72	TO

REVISIONS

CITY OF WINNIPEG
COMMUNITY OF EAST KILDONAN

W. L. WARDROP & ASSOCIATES LTD.
ENGINEERING CONSULTANTS
WINNIPEG THUNDER BAY REGINA

EAST KILDONAN RECREATIONAL CENTRE
ARENA
CONCRETE DETAIL PLAN & DETAILS

PROVINCE OF MANITOBA
B. RUZSICSKA
REGISTERED ENGINEER

DESIGNED BY:	DRAWN BY:	CHECKED BY:
B. J. R.	TO	BR

APPROVED BY: B. Ruzsicska

SCALE: AS SHOWN

DATE: MAR. 1972

DRAWING NO: 71185-01-S4

REV. 1