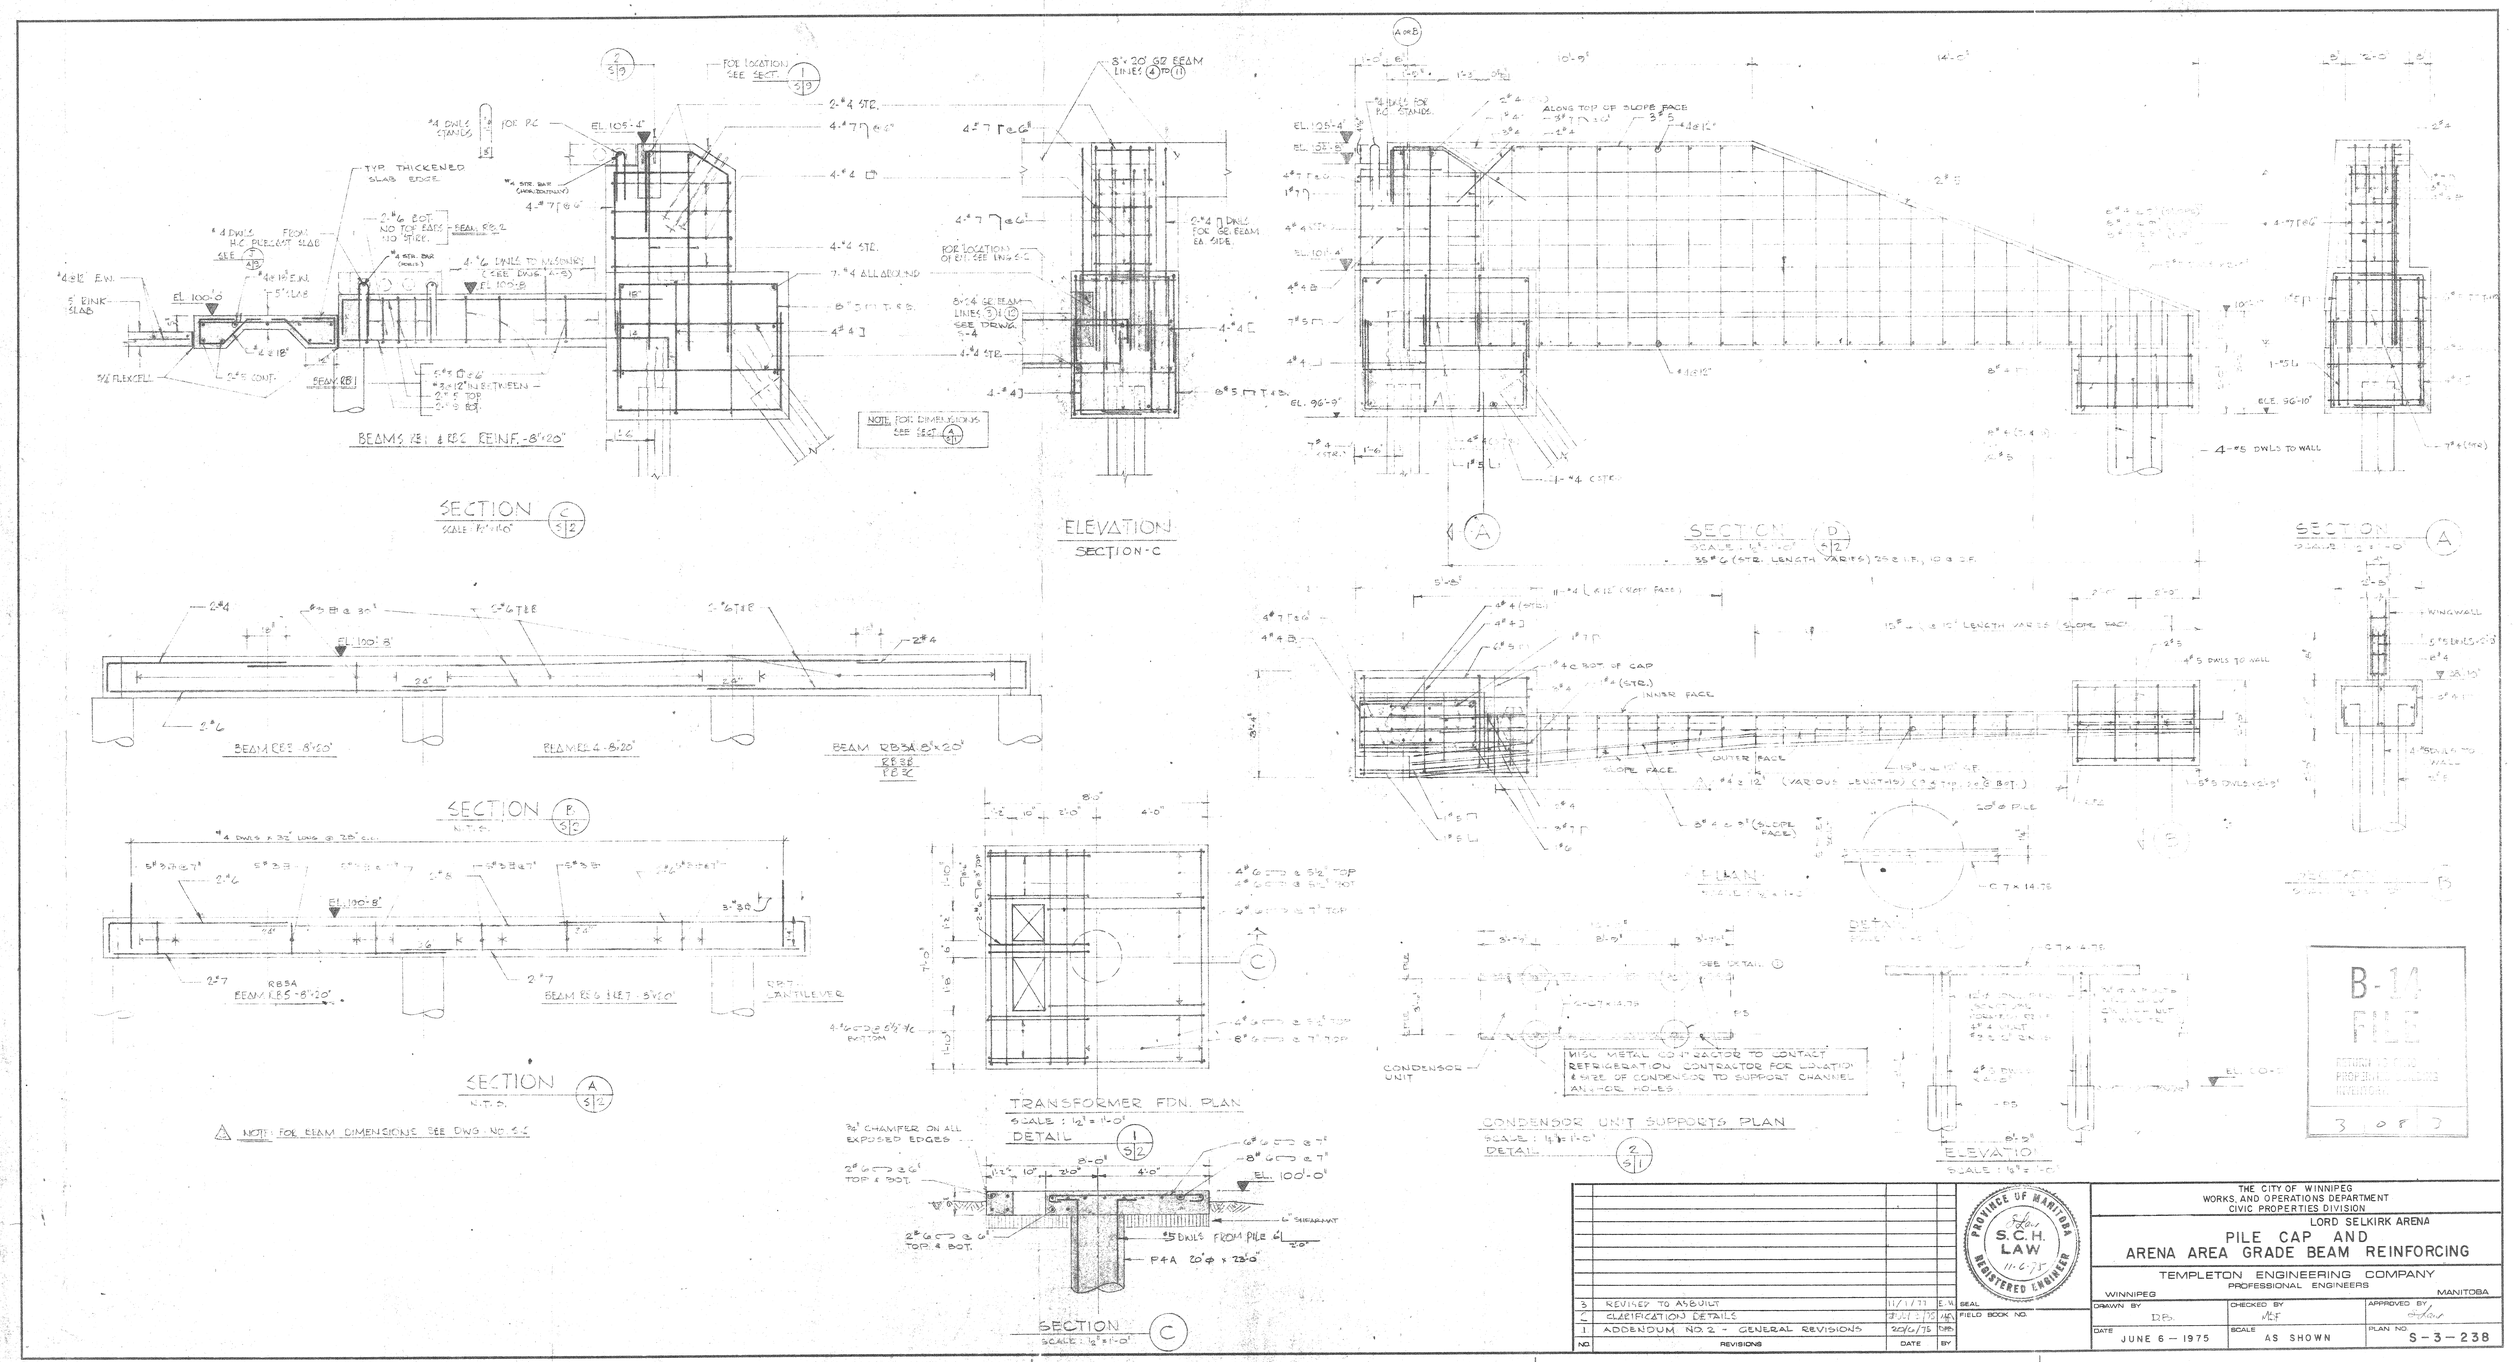

NO.	REVISIONS	DATE	BY
3	REVISED TO ASBUILT	11/1/77	E.W.
1	ADDENDUM NO. 2 - GENERAL REVISIONS	25/6/75	DMB

PROVINCE OF MANITOBA
S.C.H. LAW
11-6-75
REGISTERED ENGINEER
SEAL
FIELD BOOK NO.

THE CITY OF WINNIPEG
WORKS AND OPERATIONS DEPARTMENT
CIVIC PROPERTIES DIVISION

LORD SELKIRK ARENA

PILE CAP AND ARENA AREA GRADE BEAM REINFORCING

TEMPLETON ENGINEERING COMPANY
PROFESSIONAL ENGINEERS
WINNIPEG MANITOBA

DRAWN BY	CHECKED BY	APPROVED BY
D.B.	M.F.	
DATE: JUNE 6 — 1975	SCALE: AS SHOWN	PLAN NO. S-3-238