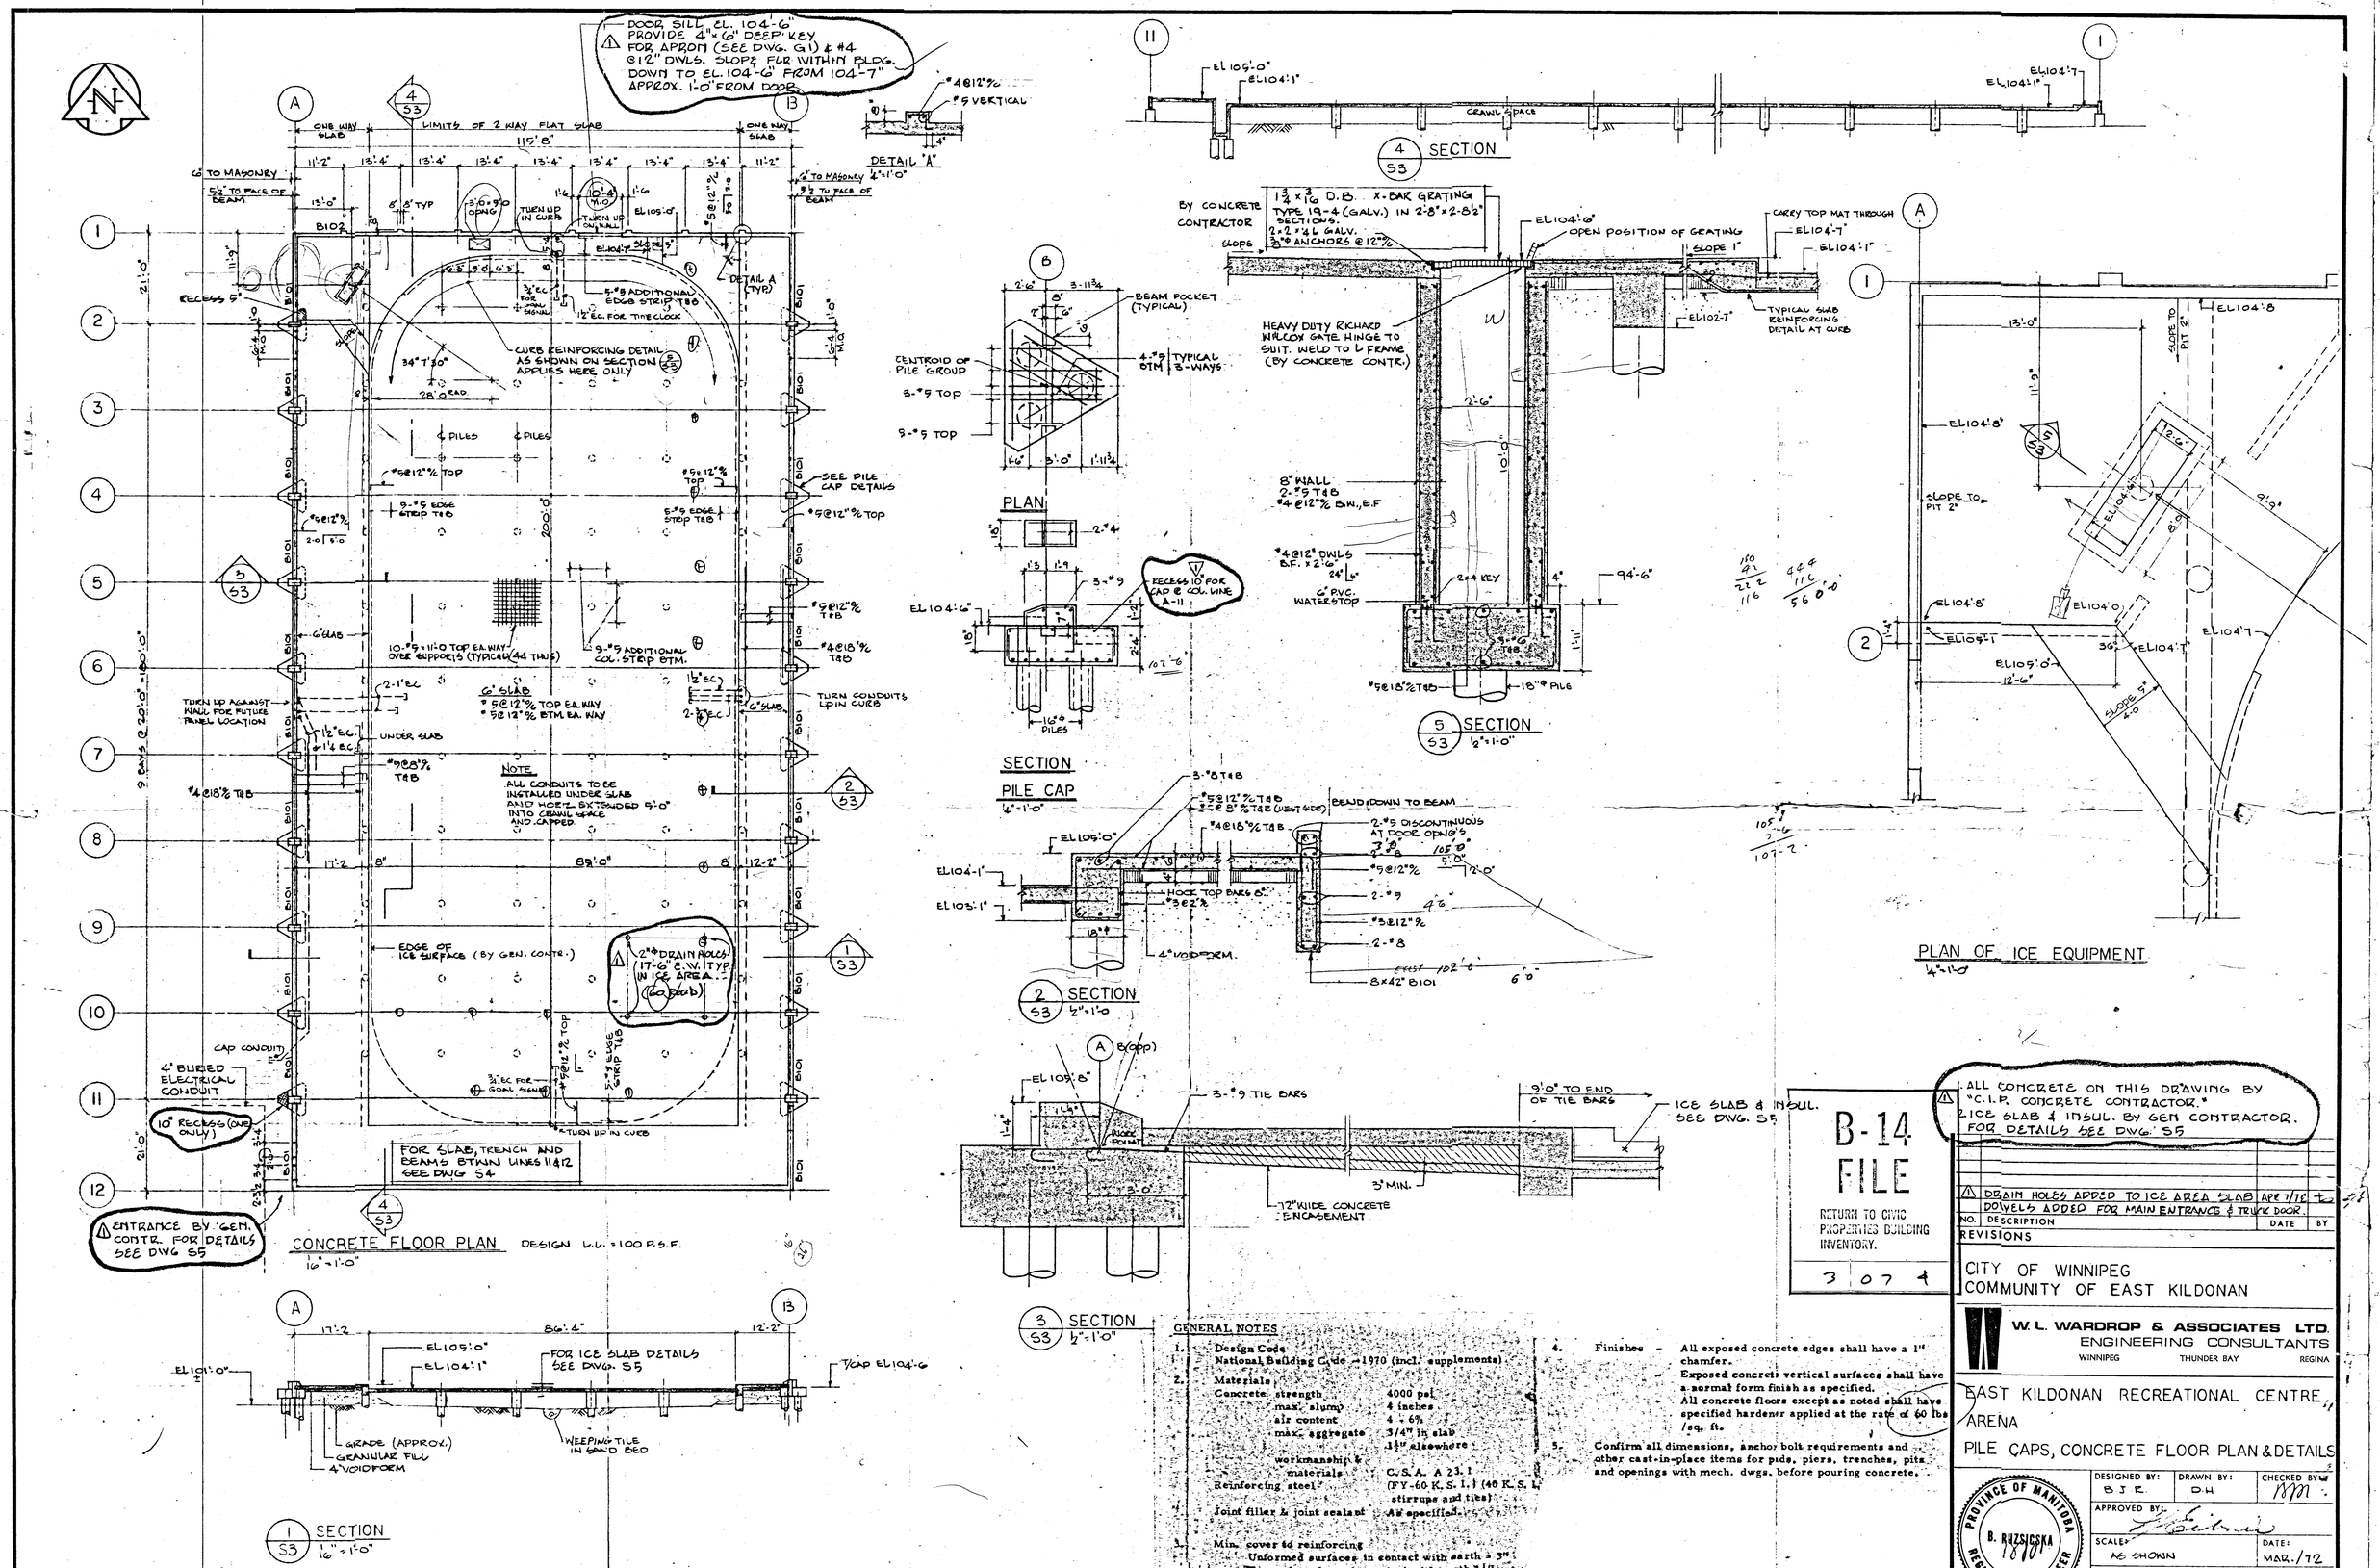

GENERAL NOTES

1. Design Code
   National Building Code - 1970 (incl. supplements)
2. Materials
   Concrete strength 4000 psi
   max. slump 4 inches
   air content 4 - 6%
   max. aggregate 3/4" in slab
   1½" elsewhere
   workmanship & materials C.S.A. A 23.1
   Reinforcing steel (FY-60 K.S.I.) (40 K.S.I. stirrups and ties)
   Joint filler & joint sealant As specified
3. Min. cover to reinforcing
   Unformed surfaces in contact with earth 3"
   Formed surfaces in contact with earth 1½"
   top surface 3/4"
   btm. surface 3/4"
4. Finishes - All exposed concrete edges shall have a 1" chamfer.
   - Exposed concrete vertical surfaces shall have a normal form finish as specified.
   - All concrete floors except as noted shall have specified hardener applied at the rate of 60 lbs/sq. ft.
5. Confirm all dimensions, anchor bolt requirements and other cast-in-place items for pads, piers, trenches, pits and openings with mech. dwgs. before pouring concrete.