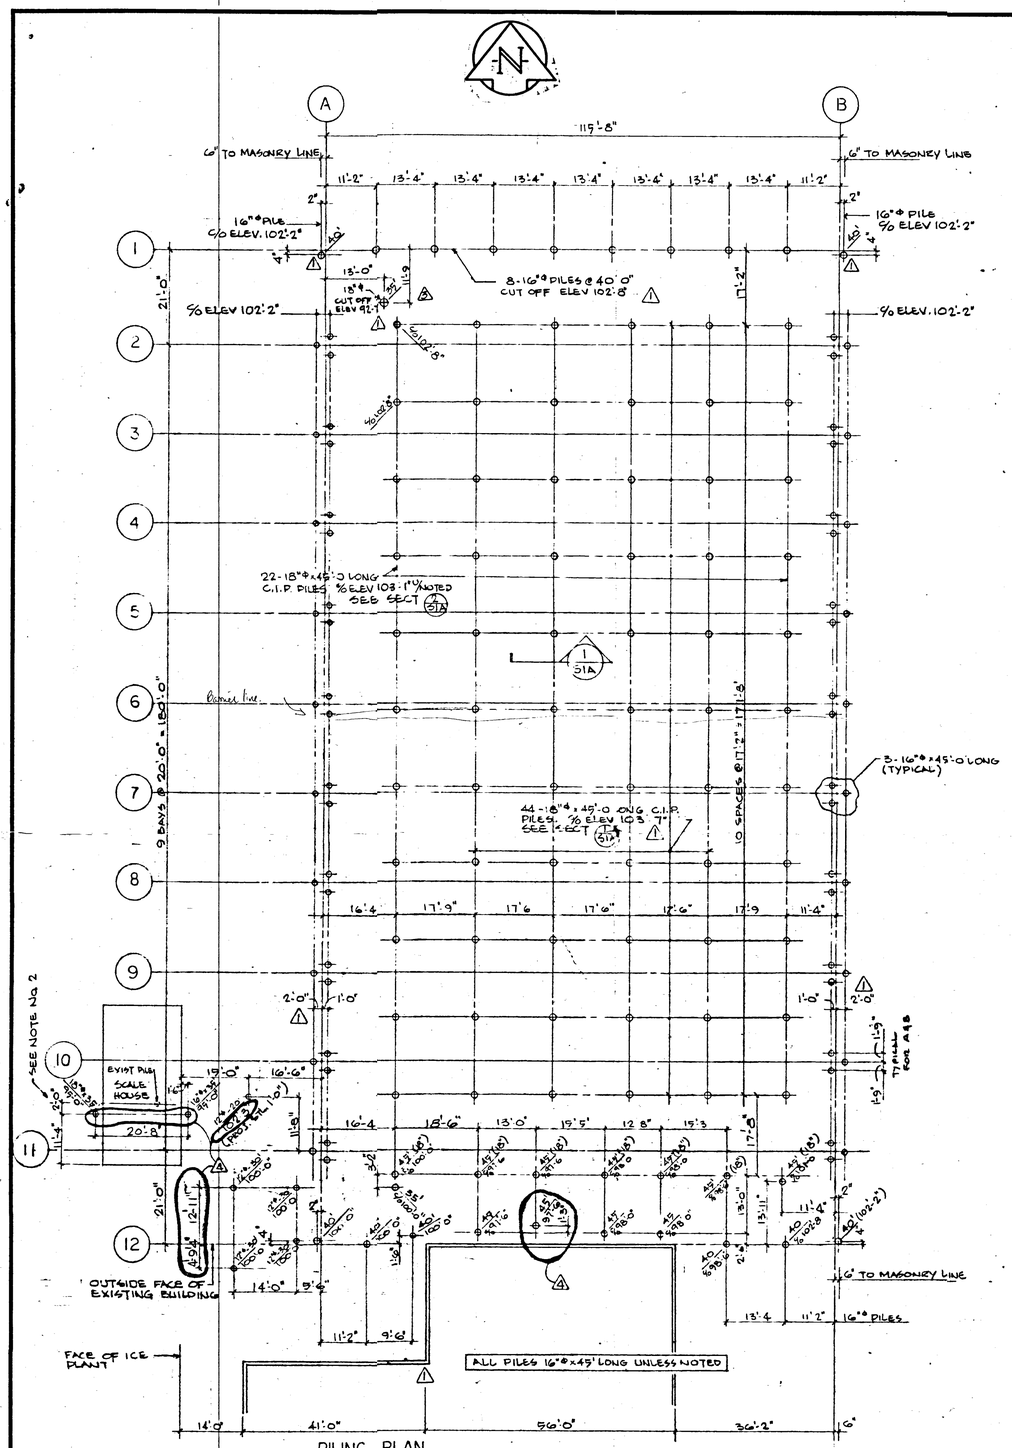


PILING PLAN
1/16" = 1'-0"

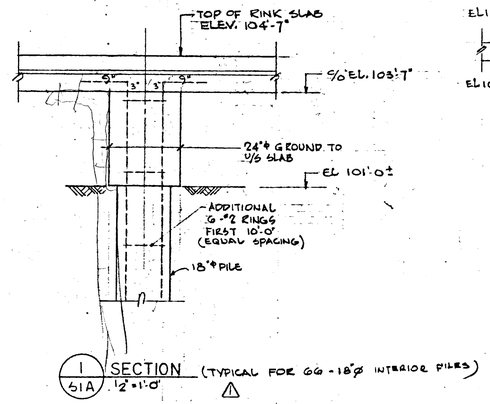


1/S1A SECTION 1/2" = 1'-0" (TYPICAL FOR 66 - 18"ø INTERIOR PILES)

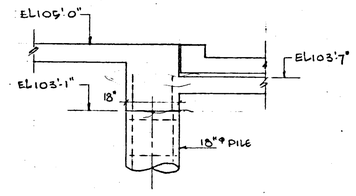


2/S1A SECTION 1/2" = 1'-0"

NOTE RE. PILE REINFORCING:

VERTICAL REINFORCING TO PROJECT 24" ABOVE PILE CUT OFF ELEV. WITH STANDARD HOOKS. (TYPICAL FOR ALL PILES, EXCEPT AS SHOWN IN SECTION 1/S1A)

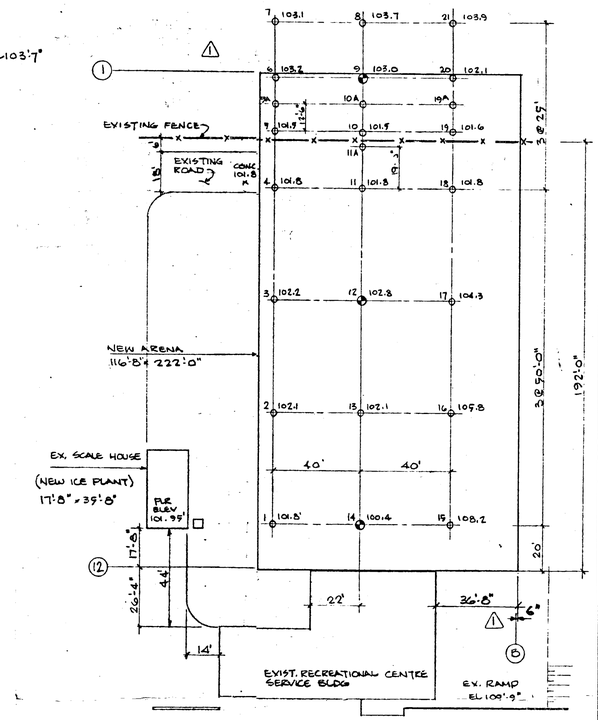


B-14 FILE
RETURN TO CIVIC PROPERTIES BUILDING INVENTORY.
3 07 4

AUGERED TEST HOLES 16"ø
LOGGED FEB 17 & 18, 1972
LOG INFORMATION IS AVAILABLE AT W. L. WARDROP & ASSOC.

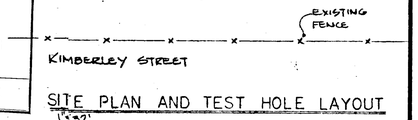


SITE PLAN AND TEST HOLE LAYOUT
1" = 32'

NOTES

1. ALL PILING ON THIS DRAWING BY "PILING CONTRACTOR".
2. CONFIRM IN FIELD THIS 2'-0" DIMENSION BEFORE AUGERING PILES

| NO. | DESCRIPTION | DATE | BY |
|---|---|---|---|
| 4 | 2 PILES ADDED - SCALE HOUSE | | |
| | MISC. REVISIONS & NOTE ADDED | APR. 7/72 | EO |
| 3 | "HOLES" REMOVED, S-W ENTRY PILES REV. & RELOCATED | MARCH | DH |
| | NEW 120 PILES ADD, 50 EL. FOR 3 PILES (A-12) REV. & 1 RELOC | 30/72 | |
| 2 | REVISED CUTOFF'S & LOCATIONS OF INTERIOR PILES | MAR. 14/72 | EO |
| 1 | GENERAL REVISIONS | MAR 8/72 | DH |

REVISIONS

CITY OF WINNIPEG
COMMUNITY OF EAST KILDONAN

W. L. WARDROP & ASSOCIATES LTD.
ENGINEERING CONSULTANTS
WINNIPEG THUNDER BAY REGINA

EAST KILDONAN RECREATIONAL CENTRE
ARENA
PILING PLAN & DETAILS

PROVINCE OF MANITOBA
B. RUZSICSKA
REGISTERED ENGINEER

| DESIGNED BY: | DRAWN BY: | CHECKED BY: |
|---|---|---|
| B.J.R. | D.H. | |

APPROVED BY:

| SCALE: | DATE: |
|---|---|
| AS SHOWN | FEB 18/72 |

DRAWING NO: 71185-03 - S1A REV. 4