709 KEEWATIN S-1R BILLY MOSIENKO ARENA JAN., 1977
BILLY MOSIENKO ARENA AR-08

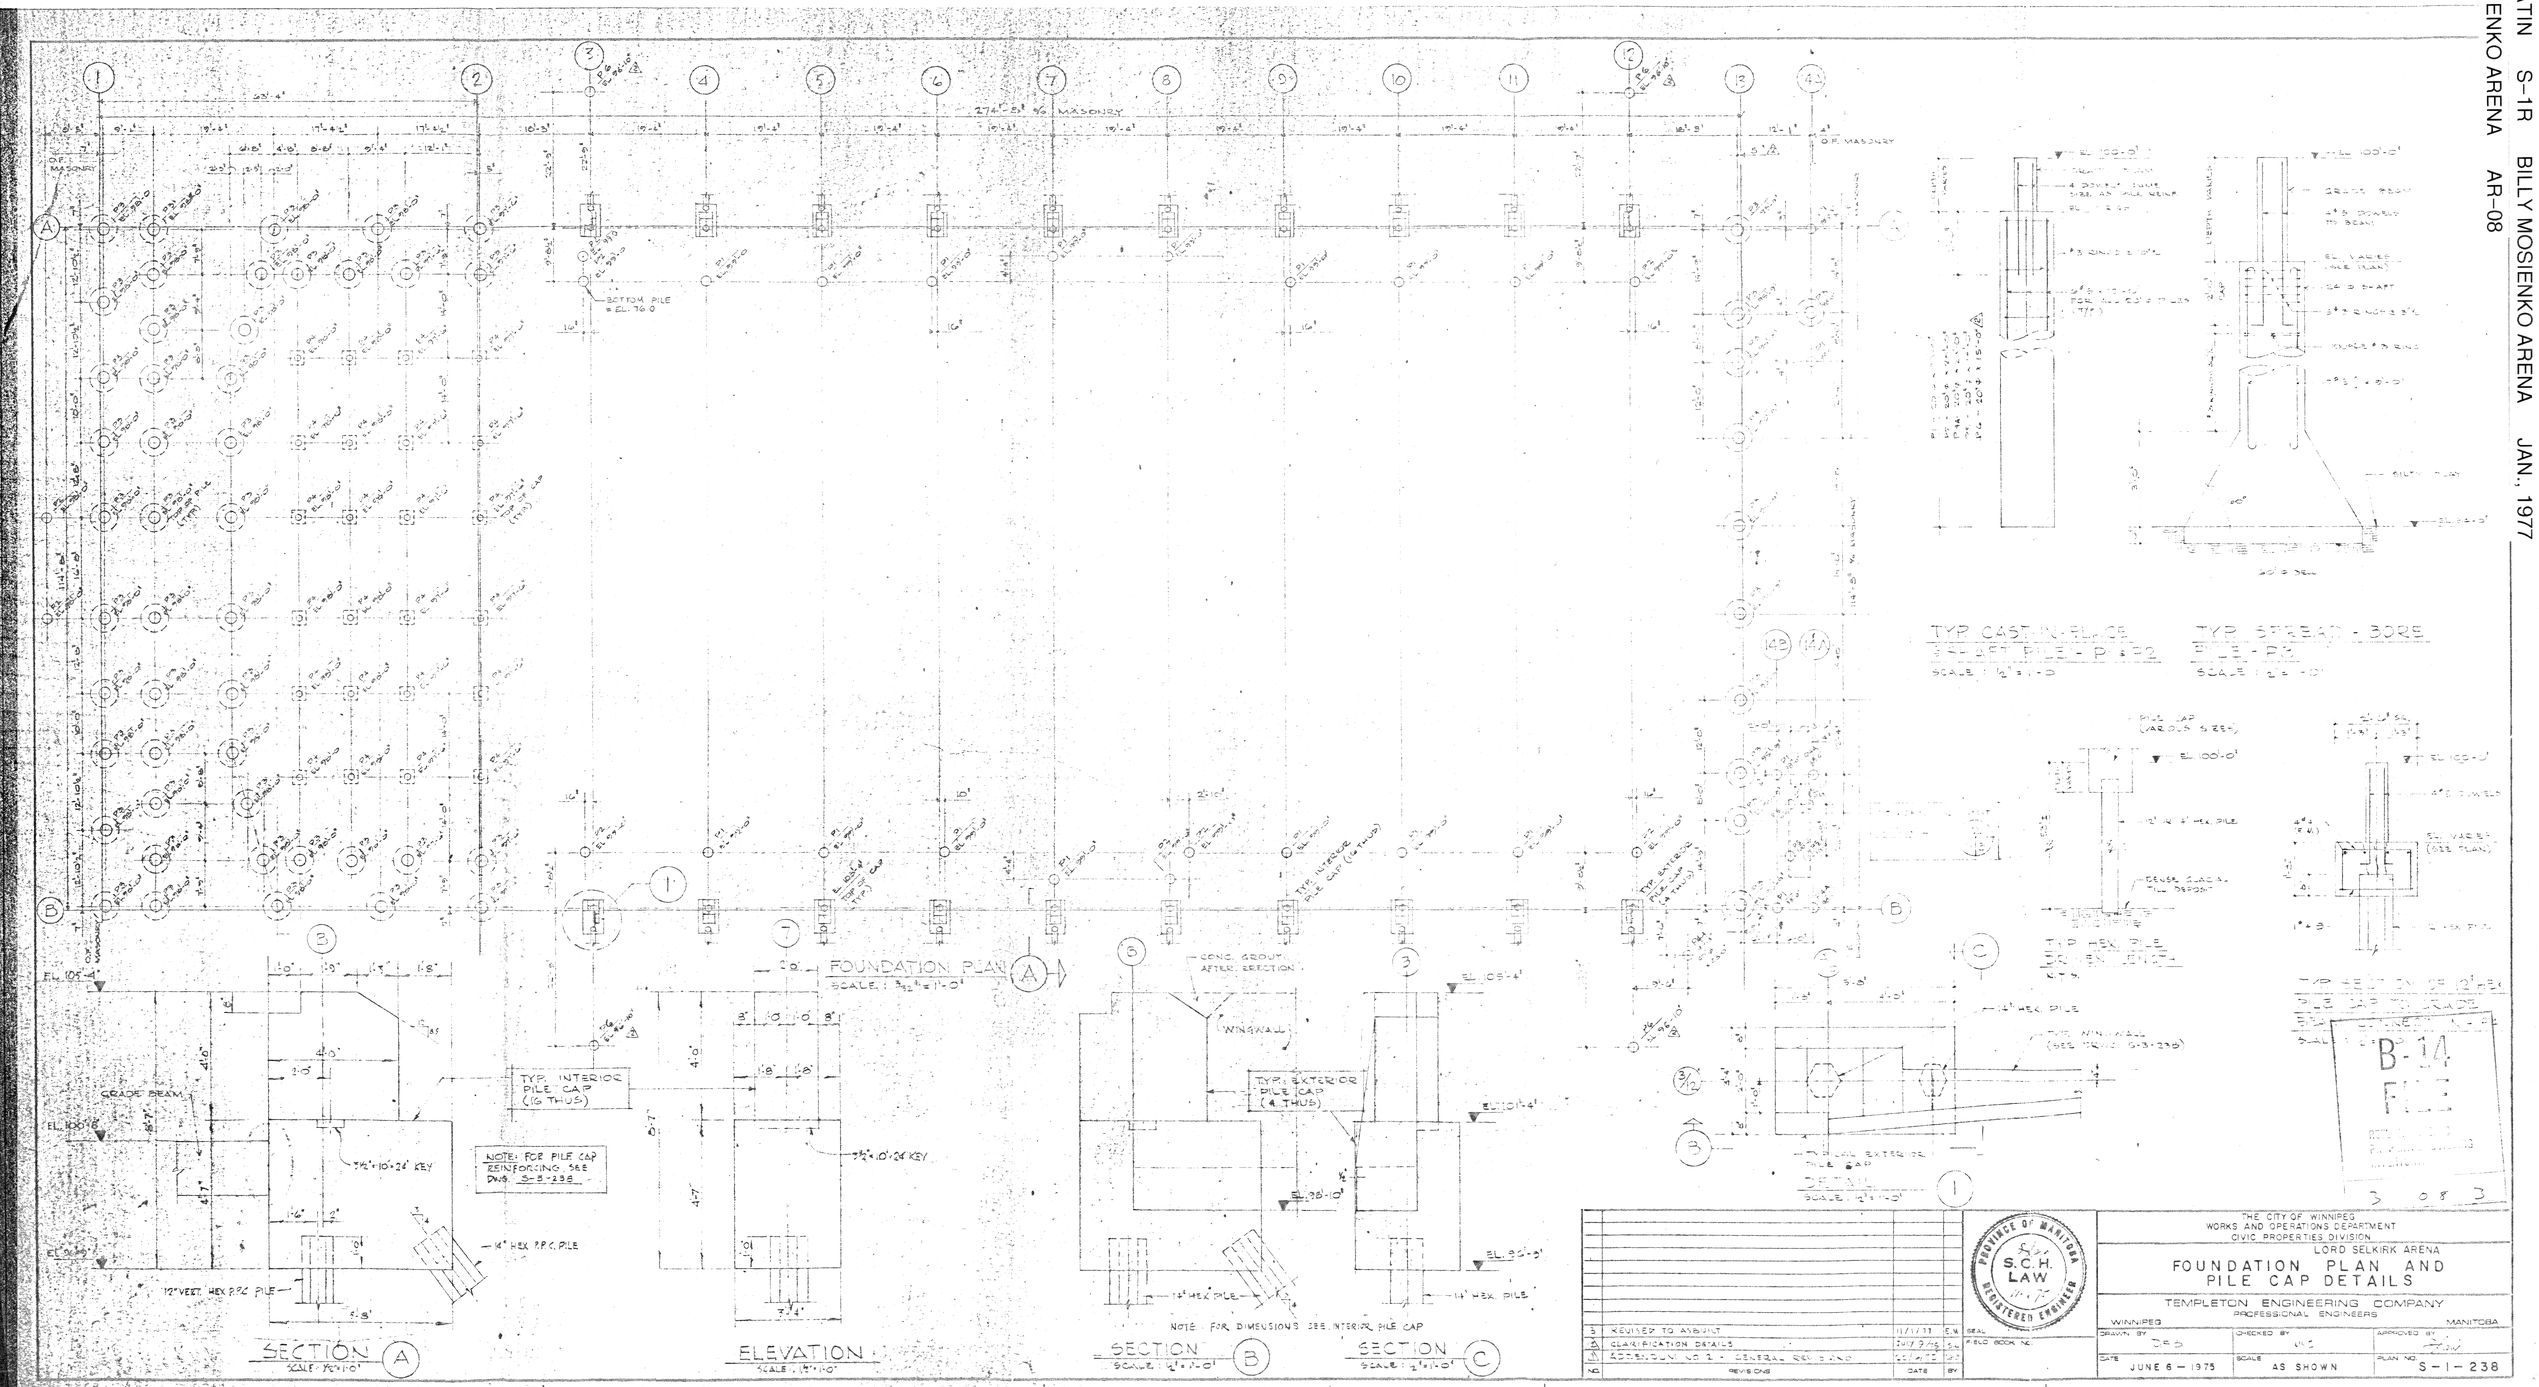

NO.	REVISIONS	DATE	BY
3	REVISED TO ASBUILT	11/11/77	C.M.
2	CLARIFICATION DETAILS	JULY 7/76	S.L.
1	ADDENDUM NO. 2 - GENERAL REVISIONS	12/4/75	S.L.

PROVINCE OF MANITOBA — S.C.H. LAW — REGISTERED ENGINEER

SEAL
FIELD BOOK NO.

THE CITY OF WINNIPEG
WORKS AND OPERATIONS DEPARTMENT
CIVIC PROPERTIES DIVISION

LORD SELKIRK ARENA

FOUNDATION PLAN AND PILE CAP DETAILS

TEMPLETON ENGINEERING COMPANY
PROFESSIONAL ENGINEERS
WINNIPEG MANITOBA

DRAWN BY	CHECKED BY	APPROVED BY
D.E.D.	W.S.	[illegible]
DATE: JUNE 6 — 1975	SCALE: AS SHOWN	PLAN NO. S-1-238