



TYPICAL LONGITUDINAL SECTION

No direct connection between water supply & pool or equipment
 Concentric shielded cable not acceptable

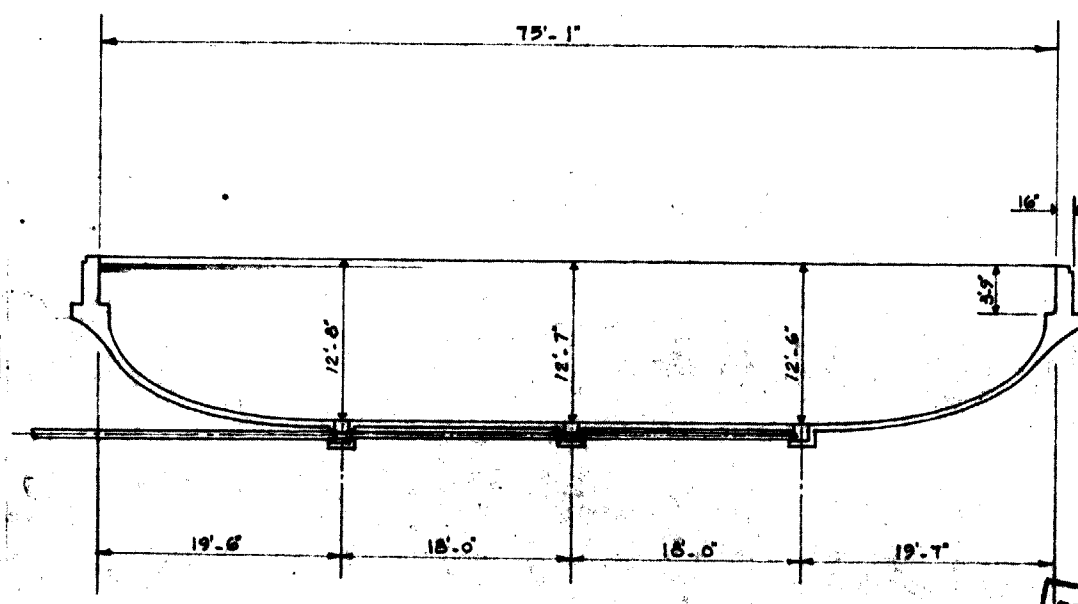

SECTION "A-A"

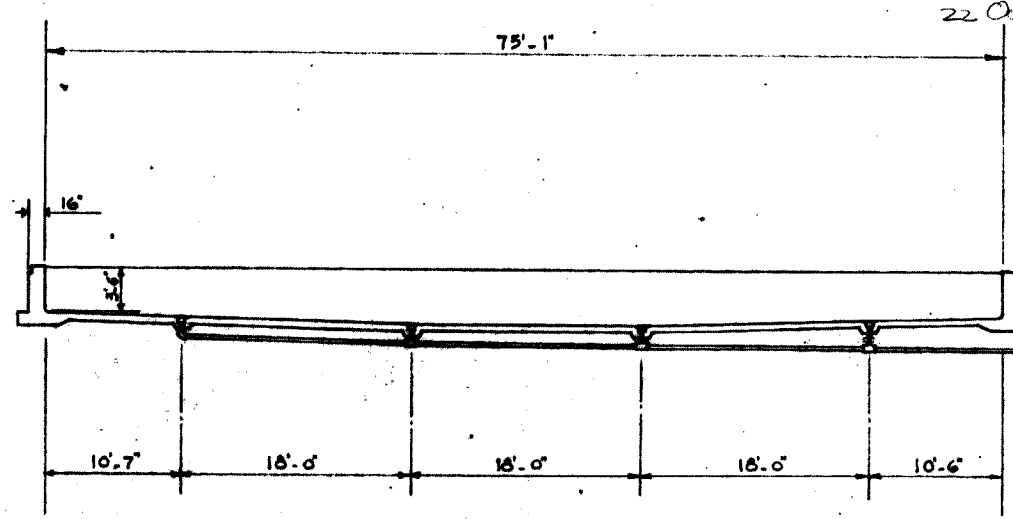


SECTION "B-B"

Etched floor to be submitted as per spec. Get refer to connection allowed between the portable water supply & pool or equipment

13/9/65

Elev. 700.0
 Elev. 714.0
 3" polyethylene pipe

APPLICATION APPROVAL					
DEPT.	APPLIED FOR	DATE	TIME	DATE	TIME
EDUC.		12/16/65		12/15	
PLANN.					
S. & IR.					
W. & M.					
MUNIC.					
PROV.					

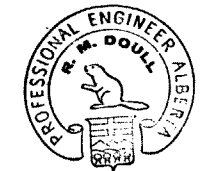

JOB	SWIMMING pool		
DRAWN	pool profile & sections		
FOR	KILDONAN PARK-WINDIPIC		
TH. CANADA GLENITE CO. LTD.			
HALIFAX MONTREAL BURLINGTON WINNIPEG CALGARY			
DATE	SCALE	FIG. NO.	SHEET NO.
APR 26/65	1/8" = 1'-0"	021	2-1

Main ST.