


## **APPENDIX A – SITE AND BASE PLAN INFORMATION**

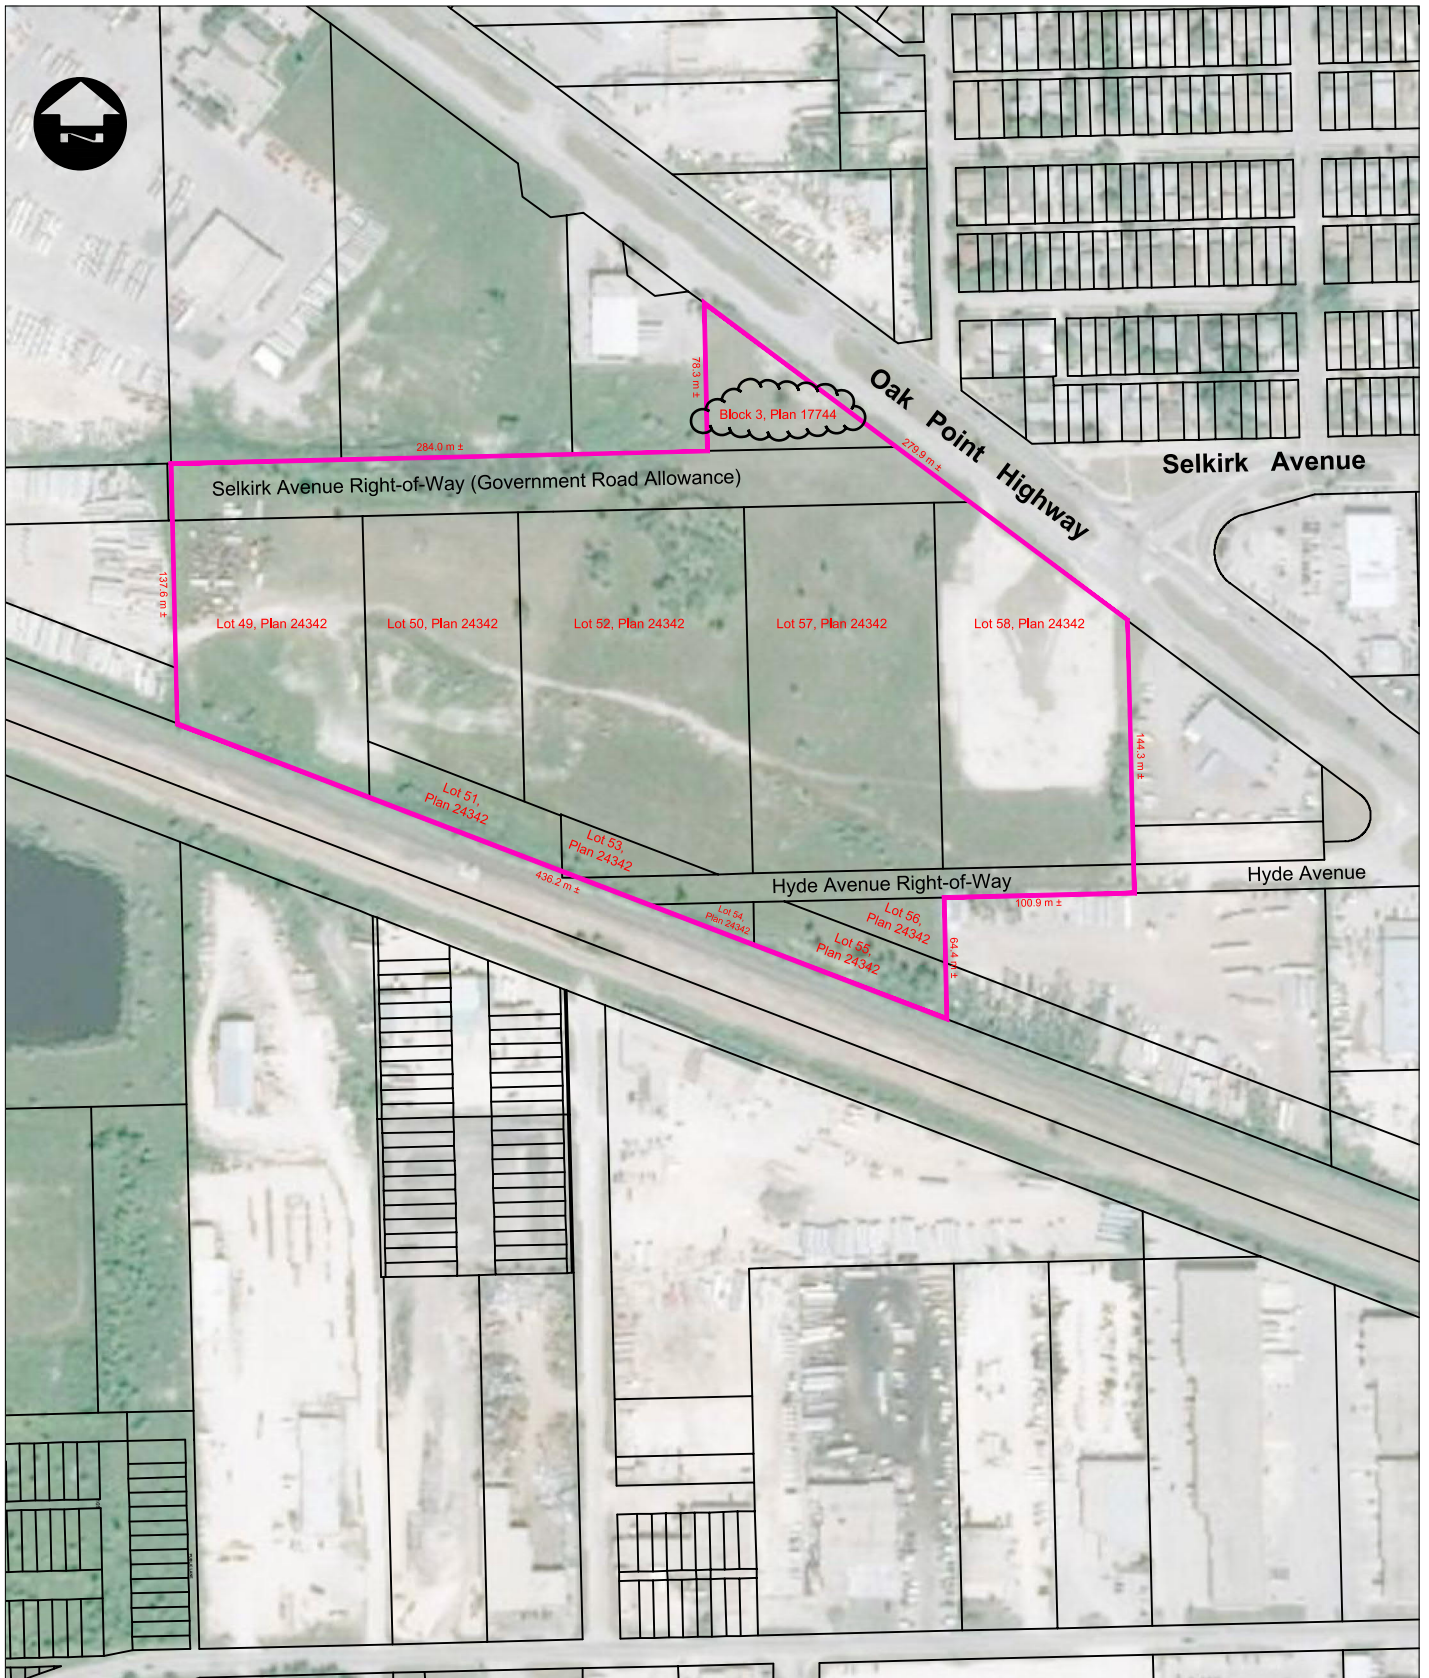

SCALE: 1:4000

## North Garage Replacement

### Site Plan and Legal Parcels



