


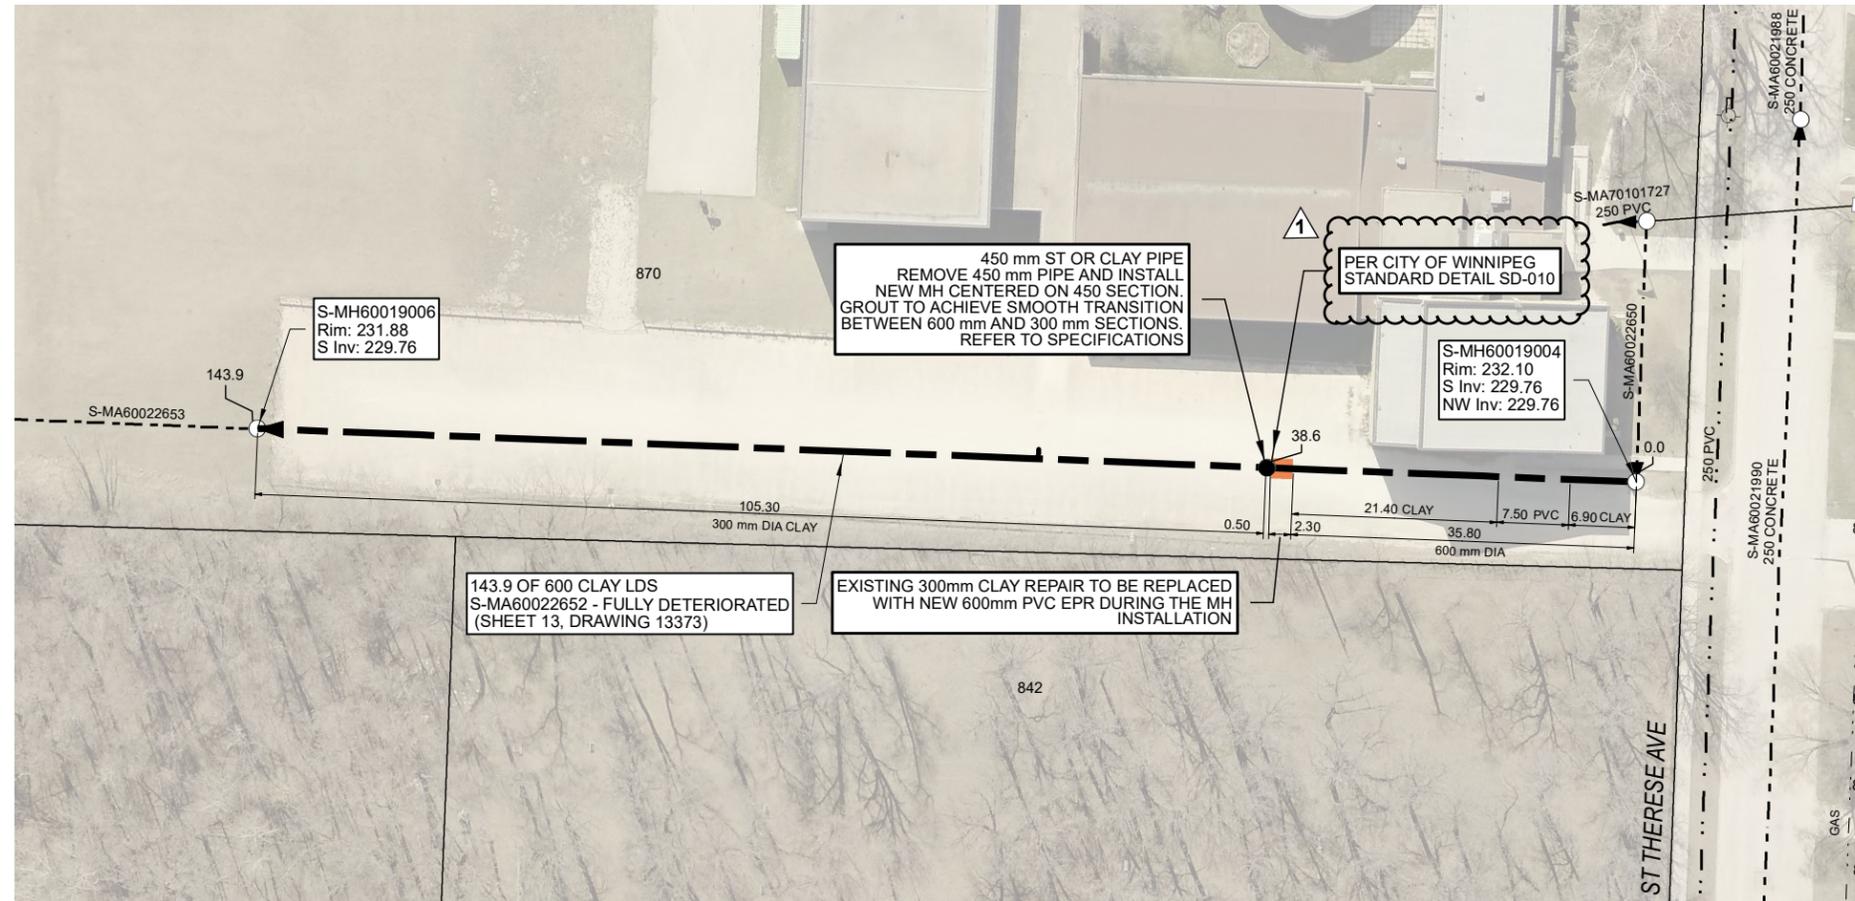

SEWER JUNCTION INFORMATION FROM SEWER VIDEO INSPECTION			
SEWER ID S-MA60022652			
Reference MH	Distance	DIA	Clock
S-MH60019004	062.4	150	03

Traffic Controls
 Regional Street Lane Closure Required: No
 Impacted Regional St: N/A

General Requirements:
 Residential Street Restrictions



FOR INDEX SEE
13362

METRIC
 WHOLE NUMBERS INDICATE MILLIMETRES
 DECIMALIZED NUMBERS INDICATE METRES
 0 2.5 5 10 15 20
 Metres

WARNING
 IF POWER EQUIPMENT OR EXPLOSIVES ARE TO BE USED FOR EXCAVATION ON THIS PROJECT, THE CONTRACTOR MUST:
 1) NOTIFY THE GAS COMPANY OF THE PROPOSED LOCATION OF EXCAVATION.
 2) TAKE PRECAUTION TO AVOID DAMAGE TO GAS COMPANY INSTALLATIONS.
 SEE PROVINCIAL REGULATION 140/92 FOR DETAILS

ENGINEERS GEOSCIENTISTS MANITOBA
 Certificate of Authorization
 AECOM Canada Ltd.
 No. 4671 Date: 23/11/02

LOCATION APPROVED UNDERGROUND STRUCTURES
 SUPR. U/G STRUCTURES DATE COMMITTEE
 NOTE:
 LOCATION OF UNDERGROUND STRUCTURES AS SHOWN ARE BASED ON THE BEST INFORMATION AVAILABLE. BUT NO GUARANTEE IS GIVEN THAT ALL EXISTING UTILITIES ARE SHOWN OR THAT THE GIVEN LOCATIONS ARE EXACT. CONFIRMATION OF EXISTENCE AND EXACT LOCATION OF ALL SERVICES MUST BE OBTAINED FROM THE INDIVIDUAL UTILITIES BEFORE PROCEEDING WITH CONSTRUCTION.

NO.	REVISIONS	YY/MM/DD	BY
1	ISSUED FOR ADDENDUM #3	23/11/02	ES
0	ISSUED FOR TENDER	23/09/06	ES

AECOM

DESIGNED BY	TB	CHECKED BY	CM
DRAWN BY	ES	APPROVED BY	CM
HOR. SCALE	1:750	RELEASED FOR CONSTRUCTION	
VERT. SCALE	N/A	DATE	

PROFESSIONAL'S SEAL

 CONSULTANT DRAWING NO.

THE CITY OF WINNIPEG WATER AND WASTE DEPARTMENT

2023 SEWER RENEWALS BY CIPP LINING CONTRACT 5 S-MA60022652 EASEMENT (E. OF ST NORBERT COLLEGIATE)

EASEMENT (E OF ST. NORBERT COLLEGIATE) 1ST MH S OF ST THERESE AV TO 2ND MH S OF ST THERESE AVE

SHEET	13	OF	15
CITY DRAWING NUMBER	13373		
REV	1		

AECOM REVIEW DRFT CHK FILE NAME: Saved By:

PLOT DATE:

TENDER No. 599-2023
 CONTRACT NUMBER:

FILE PATH:
 FILE NAME: 60703129_2023_r0.mxd