

<b>DOOR &amp; FRAME ABBREVIATIONS:</b>					
<b>ABBREV</b>	<b>DOOR &amp; FRAME TYPE</b>	<b>SPEC NO</b>	<b>ABBREV</b>	<b>DOOR OPERATIONS</b>	<b>SPEC NO</b>
AL	Aluminum	08 44 13	CA	Card Access (see Electrical)	
HM	Hollow Metal Welded	08 11 00	DA	Double Acting	
X	Existing		HO	Hold Open Device	08 71 00
			PR	Pair	
			<b>ABBREV</b>	<b>DOOR &amp; FRAME FINISHES</b>	
			NFS	Non-Rated Fire Separation	
			P	Paint	09 90 00
			PF	Prefinished	
<b>ABBREV</b>	<b>DOOR PROTECTION</b>	<b>SPEC NO</b>	<b>ABBREV</b>	<b>FRAME PROTECTION</b>	<b>SPEC NO</b>
KP1	Stainless Steel Kickplate, one side, 300 mm high.	08 71 00			

<b>TYPICAL NOTES:</b>	
1.	Doors shall be 900 mm wide unless otherwise noted.
2.	Doors shall be 2135 mm high unless otherwise noted.
3.	Doors shall be 45 mm thickness unless otherwise noted.
4.	Door and frame type shall be hollow metal welded (HM) unless otherwise noted.
5.	Doors and frames shall receive paint finish unless otherwise noted.
6.	Doors shall be Style A unless otherwise noted.
7.	Frames shall be Style 1 unless otherwise noted.
8.	Install door frames 50 mm from adjacent perpendicular wall finish unless otherwise noted; for masonry walls install 100 mm unless otherwise noted.
9.	Kickplates when indicated on one side of door to be on push side, unless otherwise noted.
10.	Coordinate electrical requirements to door frames - refer to electrical drawings.
11.	All interior HM frames shall wrap around wall type indicated (i.e. nominal throat dimension is equal to wall width unless otherwise indicated - refer to drawings)
12.	Set overhead door stop to maximum opening at all concealed door stops (verify with design Contract Administrator before doors are prepared).
13	Refer to drawing sheet A4.1 for aluminum frame types (W#).
<b>REMARKS:</b>	
R1	New door and frame to suit existing opening, confirm dimensions on site.
R2	Existing door to be removed and frame is to be prepped as cased opening.
R3	Refer to Aluminum Frame Styles on Drawing Sheet A4.1.
R4	Paint interior side of door and frame only.
R5	Install kickplate on both doors.
R6	Paint door and frame on Staff Lounge side only.
R7	Refer to Exterior Elevation for paint pattern.
R8	Paint door and frame on Pool Deck side only.

ROOM NAME	DOOR NO	DOOR							FRAME				FIRE RATING	HDWE GROUP	REMARKS
		WIDTH	HEIGHT	THICK	TYPE	FINISH	STYLE	PROT	TYPE	FINISH	STYLE	PROT			
STAFF LOUNGE	B:01	X	X	45	X HM	P	X	X	X HM	P	X	-	-	12	R6
STAFF LOUNGE CLOSET	B:01.1	600	2135	45	HM	P	1	-	HM	P	1	-	-	9	
VESTIBULE 1:01 (Exterior)	1:01.1	PR2000	2135	45	AL	PF	-	-	AL	PF	W1	-	-	1	R3
VESTIBULE 1:01 (Interior)	1:01.2	PR 2000	2135	45	AL	PF	-	-	AL	PF	W2	-	-	2	R3
Bariatric UTR	1:04	1000	2135	45	HM	P	A	KP1	HM	P	1	-	-	3	
UTR	1:06B	1000	2135	45	HM	P	A	KP1	HM	P	1	-	-	3	
CORRIDOR 1:05	1:05	1000	2135	45	AL	PF	-	-	AL	PF	W7	-	-	13	R3
CHLORINE ROOM	1:07	X	X	X	X HM	-	X	-	X HM	-	X	-	X	X	
PRIVATE OFFICE	1:08	950	2135	45	HM	P	B	KP1	HM	P	1	-	-	4	
OPEN OFFICE	1:09A	950	2135	45	HM	P	B	KP1	HM	P	1	-	-	4	
COPY AREA (Lobby side)	1:09B.1	950	2135	45	HM	P	B	KP1	HM	P	1	-	-	5	
COPY Area (Pool Side)	1:09B.2	1000	2135	45	AL	-	-	-	AL	-	W3d	-	-	6	R3
FIRST AID	1:10	1200	2135	45	HM	P	C	KP1	HM	P	1	-	-	7	
MALE CHANGE CORRIDOR 1:12A	1:12A	1000	2135	45	AL	PF	-	-	AL	PF	W7	-	-	13	R3
FEMALE CHANGE CORRIDOR 1:13A	1:13A	1000	2135	45	AL	PF	-	-	AL	PF	W7	-	-	13	R3
POOL DECK	1:14.1	PR 1830	X	P	X HM	P	X	-	X HM	P	X	-	-	X	R4
POOL DECK	1:14.2	PR 1830	X	P	X HM	P	X	-	X HM	P	X	-	-	X	R4
POOL DECK	1:14.3	915	X	P	X HM	P	X	-	X HM	P	X	-	-	X	R4
MPR	1:15	1000	2135	45	AL	PF	-	-	AL	PF	W5b	-	-	8	R3
SAUNA	1:16B	1000	2135	45	AL	PF	-	-	AL	PF	W6	-	-	8	R3
JANITORIAL	1:17A	PR 1830	2020	45	HM	P	A	KP1	HM	P	1	-	45 MIN	10	R5
ELECTRICAL	1:17B	900	2135	45	HM	P	A	-	HM	P	1	-	45 MIN	11	

ROOM NAME	DOOR NO	DOOR							FRAME				FIRE RATING	HDWE GROUP	REMARKS
		WIDTH	HEIGHT	THICK	TYPE	FINISH	STYLE	PROT	TYPE	FINISH	STYLE	PROT			
X STAIR ST-1 (Interior)	ST-1	X 915	X	X	X HM	P	C	X	X HM	P	1	-	X	12	
X STAIR ST-1 (Exterior)	ST-1.1	X 915	X	X	X HM	P	C	X	X HM	P	1	-	X	X	R7
X STAIR ST-2 (Interior)	ST-2	900	2135	45	X HM	P	A	-	X HM	P	1	-	X	X	R8
X STAIR ST-1 (Exterior)	ST-2.1	X 915	X	X	X HM	-	C	X	X HM	-	1	-	X	X	
***															


**END OF SECTION**

# DOOR STYLES

1 : 50

**NOTES:**

1. GLAZING (GL) IN NEW DOORS TO BE TEMPERED UNLESS OTHERWISE NOTED.
2. REFER TO DOOR SCHEDULE FOR NEW AND EXISTING DOOR MATERIAL.
3. DOOR STYLES GIVEN TO EXISTING DOORS ARE REPRESENTATIVE ONLY OF THEIR STYLE. DIMENSIONS SHOWN MAY NOT APPLY.

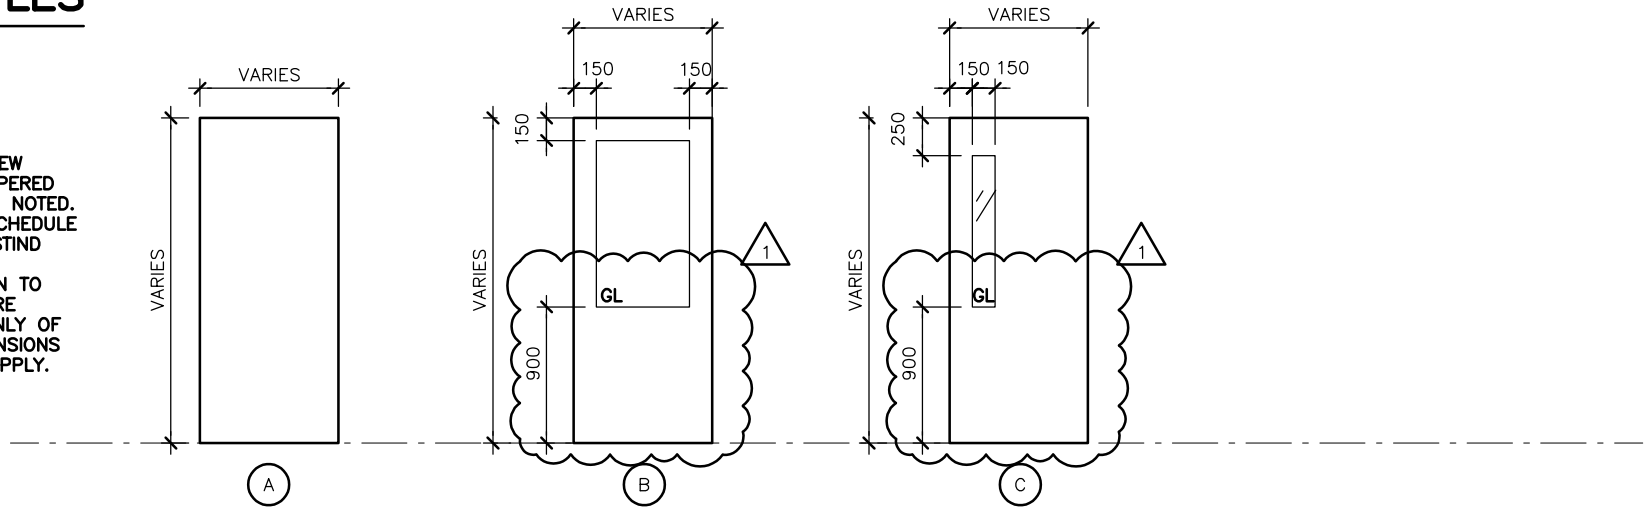

# FRAME STYLES

1 : 50

**NOTES:**

1. REFER TO DOOR SCHEDULE AND SPECIFICATIONS FOR FRAME MATERIAL.

