

Copyright Reserved
 The Contractor shall verify and be responsible for all dimensions.
 DO NOT scale the drawing - any errors or omissions shall be reported
 to Stantec without delay.
 The Copyrights to all designs and drawings are the property of Stantec.
 Reproduction or use for any purpose other than that authorized by
 Stantec is forbidden.

Client

Legend

Notes

1	ISSUED FOR ADDENDUM #5	CB	AA	24.01.11
Revision		By	Appd.	YY.MM.DD

0	ISSUED FOR CONSTRUCTION	IS	AH	23.09.18
Issued		By	Appd.	YY.MM.DD

File Name:	115423001.s-101m	CB	AH	IS	22.05.27
		Dwn.	Chkd.	Dsgn.	YY.MM.DD

Permit-Seal

ORIGINAL
 DRAWING
 SEALED BY
 B. E. FRASER
 MEMBER
 23402
 Stantec Consulting Ltd.
 2023-09-20


**ENGINEERS
 GEOSCIENTISTS
 MANITOBA**
 Certificate of Authorization
 Stantec Consulting Ltd.
 No. 1301

Client/Project
 WINNIPEG TRANSIT DIRECT CURRENT FAST
 CHARGING BUS STATIONS BRANDON GARAGE


600 Brandon Ave. Winnipeg, Manitoba

Title
 STRUCTURAL DETAILS


Project No. 144523001	Scale As Indicated
Drawing No. S-101	Sheet 1 of 1
	Revision 1

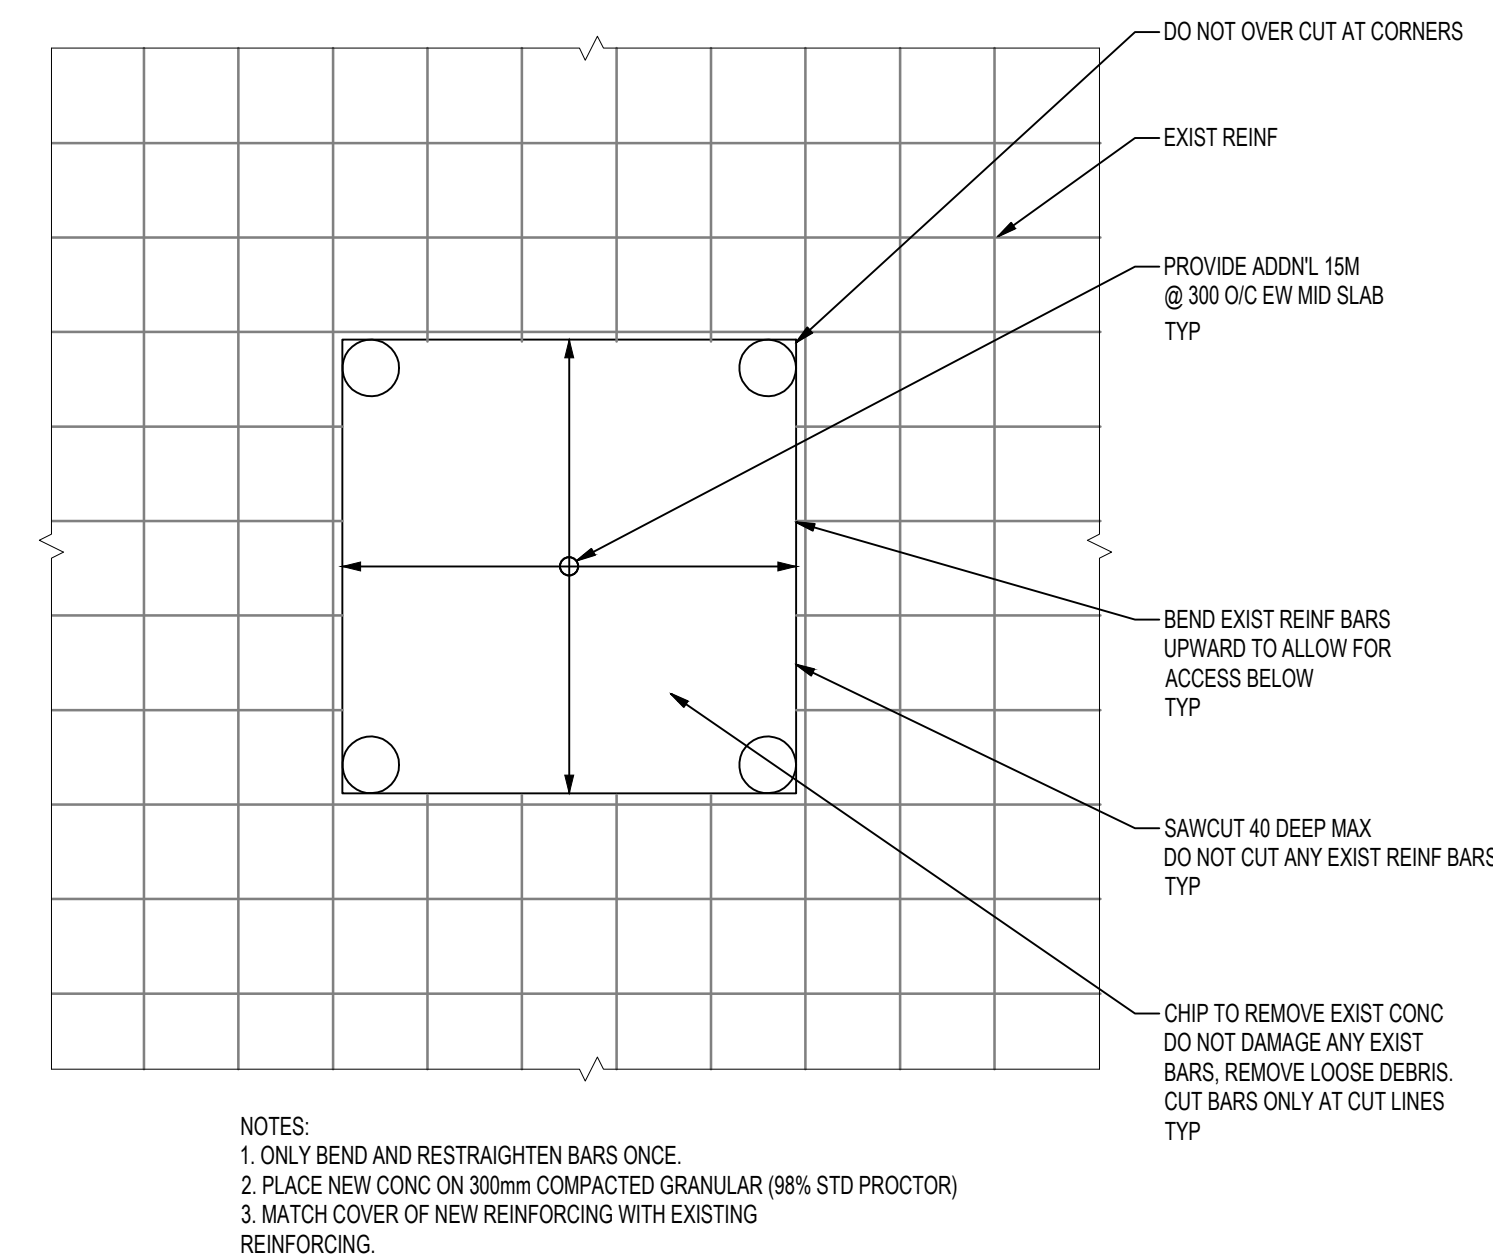


1 SLAB REINSTATEMENT PLAN DETAIL
 S-101 NTS

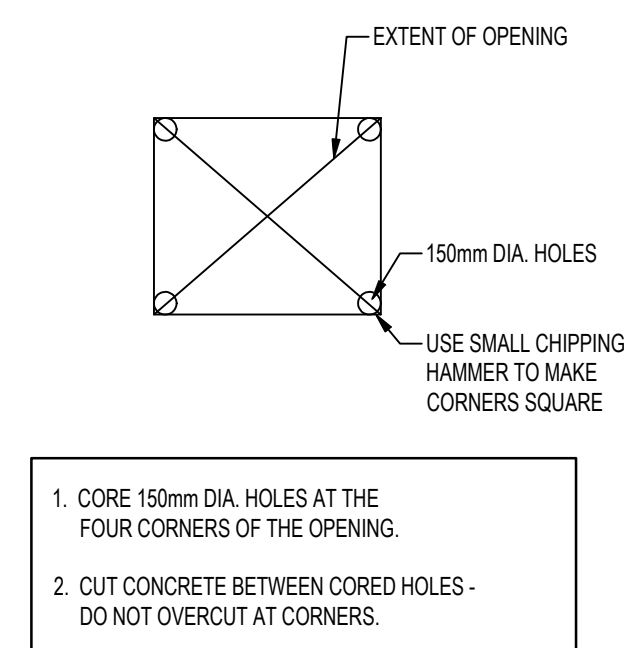

2 CUT INTO EXIST SLAB DETAIL
 S-101 NTS

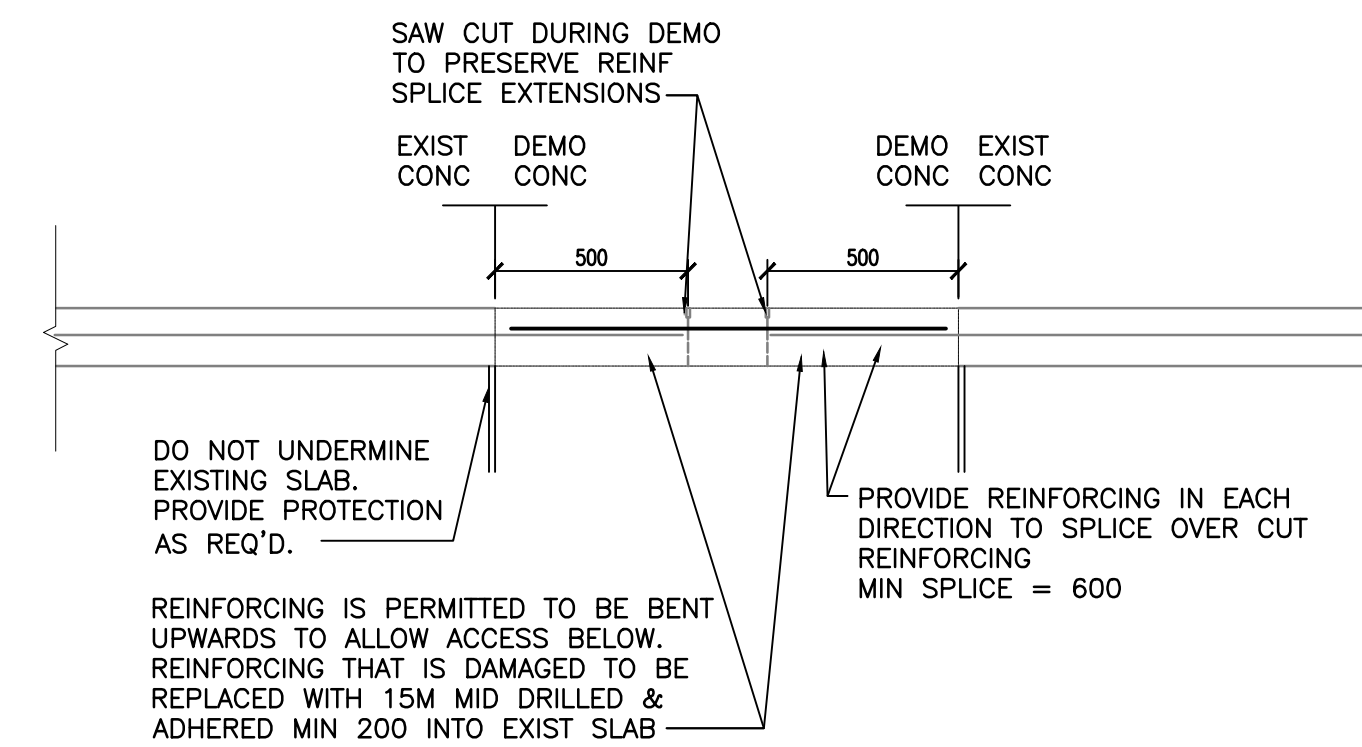

3 TYPICAL SLAB CUT / REPAIR SECTION
 S-101 NTS

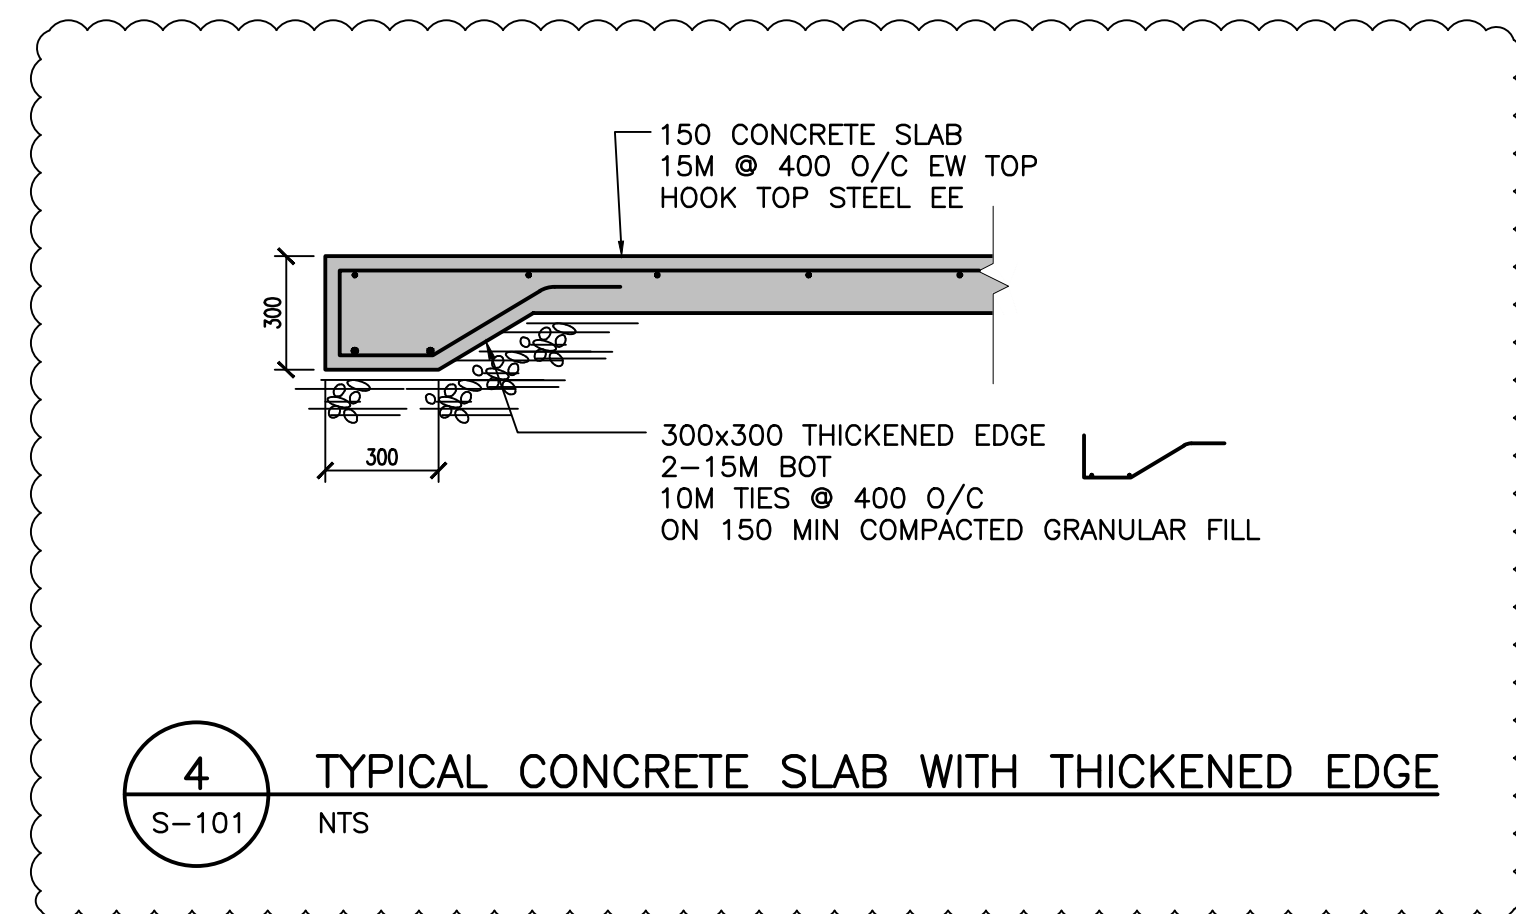

4 TYPICAL CONCRETE SLAB WITH THICKENED EDGE
 S-101 NTS