


- NOTES:**
- ISOLATE AND TAPE BACK SHIELD AT THIS END ONLY.
 - UTILIZE EXISTING CABLE B6 AND B7 FOR DIGITAL SIGNALS AND CABLE B4 FOR ANALOG SIGNALS BETWEEN TERMINATION CABINET BTC-1 AND BAILEY DCS CABINET.
 - EXISTING SPARE FIELD TERMINAL BLOCKS. CONFIRM TERMINAL NUMBER ON SITE.
 - EXISTING 24VDC TERMINAL BLOCKS. PROVIDE NEW FUSE AS REQUIRED. CONFIRM TERMINAL NUMBER ON SITE.
 - PROVIDE NEW WIRING.

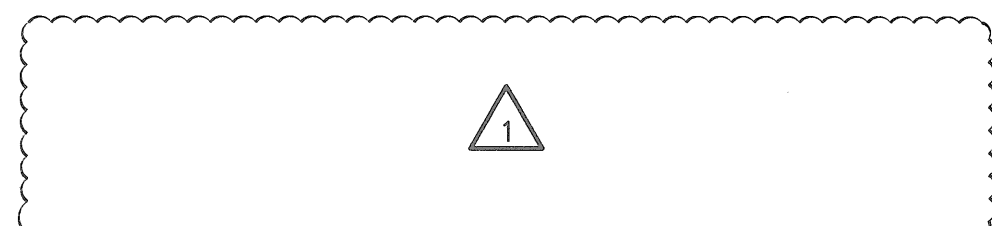

| 10 | --- | --- |
|--------------------|----------------|-------------------------|
| 9 | --- | --- |
| 8 | --- | --- |
| 7 | --- | --- |
| 6 | --- | --- |
| 5 | --- | --- |
| 4 | --- | --- |
| 3 | --- | --- |
| 2 | --- | --- |
| 1 | --- | --- |
| NO. | DRAWING NUMBER | REFERENCE DRAWING TITLE |
| REFERENCE DRAWINGS | | |

TEMPORARY

| B.M. ELEV. | | | |
|--|----------------------------|------------|----|
| CONSTRUCTION COMPLETION DATE: YYYY MM DD | | | |
| DESIGNED BY | TB | | |
| CHECKED BY | DDW | | |
| DRAWN BY | DIS | | |
| APPROVED BY | TB | | |
| SCALE: | AS SHOWN | | |
| RELEASED FOR CONSTRUCTION | | | |
| NO. | REVISIONS | DATE | BY |
| 1 | RE-ISSUED FOR CONSTRUCTION | 2023 10 18 | TB |
| 0 | ISSUED FOR CONSTRUCTION | 2023 10 05 | TB |

KGS GROUP

DESIGNED BY: TB | CHECKED BY: DDW
 DRAWN BY: DIS | APPROVED BY: TB
 SCALE: AS SHOWN | RELEASED FOR CONSTRUCTION

DATE: 2023 09 20 | DATE: _____

ENGINEER'S SEAL

2023-10-18
 CONSULTANT DRAWING NUMBER: 23-0107-010_A1.01

THE CITY OF WINNIPEG
 WATER AND WASTE DEPARTMENT
 ENGINEERING DIVISION

NORTH END SEWAGE TREATMENT PLANT (NEWPCC)
 INTERIM BACKUP BOILER SYSTEM
 AREA B - BOILER ROOM

AUTOMATION LOOP DRAWING
 AIT-B503 CO ALARM INDICATING TRANSMITTER

CITY DRAWING NUMBER: --- | SHEET 1 OF 1

**ENGINEERS
 GEOSCIENTISTS
 MANITOBA**

Certificate of Authorization
 KGS Group
 No. 245