


**NOTES:**

- ISOLATE AND TAPE BACK SHIELD AT THIS END ONLY.
- UTILIZE EXISTING CABLE B6 AND B7 FOR DIGITAL SIGNALS AND CABLE B4 FOR ANALOG SIGNALS BETWEEN TERMINATION CABINET BTC-1 AND BAILEY DCS CABINET.
- EXISTING ANALOG INPUT TERMINALS. CONFIRM TERMINAL NUMBER ON SITE.

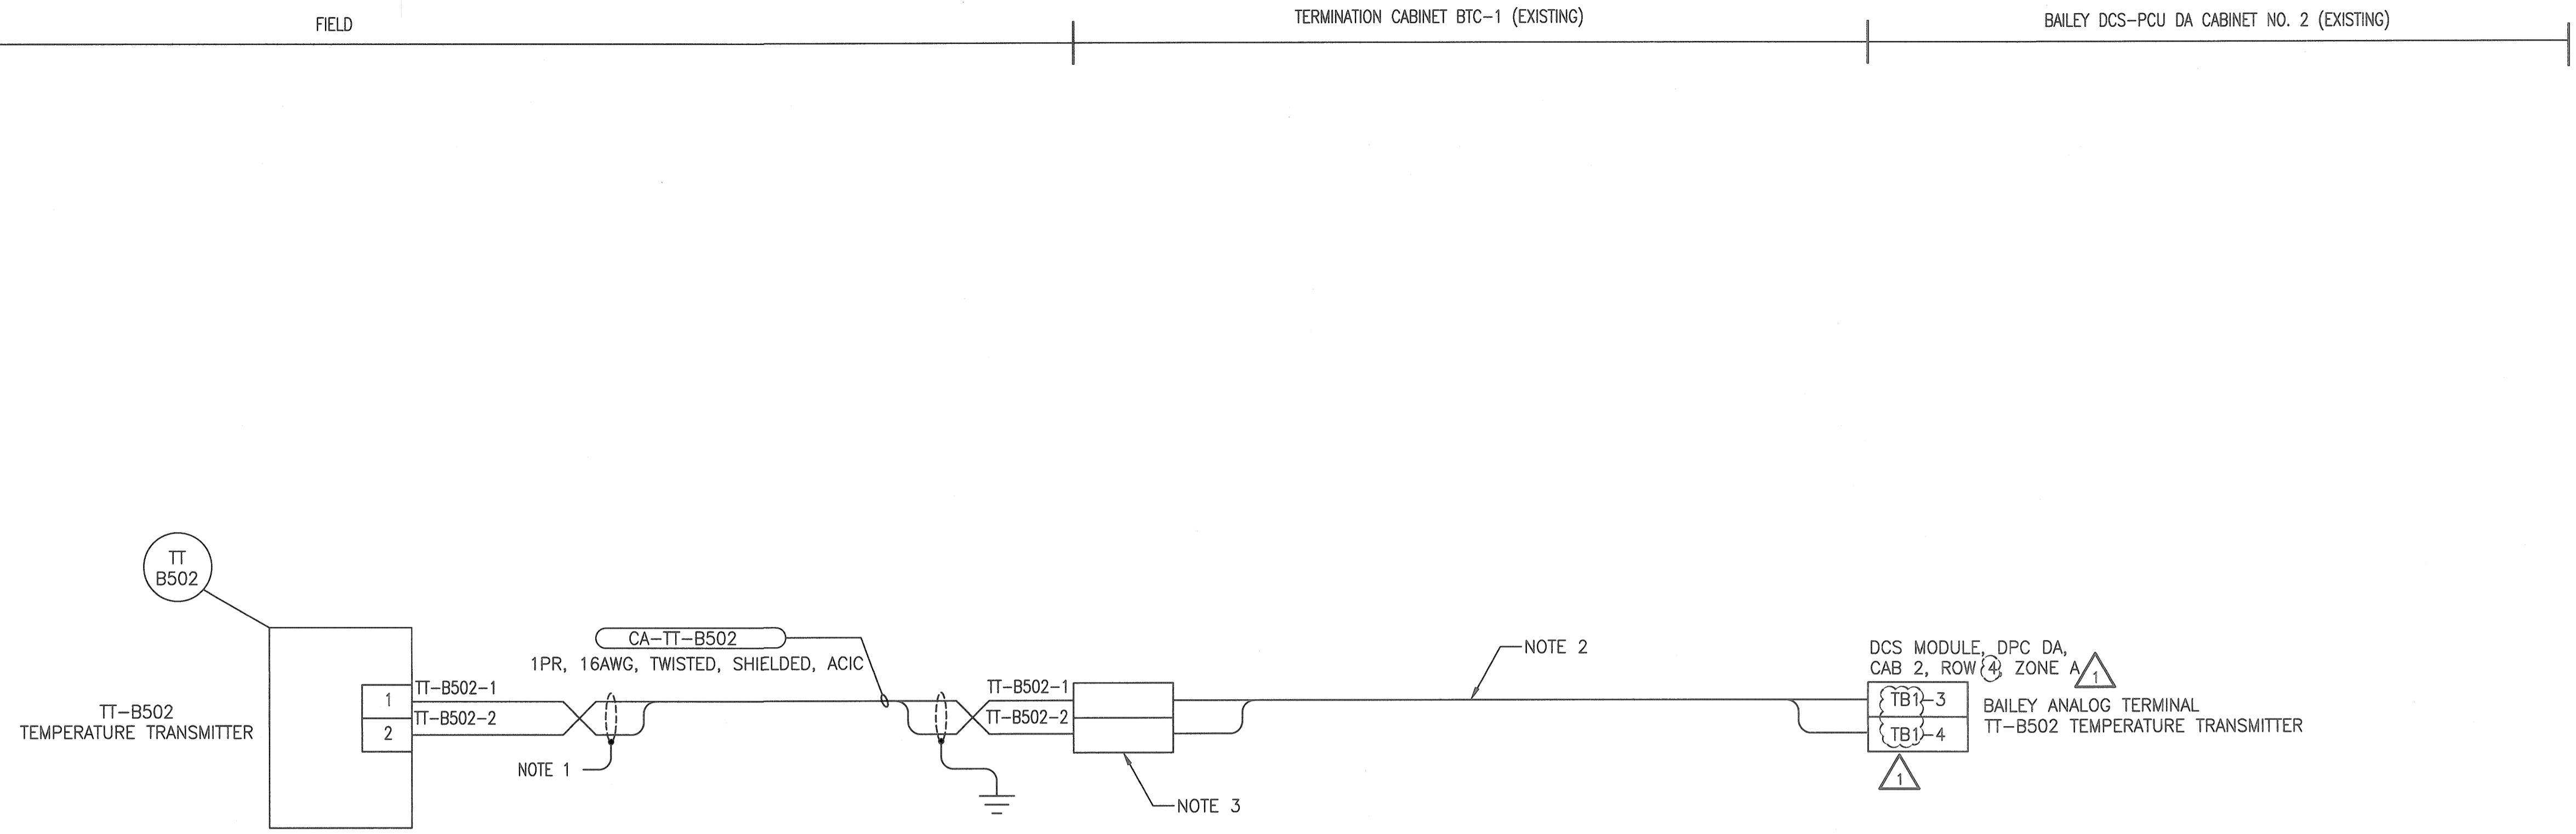

10	--	--
9	--	--
8	--	--
7	--	--
6	--	--
5	--	--
4	--	--
3	--	--
2	23-0107-010_E1.01	AREA B - BOILER ROOM ELECTRICAL EQUIPMENT LAYOUT
1	23-0107-010_ED.01	AREA B - BOILER ROOM PANEL BOARD SCHEDULE
NO.	DRAWING NUMBER	REFERENCE DRAWING TITLE
REFERENCE DRAWINGS		

TEMPORARY

B.M. ELEV.			
CONSTRUCTION COMPLETION DATE: YYYY MM DD			
NO.	REVISIONS	DATE	BY
1	RE-ISSUED FOR CONSTRUCTION	2023 10 18	TB
0	ISSUED FOR CONSTRUCTION	2023 10 05	TB

<b>KGS GROUP</b>	
DESIGNED BY	TB
CHECKED BY	DDW
DRAWN BY	FA
APPROVED BY	TB
SCALE:	AS SHOWN
RELEASED FOR CONSTRUCTION	
DATE	2023 10 02
PLOT DATE:	2023 10 18

ENGINEER'S SEAL

CONSULTANT DRAWING NUMBER  
23-0107-010\_A1.05

**Winnipeg**

THE CITY OF WINNIPEG  
WATER AND WASTE DEPARTMENT  
ENGINEERING DIVISION

NORTH END SEWAGE TREATMENT PLANT (NEWPCC)  
INTERIM BACKUP BOILER SYSTEM  
AREA B - BOILER ROOM  
AUTOMATION LOOP DRAWING  
TT-B502 TEMPERATURE TRANSMITTER

CITY DRAWING NUMBER: -- SHEET 1 OF 1

ENGINEERS  
GEOSCIENTISTS  
MANITOBA

Certificate of Authorization  
KGS Group  
No. 245