

MATERIALS

COMPOSITE SLATS:
- 89mm x 89mm COMPOSITE BOARDS
- CEDAR TONE FINISH

METAL OPTIONS:


- GALVANIZED - Product # 52501085GLV

Drawing Title:


**TACHE BENCH COMPOSITE
WITH ARMS**

Drawing No:

SCD-121A

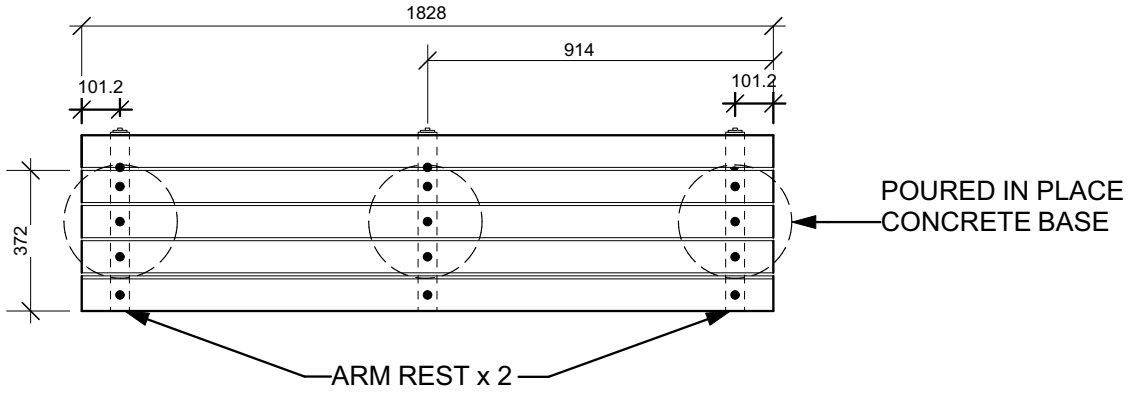

PLAN VIEW

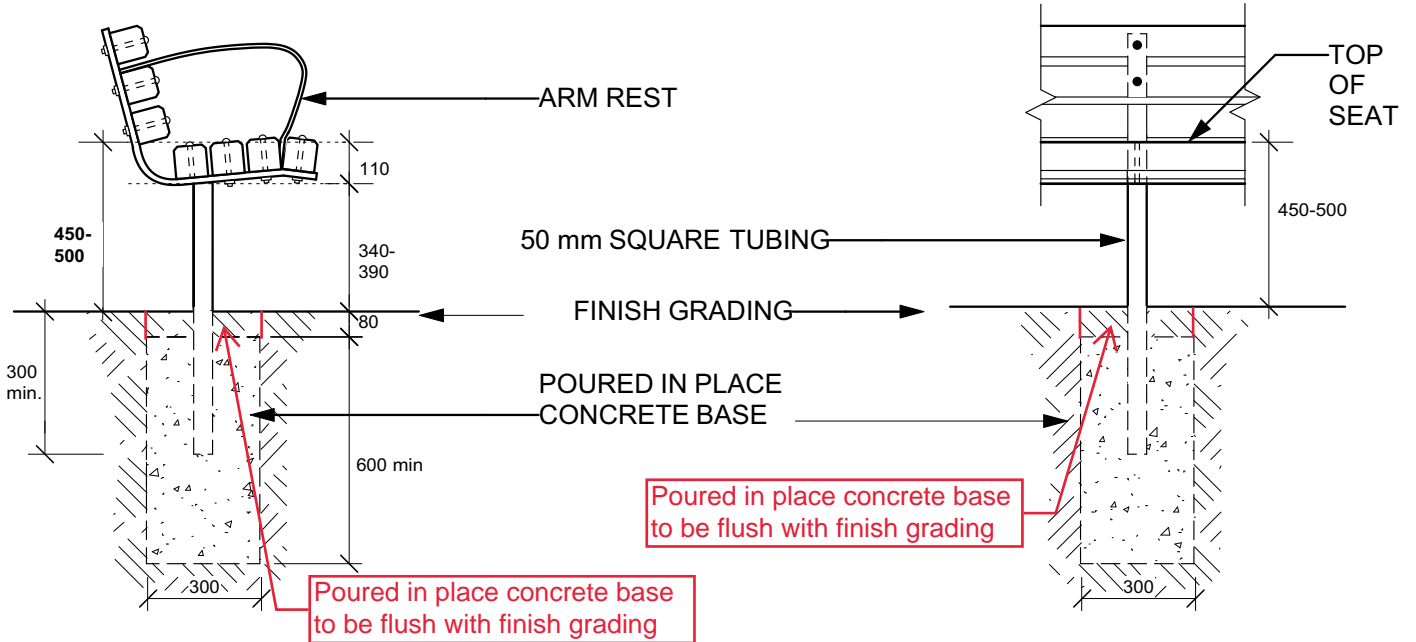

SIDE ELEVATION

FRONT ELEVATION

DIMENSIONS SHOWN ARE IN MILLIMETRES UNLESS OTHERWISE SPECIFIED

REVISION: 3
DATE: August 06, 2020
SCALE: NTS
DRAWN BY: GZ

The City of Winnipeg
Planning, Property and Development Department
Planning and Land Use Division
Unit 15 - 30 Fort Street, Winnipeg, MB, R3C 4X5

