




400 - 136 Market Avenue  
Winnipeg, MB R3B 0P4  
T 204 453 1080

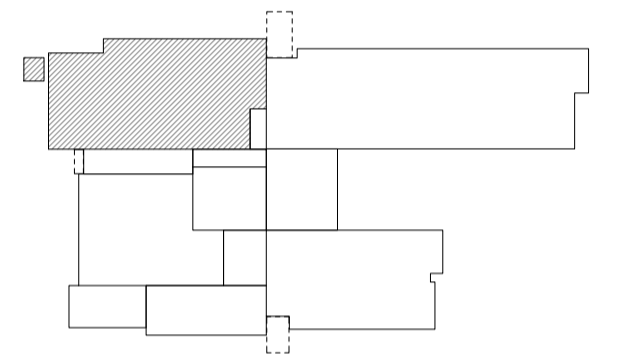

**BUILDING KEYPLAN - MAIN**

SCALE 1 : 2000



LM Architectural Group | Environmental Space Planning  
500-136 Market Avenue Winnipeg, Manitoba Canada R3B 0P4  
t: 204.942.0681 lm-esp.ca

1	ADDENDUM_2-DRAWING_MF2.1-R1		24-04-25
0	ISSUED FOR CONSTRUCTION	JS/MP	24-04-01
No.	REVISION/DESCRIPTION	BY	DATE

SEAL



RC DRAWN	JS CHECKED	JS DESIGNED	JS APPROVED
DATE 2024-04-25	USER APPROVAL		

THE CITY OF WINNIPEG  
ASSETS & PROJECT MANAGEMENT  
DEPARTMENT  
MUNICIPAL ACCOMMODATIONS DIVISION  
3-65 GARRY STREET, R3C 4K4

PROJECT  
**PEMBINA TRAILS COLLEGIATE  
VOCATIONAL WING**  
TENDER NO. 954-2023B  
50 FRONTIER TRAIL, WINNIPEG, MANITOBA, R3Y 2H1

SHEET TITLE  
**Underslab/Crawlspace West Vocational  
Wing - Fire Protection Plan**

SCALE As indicated	PROJECT No: 2020-127	SHEET No: MF2.1-R1
-----------------------	-------------------------	-----------------------

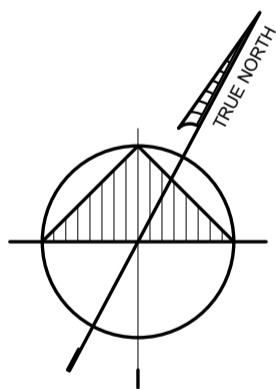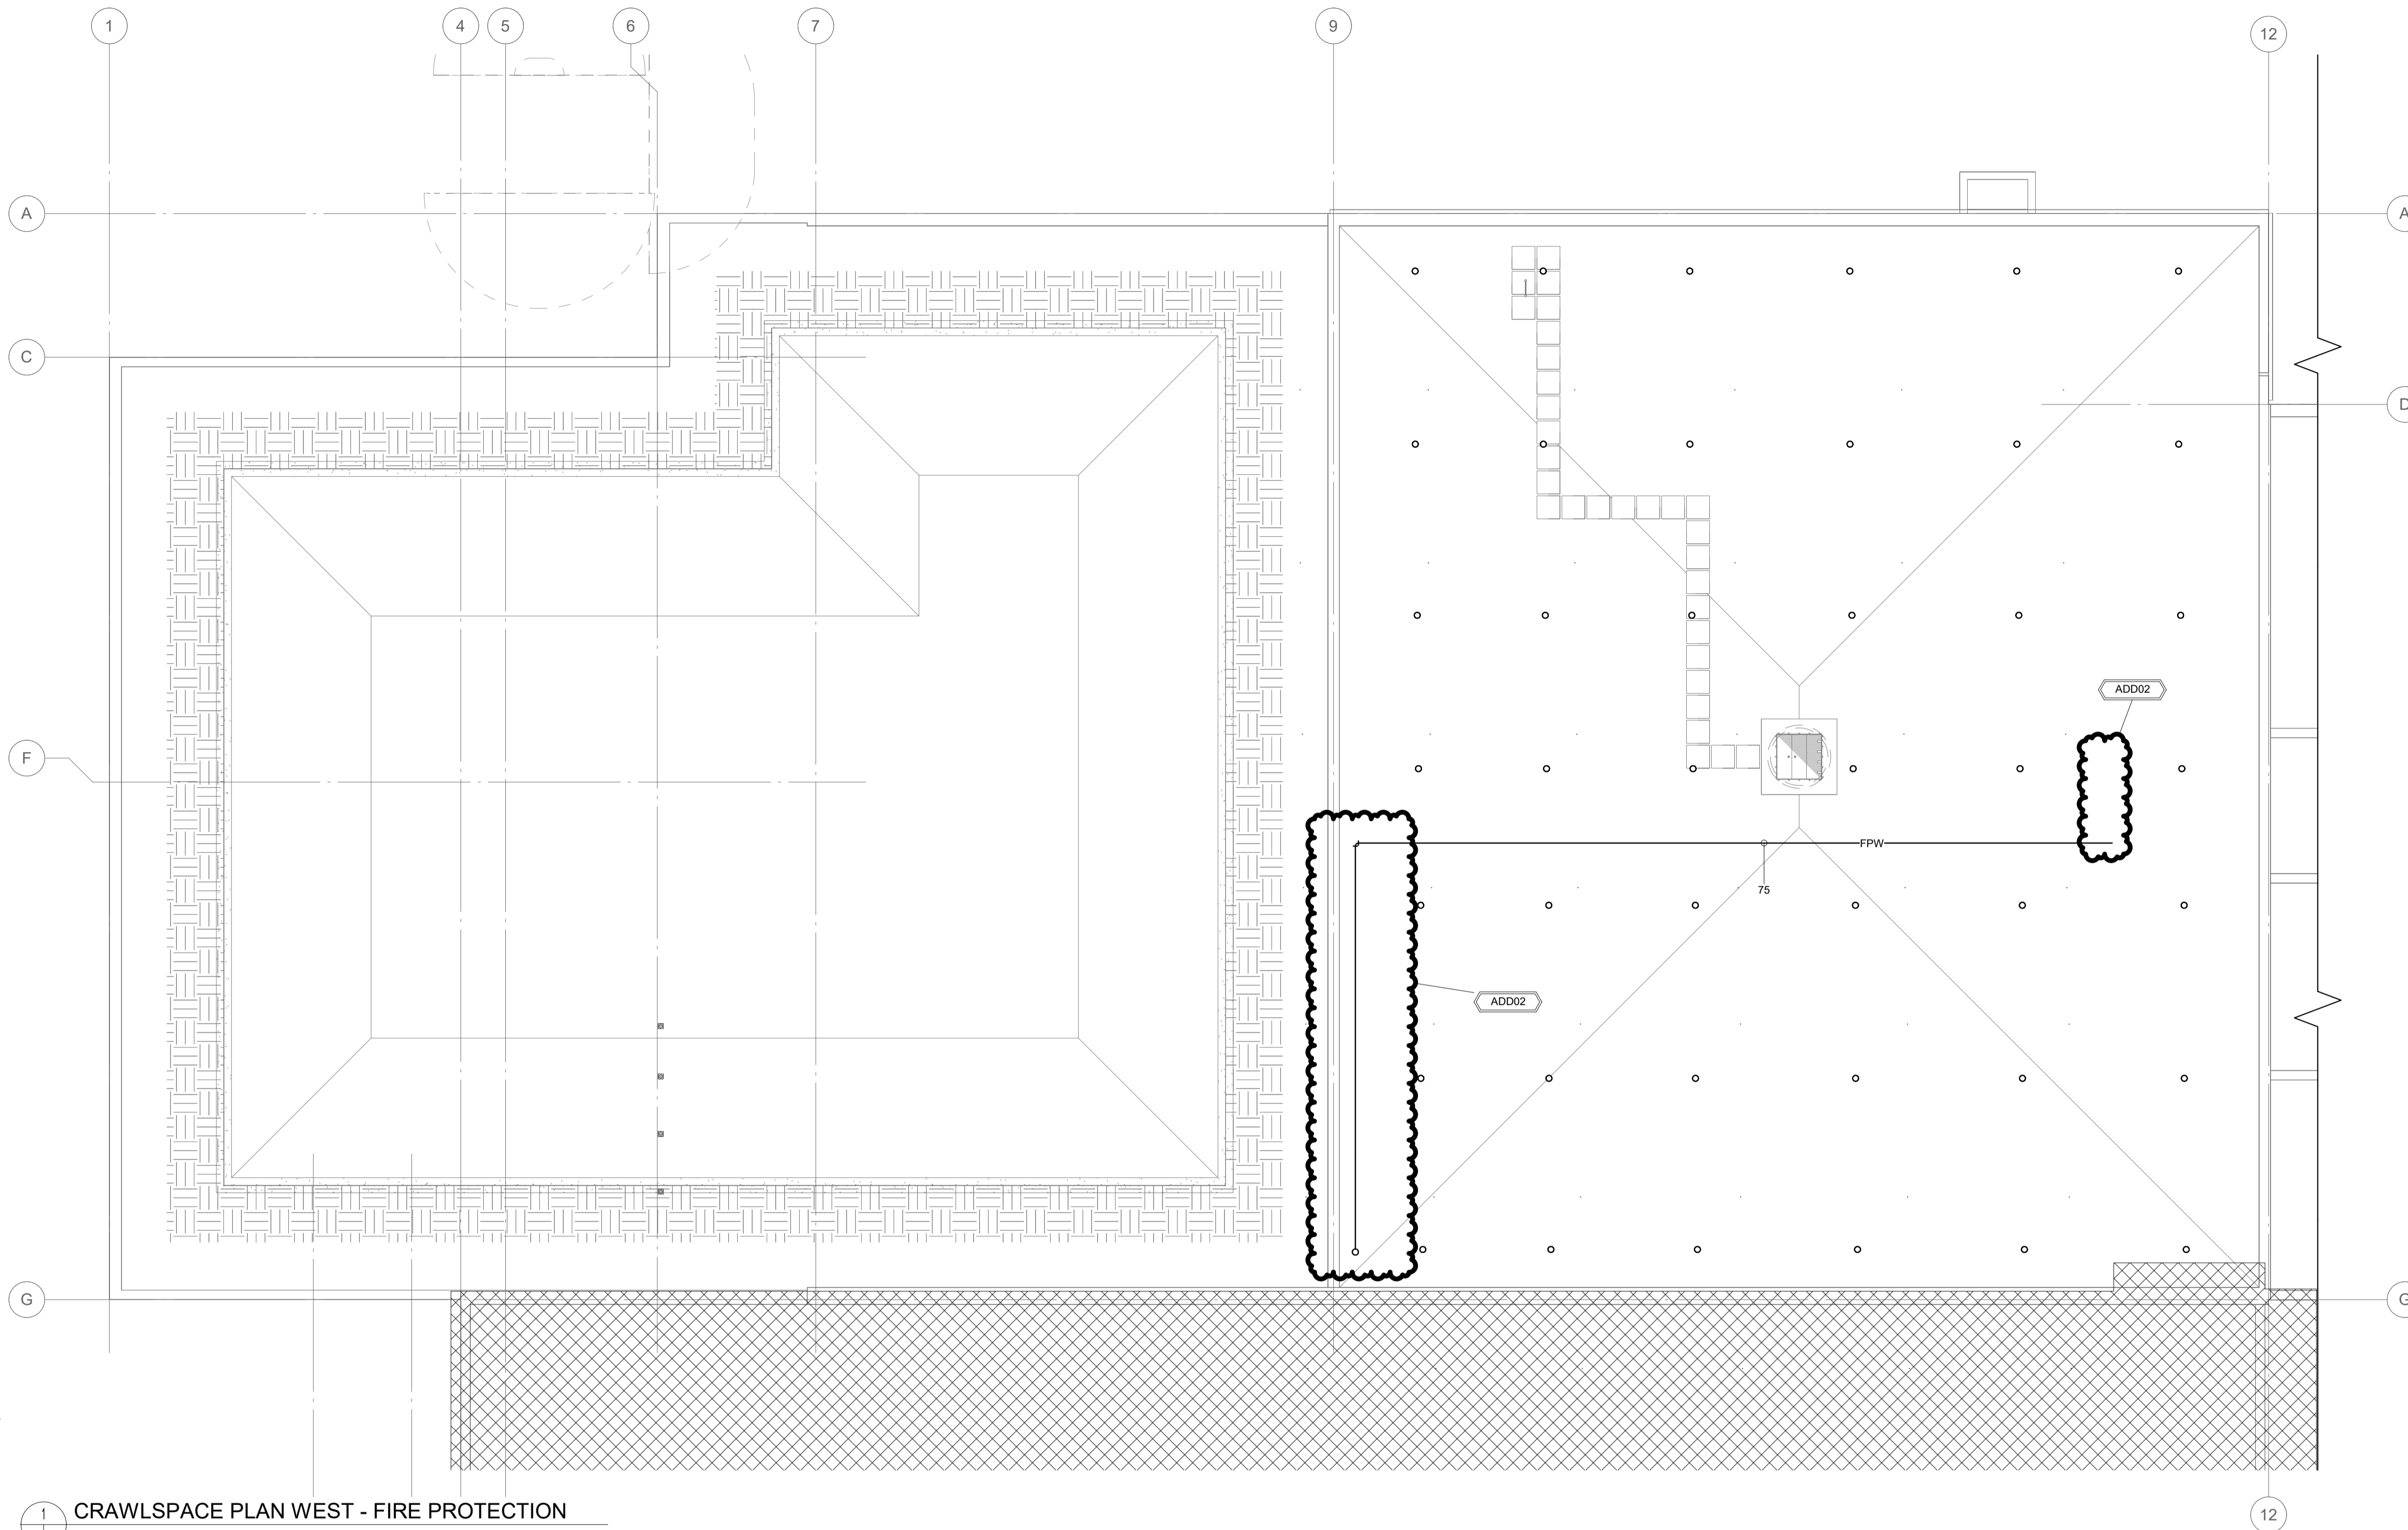

**CRAWLSPACE PLAN WEST - FIRE PROTECTION**

SCALE 1 : 100