

- KEY NOTES**
- 1 ZONE 6: WELDING/MACHINIST
 - 2 ZONE 8: VOCATIONAL MEZZANINE.
 - 3 ZONE 7: WOOD CONSTRUCTION
 - 4 ZONE 5: CULINARY ARTS AND CRAWLSPACE.
 - 5 MULTI-PURPOSE DRY CHEMICAL FIRE EXTINGUISHER WITH MINIMUM WEIGHT OF 4.5 KG WITH K RATINGS FOR KITCHENS. LOCATE IN RECESSED CABINET. COMPLY WITH NFPA 10 FOR INSTALLATION REQUIREMENTS.
 - 6 MULTI-PURPOSE DRY CHEMICAL FIRE EXTINGUISHER WITH MINIMUM WEIGHT OF 4.5 KG. LOCATE ON WALL HOOK. COMPLY WITH NFPA 10 FOR INSTALLATION REQUIREMENTS.
 - 7 MULTI-PURPOSE DRY CHEMICAL FIRE EXTINGUISHER WITH MINIMUM WEIGHT OF 2.2 KG. LOCATE IN RECESSED CABINET. COMPLY WITH NFPA 10 FOR INSTALLATION REQUIREMENTS.
 - 8 PROVIDE TAIL END DRY PENDANT HEAD WITHIN WALK-IN COOLER/FREEZER.
 - 9 CONNECT NEW SPRINKLER ZONE PIPING TO EXISTING PIPING WITHIN CEILING.

GENERAL: REFER TO MECHANICAL SYMBOL SHEET FOR HATCHING KEY.




400 - 136 Market Avenue
Winnipeg, MB R3B 0P4
T 204 453 1080

BUILDING KEYPLAN - MAIN
SCALE 1:2000



LM Architectural Group | Environmental Space Planning
500-136 Market Avenue Winnipeg, Manitoba Canada R3B 0P4
t: 204.942.0681 lm-esp.ca

1	ADDENDUM_2-DRAWING_MF2.2-R1	24-04-25
0	ISSUED FOR CONSTRUCTION	JS MP 24-04-01
No.	REVISION/DESCRIPTION	BY DATE

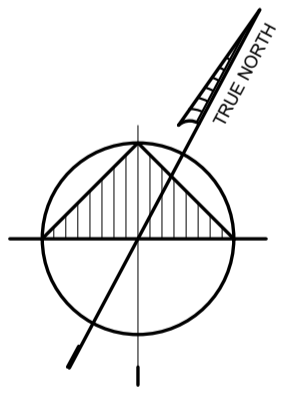

1 MAIN FLOOR PLAN WEST - FIRE PROTECTION
SCALE 1:100

RC DRAWN	JS CHECKED	JS DESIGNED	JS APPROVED
DATE USER APPROVAL			
2024-04-25			

THE CITY OF WINNIPEG
ASSETS & PROJECT MANAGEMENT
DEPARTMENT
MUNICIPAL ACCOMMODATIONS DIVISION
3-65 GARRY STREET, R3C 4K4

PROJECT
**PEMBINA TRAILS COLLEGIATE
VOCATIONAL WING**
TENDER NO. 954-2023B
50 FRONTIER TRAIL, WINNIPEG, MANITOBA, R3Y 2H1

SHEET TITLE
**Main Floor West Vocational Wing - Fire
Protection Plan**

SCALE	PROJECT No:	SHEET No:
As indicated	2020-127	MF2.2-R1