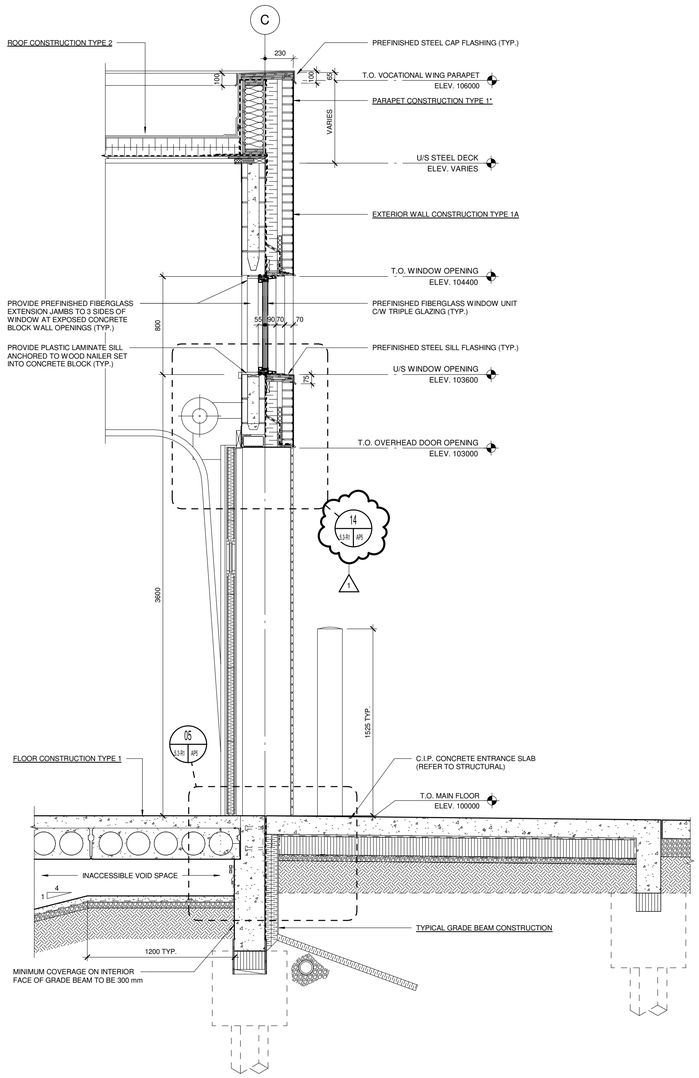

1

5R1
1
L1R
SR/
TYPICAL SECTION THRU OVERHEAD DOOR
SCALE 1 : 25

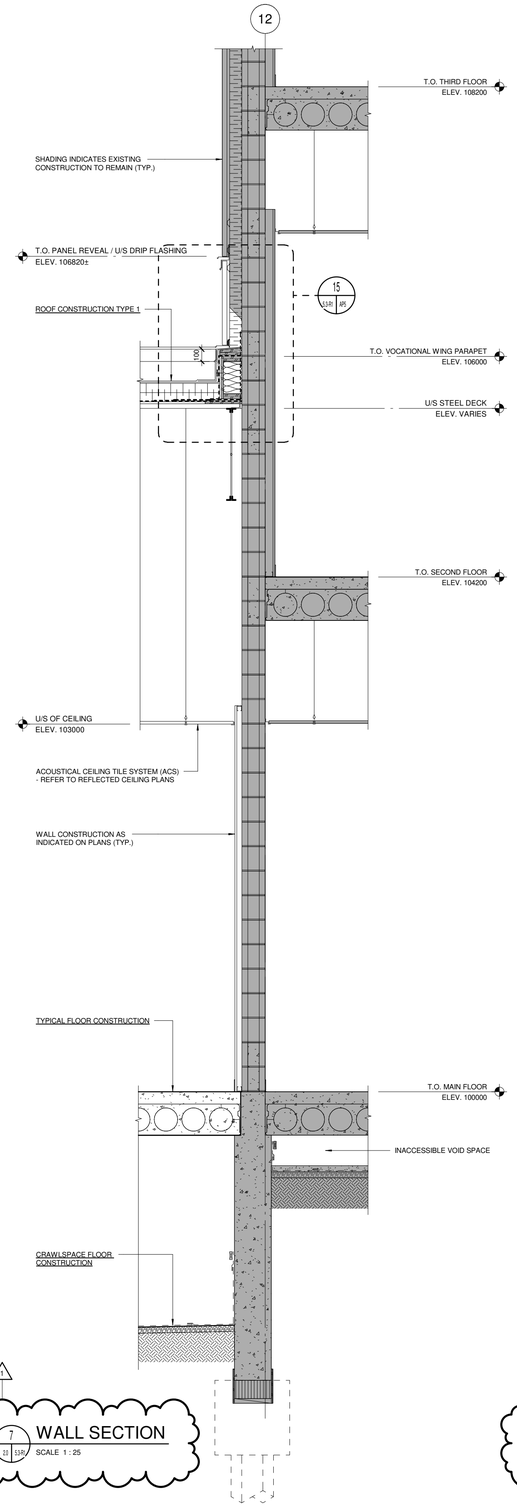

1

7
L1R
SR/
WALL SECTION
SCALE 1 : 25

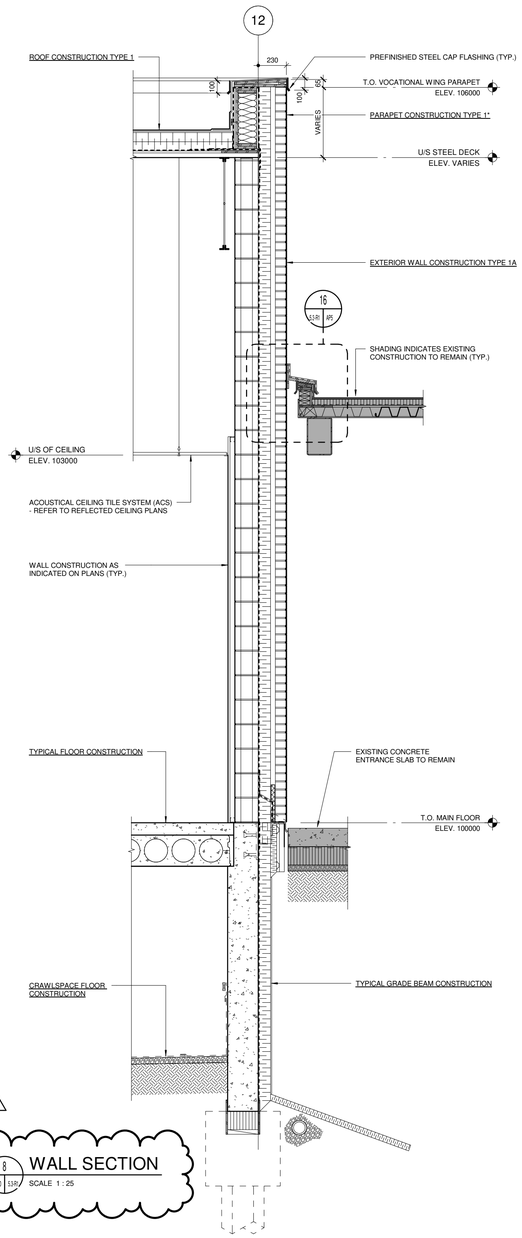

1

8
L1R
SR/
WALL SECTION
SCALE 1 : 25

LM esp
LM Architectural Group | Environmental Space Planning
500-136 Market Avenue Winnipeg, Manitoba Canada R3B 0P4
t: 204.942.0681 lm-esp.ca

No.	REVISION/DESCRIPTION	BY	DATE
1	ADDENDUM_4–DRAWING_A5.3–R1	JT	05.06.24
0	ISSUED FOR CONSTRUCTION	JT	04.01.24

SEAL

RS DRAWN	HW CHECKED	RS DESIGNED	JT APPROVED
DATE 2024.05.06	USER APPROVAL		

Winnipeg

THE CITY OF WINNIPEG
ASSETS & PROJECT MANAGEMENT DEPARTMENT
MUNICIPAL ACCOMMODATIONS DIVISION
3–65 GARRY STREET, R3C 4K4

PROJECT

PEMBINA TRAILS COLLEGIATE VOCATIONAL WING TENDER NO. 954-2023B

50 FRONTIER TRAIL, WINNIPEG, MANITOBA, R3Y 2H1

SHEET TITLE

WALL SECTION 6

SCALE	PROJECT No:	SHEET No:
1 : 25	2020-127	A5.3-R1