

Appendix A

Change Diagrams



Winnipeg Transit



TENDER 1026-2024


Reference E3.3 | Metal Signage Updates (small poles)

TENDER 1026-2024

APPROXIMATE QUANTITY
2300

ACTIVITY LOG

- a Remove current double-sided signage (2 metal plates)
- b Add sticker to new signage stating "Service begins June 29th, 2025"
- c Install new double-sided signage in location of old signage (2 metal plates)
- d Complete site survey

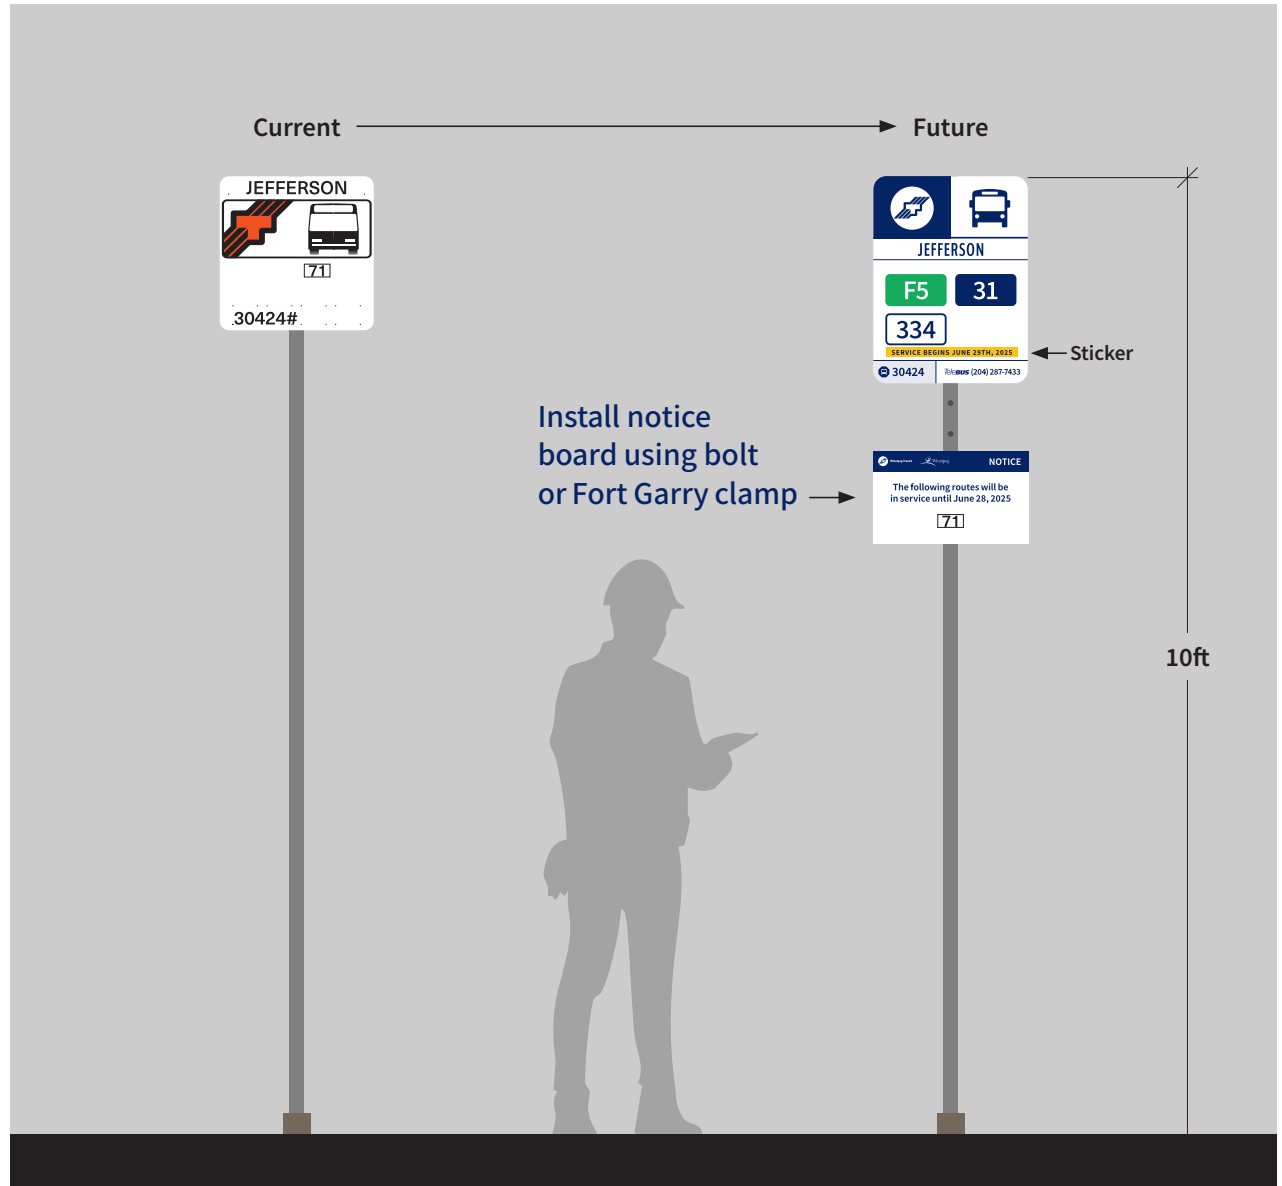


Reference E3.4 | Metal Signage Updates (large poles)

APPROXIMATE QUANTITY

520

ACTIVITY LOG


- a Remove current double-sided signage (2 metal plates)
- b Add sticker to new signage stating "Service begins June 29th, 2025"
- c Install new double-sided signage in location of old signage (2 metal plates)
- d Complete site survey

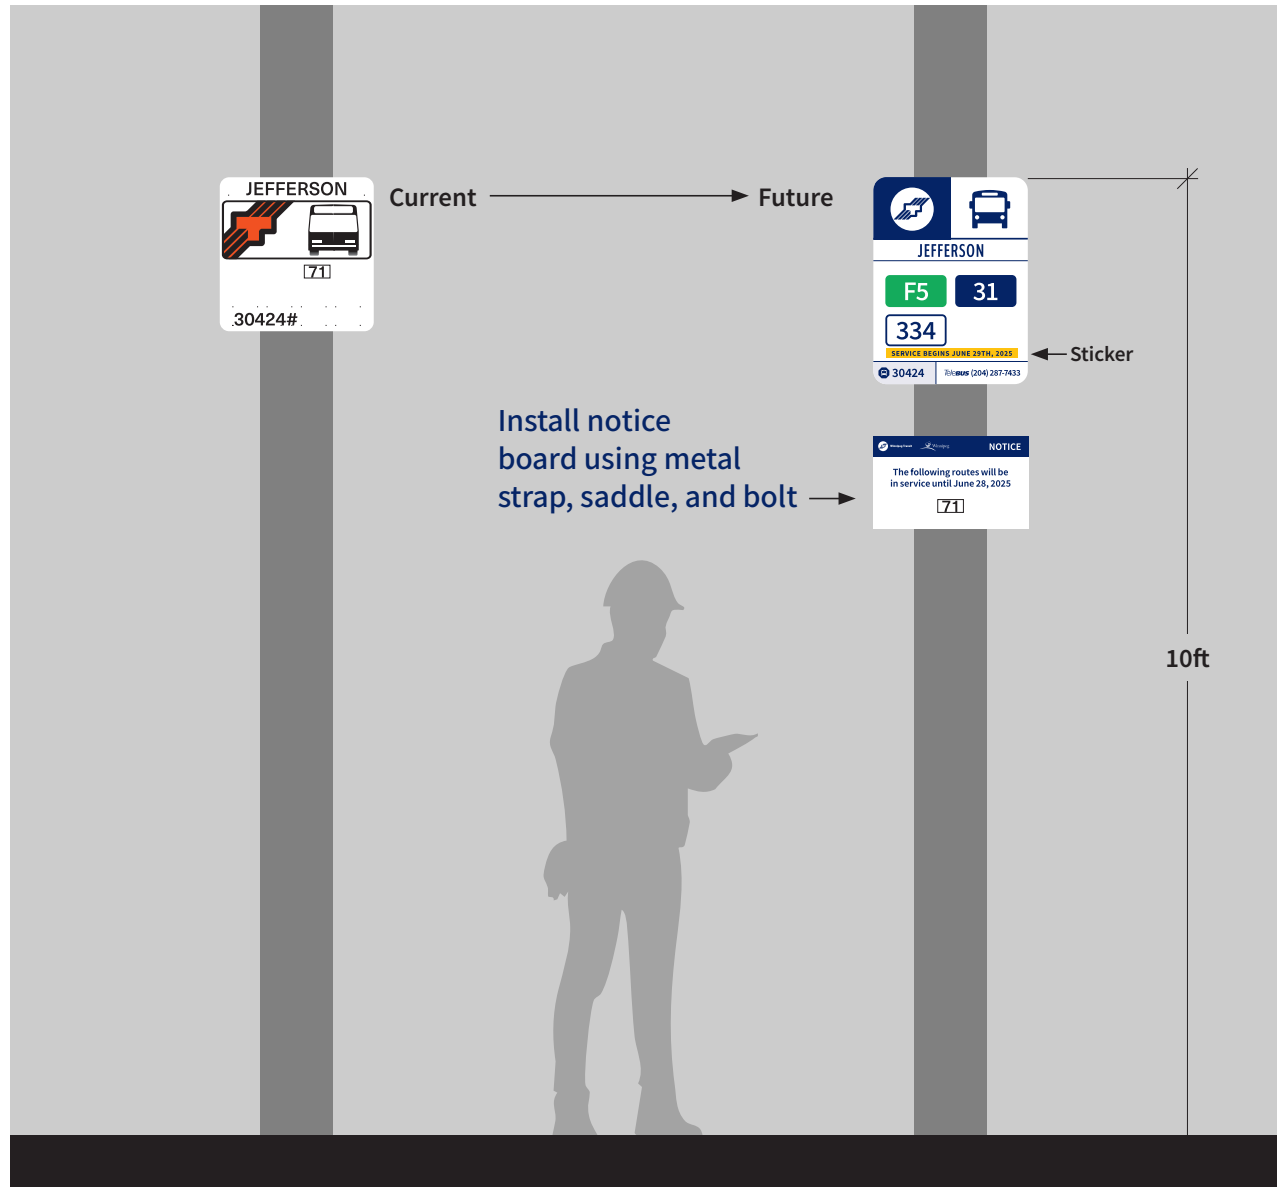

APPROXIMATE QUANTITY
190

ACTIVITY LOG

- a Remove current route tiles from both sides of sign
- b Install new route tiles on both sides of sign
- c Add sticker to new signage stating “Service begins June 29th, 2025”
- d Install temporary notice board using small screw
- e Complete site survey

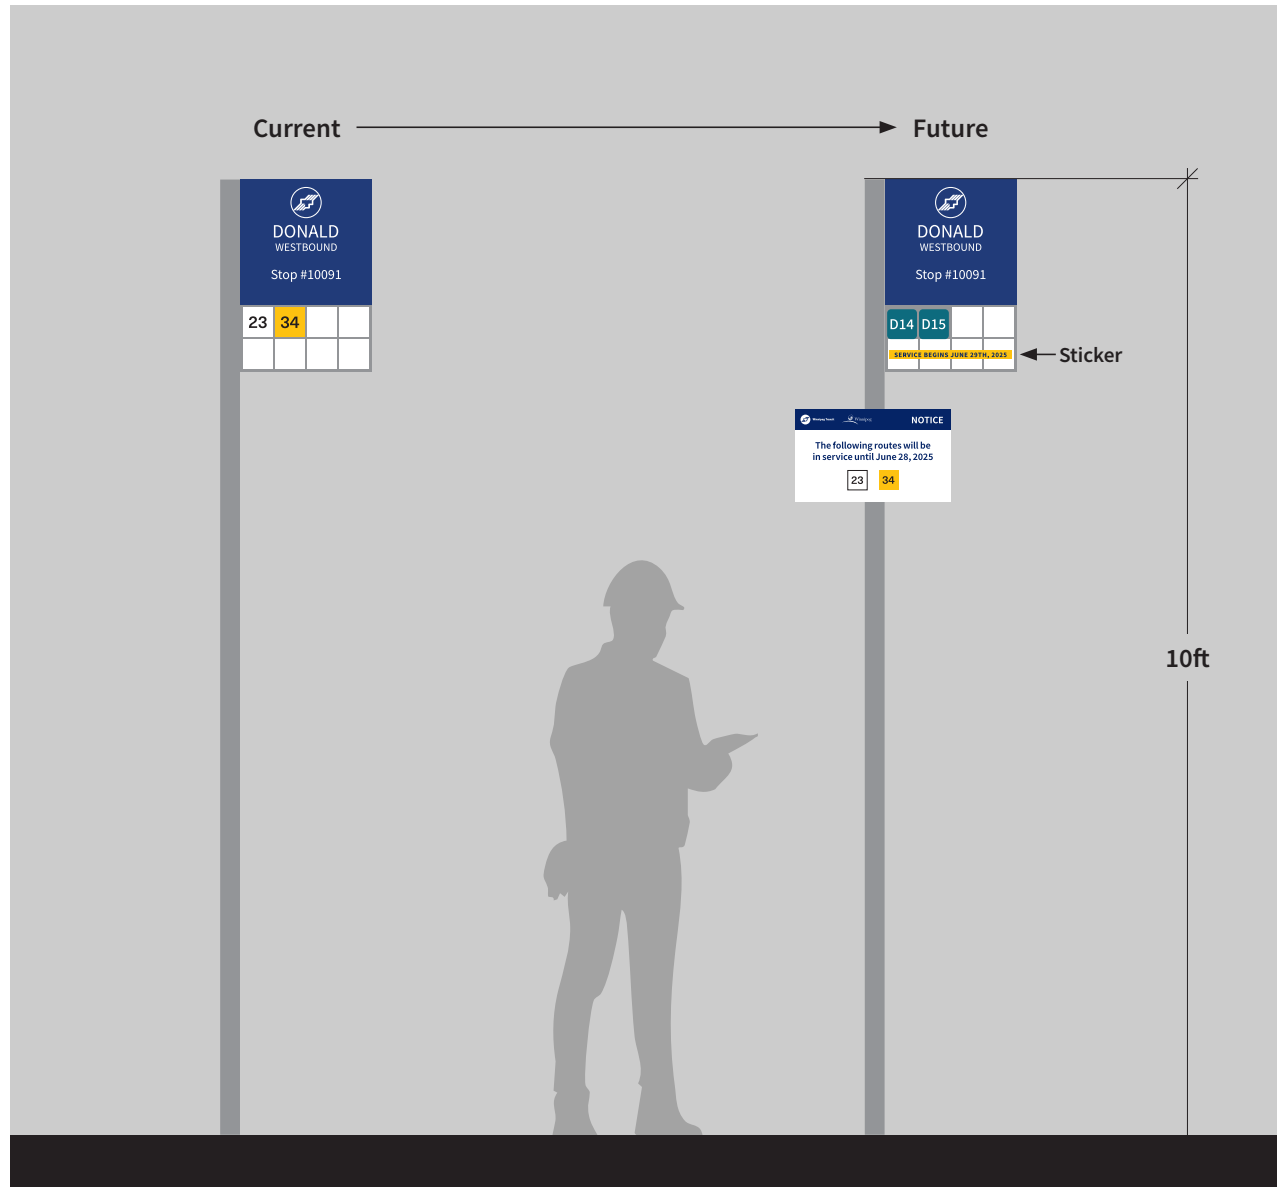

APPROXIMATE QUANTITY

90

ACTIVITY LOG

- a Remove current route tiles from both sides of sign
- b Install new route tiles on both sides of sign
- c Add sticker to new signage stating "Service begins June 29th, 2025"
- d Install temporary notice board
- e Complete site survey

