

ALL DRAWINGS, SPECIFICATIONS AND RELATED DOCUMENTS ARE PROPERTY OF THE ARCHITECT. REPRODUCTION OF DRAWINGS, SPECIFICATIONS AND RELATED DOCUMENTS IN ANY FORM IS STRICTLY FORBIDDEN WITHOUT THE WRITTEN PERMISSION OF THE ARCHITECT.

CLIENT :
MARKET LANDS INC.


PROJECT :
MARKET LANDS
MIXED USE BUILDING
WINNIPEG, MANITOBA

ARCHITECT :
DAoust LESTAGE DAoust LESTAGE
architecture - design urban - paysage
1225 217
1460 doucoulange.com
+1 514 982 0877
NUMBER TEN ARCHITECTURAL GROUP
310 - 115 Barnaby Ave. Winnipeg, MB,
R3B 9G3
winnipeg@numberten.com
+1 204-942-0981


ELECTRICAL CONSULTANT :
TETRA TECH
3475 East Foothill Blvd, Pasadena CA,
91107-6024
info@tetratech.com
+1 626 351 4664

STRUCTURAL CONSULTANT :
ENTUITIVE ENTUITIVE
200 University Ave, 7th Floor, Toronto ON,
M5H 3C9
entive.com
+1 416 477 5832

CIVIL CONSULTANT :
WSP CANADA INC.
1600 Buffalo Place, Winnipeg, Manitoba,
R3T 6A6
info@wsp.com
+1 204 259 1659

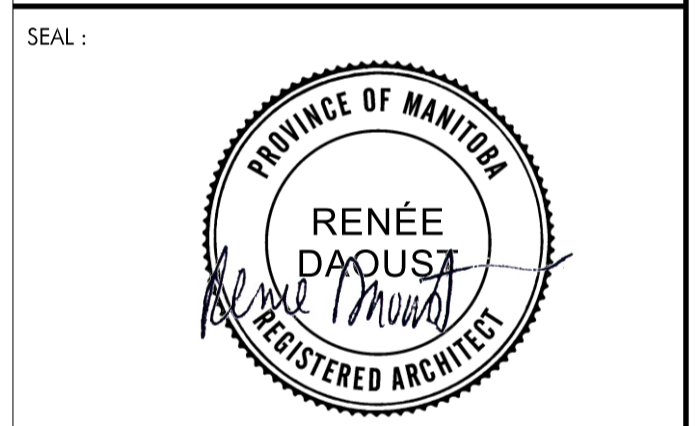


NO.	DESCRIPTION	DATE
1	ISSUED FOR ADDENDA 1	2024-03-20
0	ISSUED FOR TENDER	2024-02-02
A	ISSUED FOR INFORMATION	2023-11-22

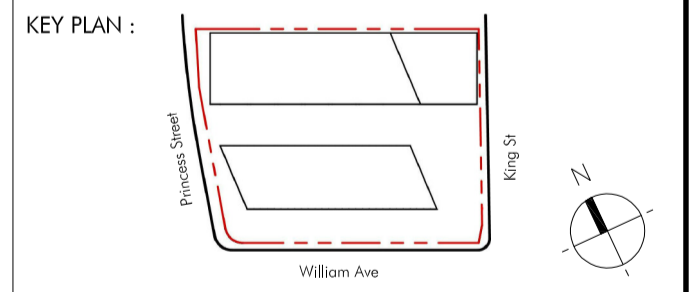


DISCIPLINE :
LANDSCAPE
LOT :
SITE DEVELOPMENT
TITLE :
GENERIC DETAILS


DRAWN BY : G.F. FILE : 694-19
DEVELOPED BY : R.S. SCALE : INDICATED
APPROVED BY : R.D. PAGE :
PRINT DATE : 2024-02-02 L-1502

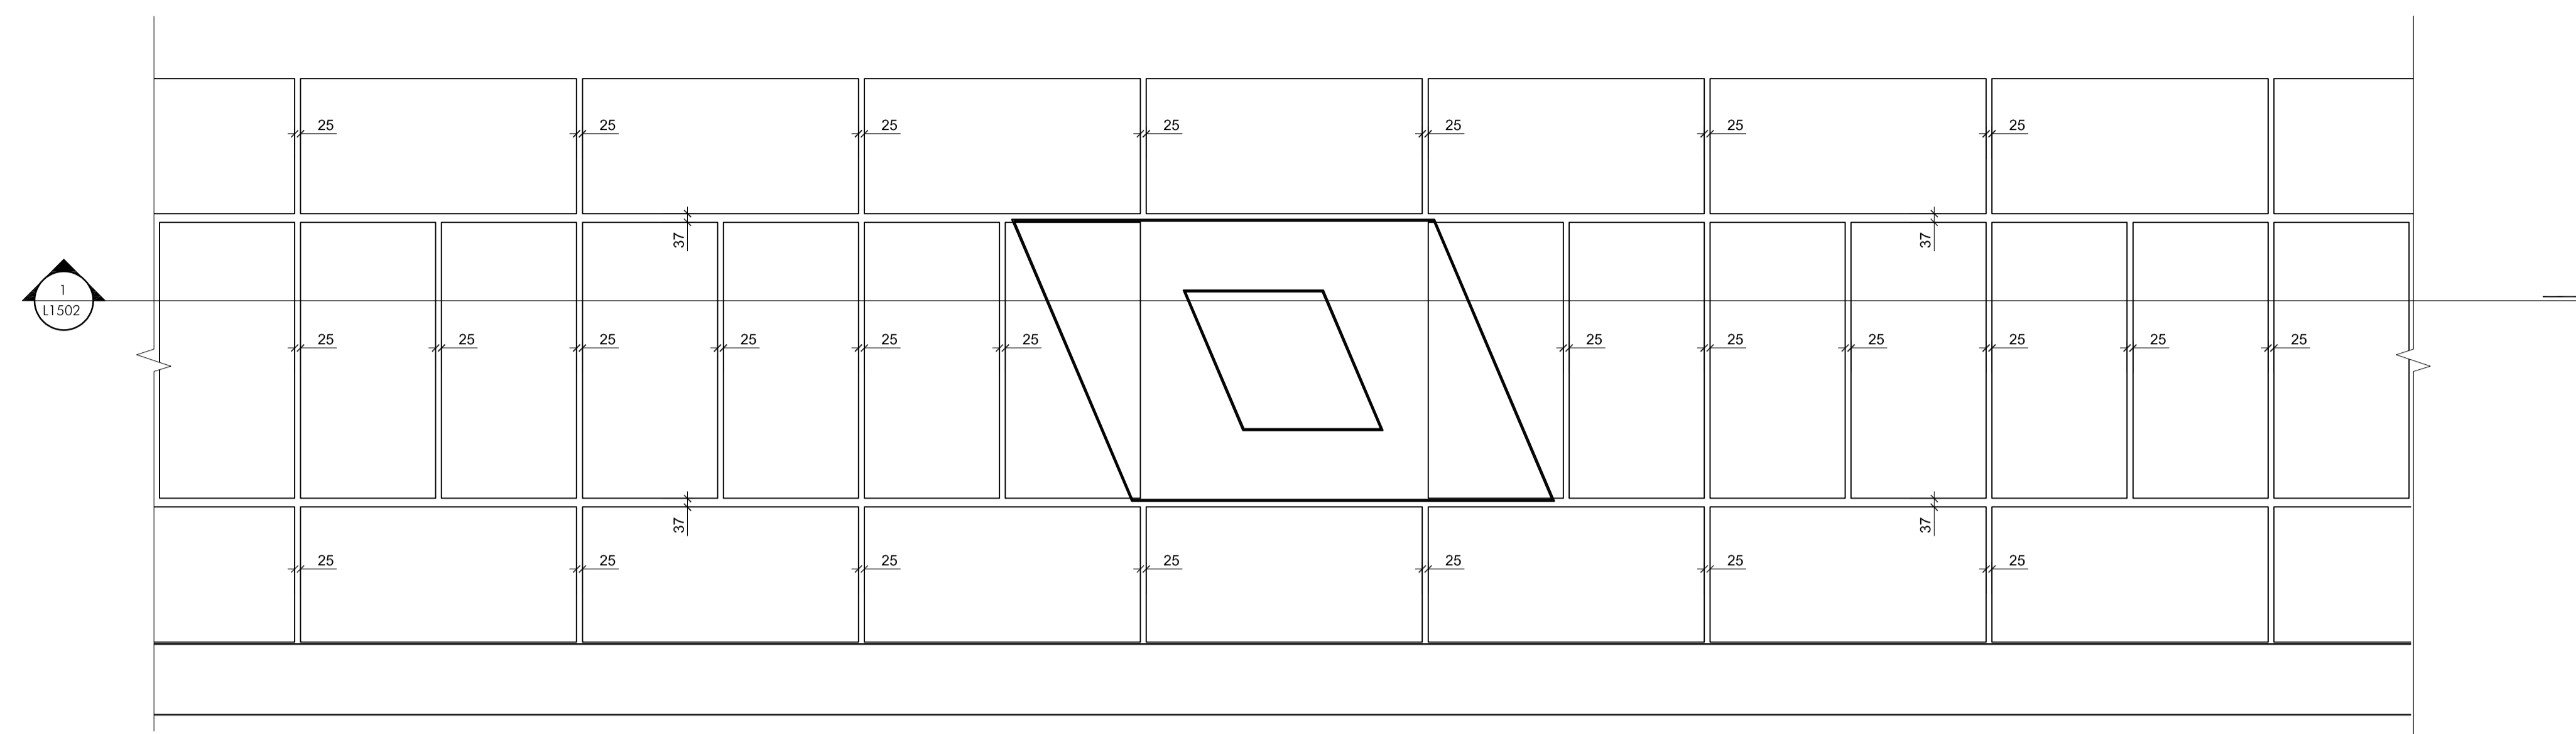


5 PLAN - SILVACELLS LAYOUT (TYP.)
1:20

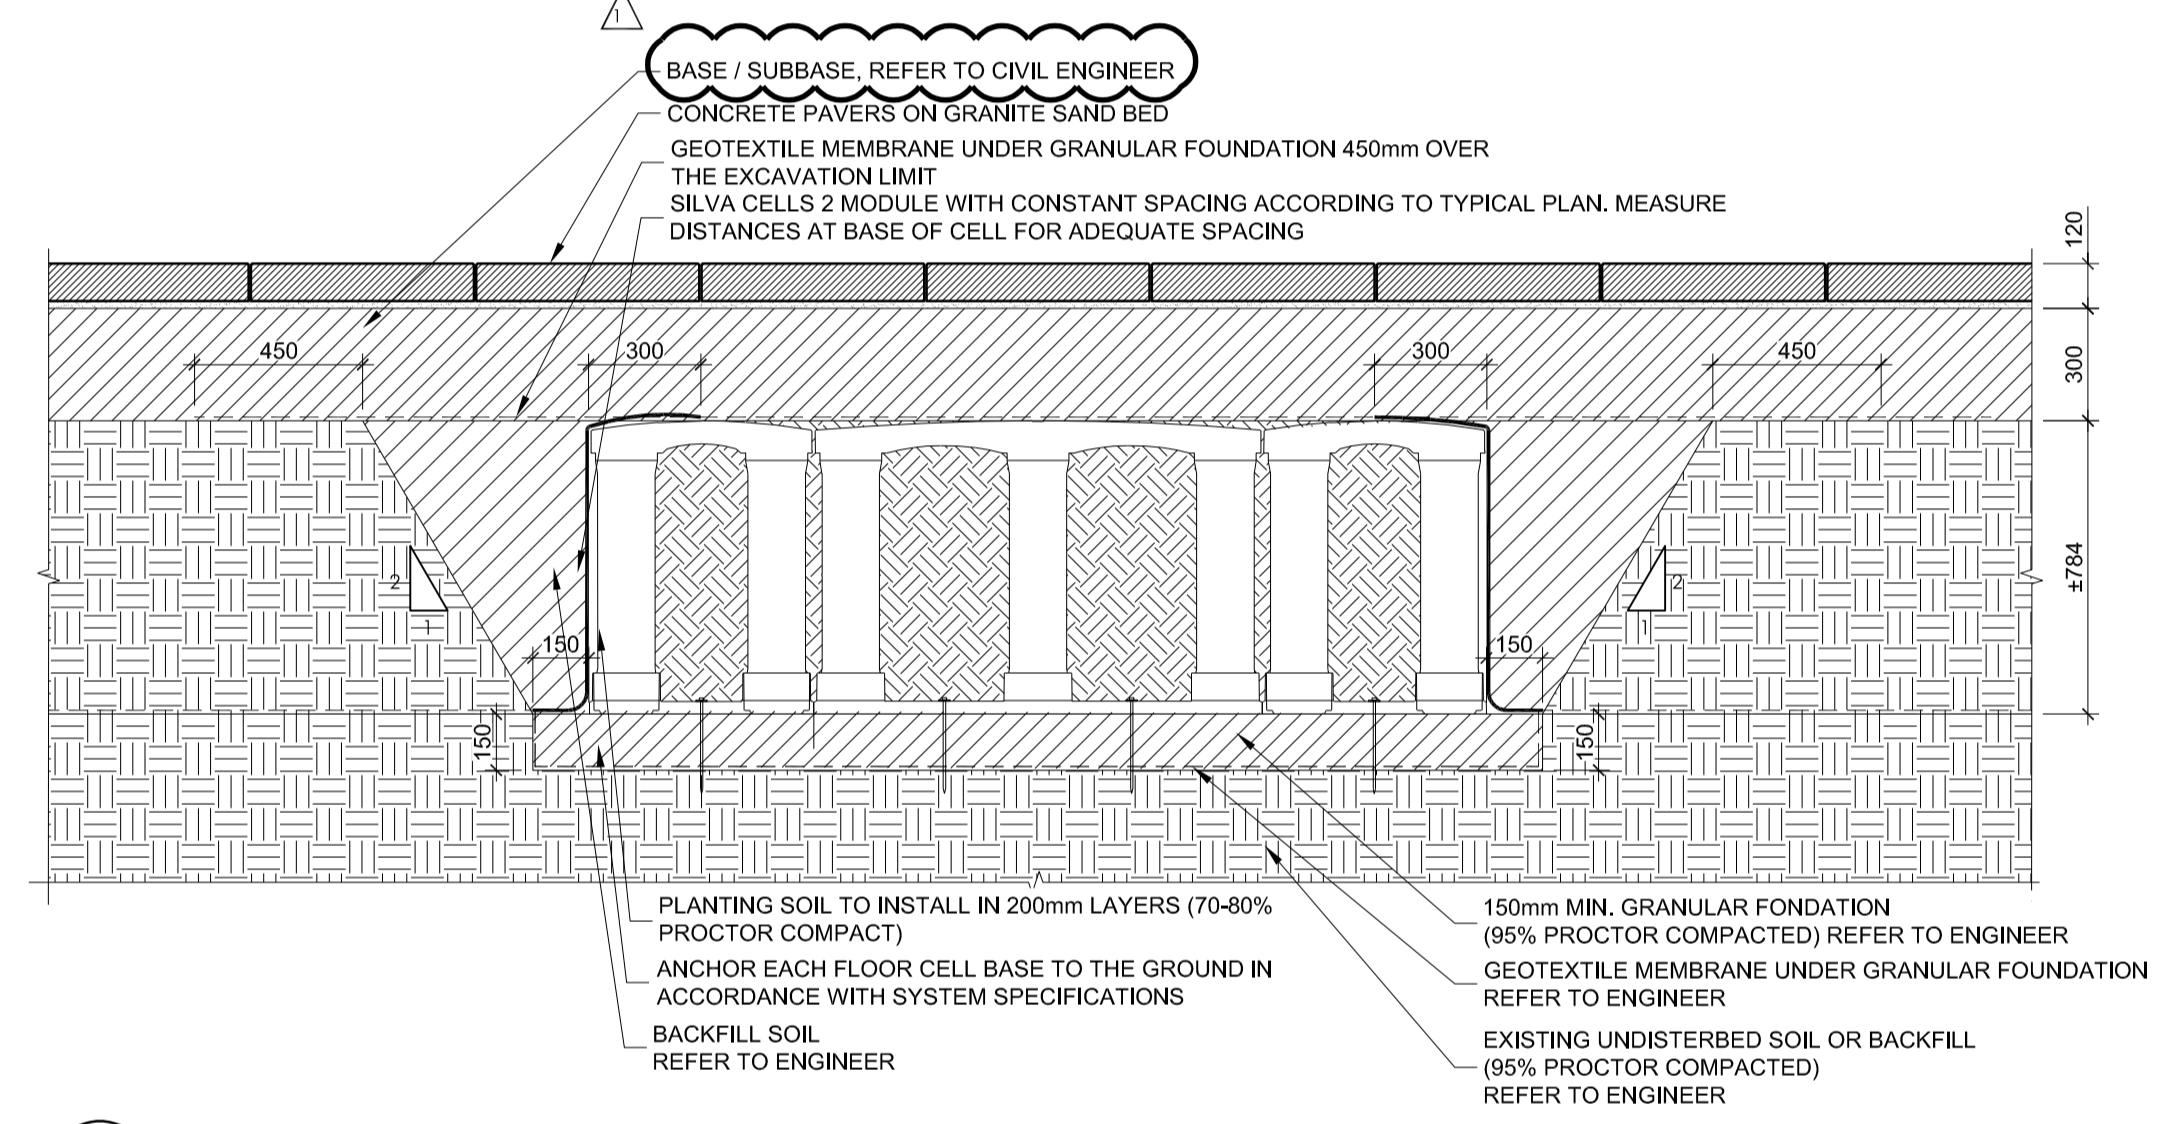


2 SILVACELLS 2 SYSTEM
SECTION DETAIL
1:20

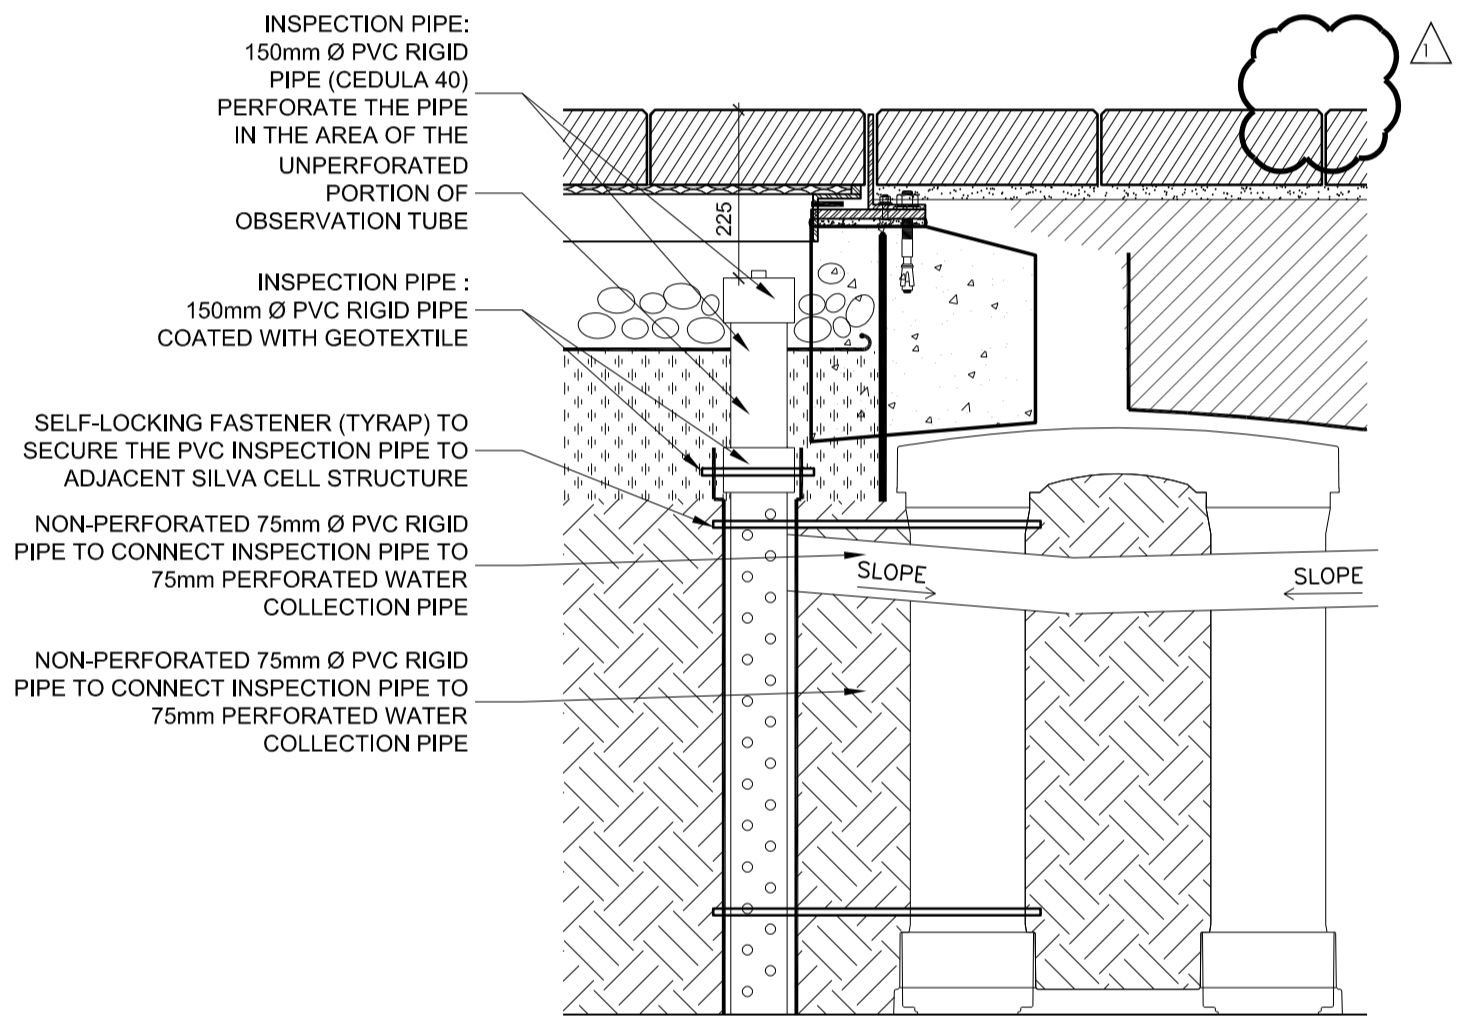

3 INSPECTION PIPE SILVACELL
SECTION
1:10

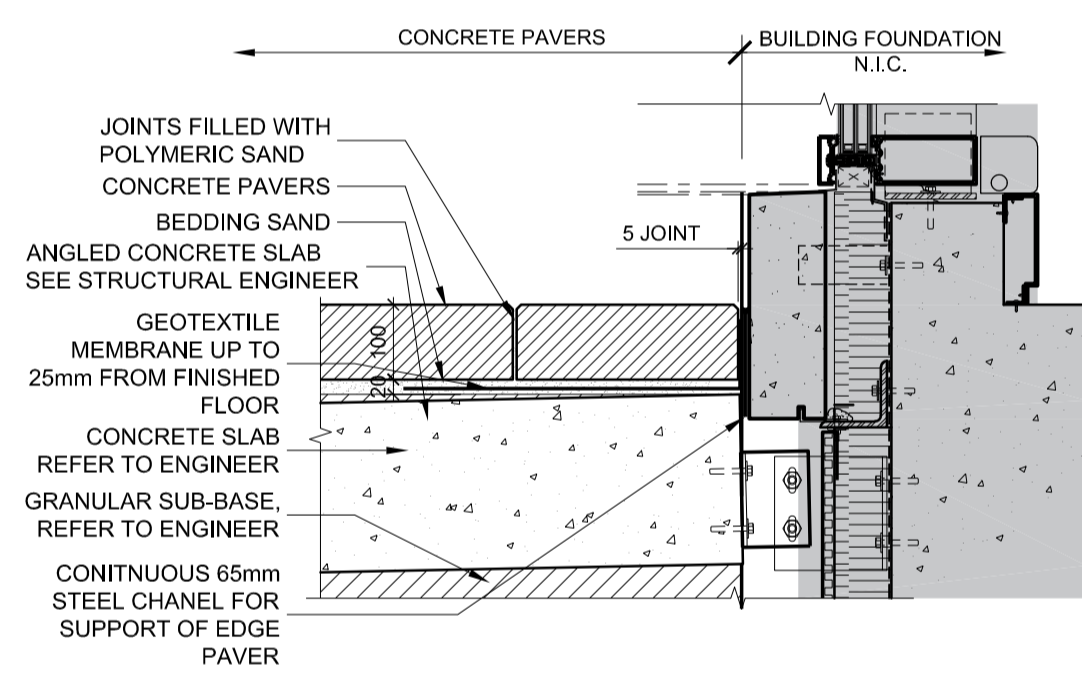

4 BUILDING FOUNDATION AND CONCRETE PAVERS JUNCTION
SECTION
1:10

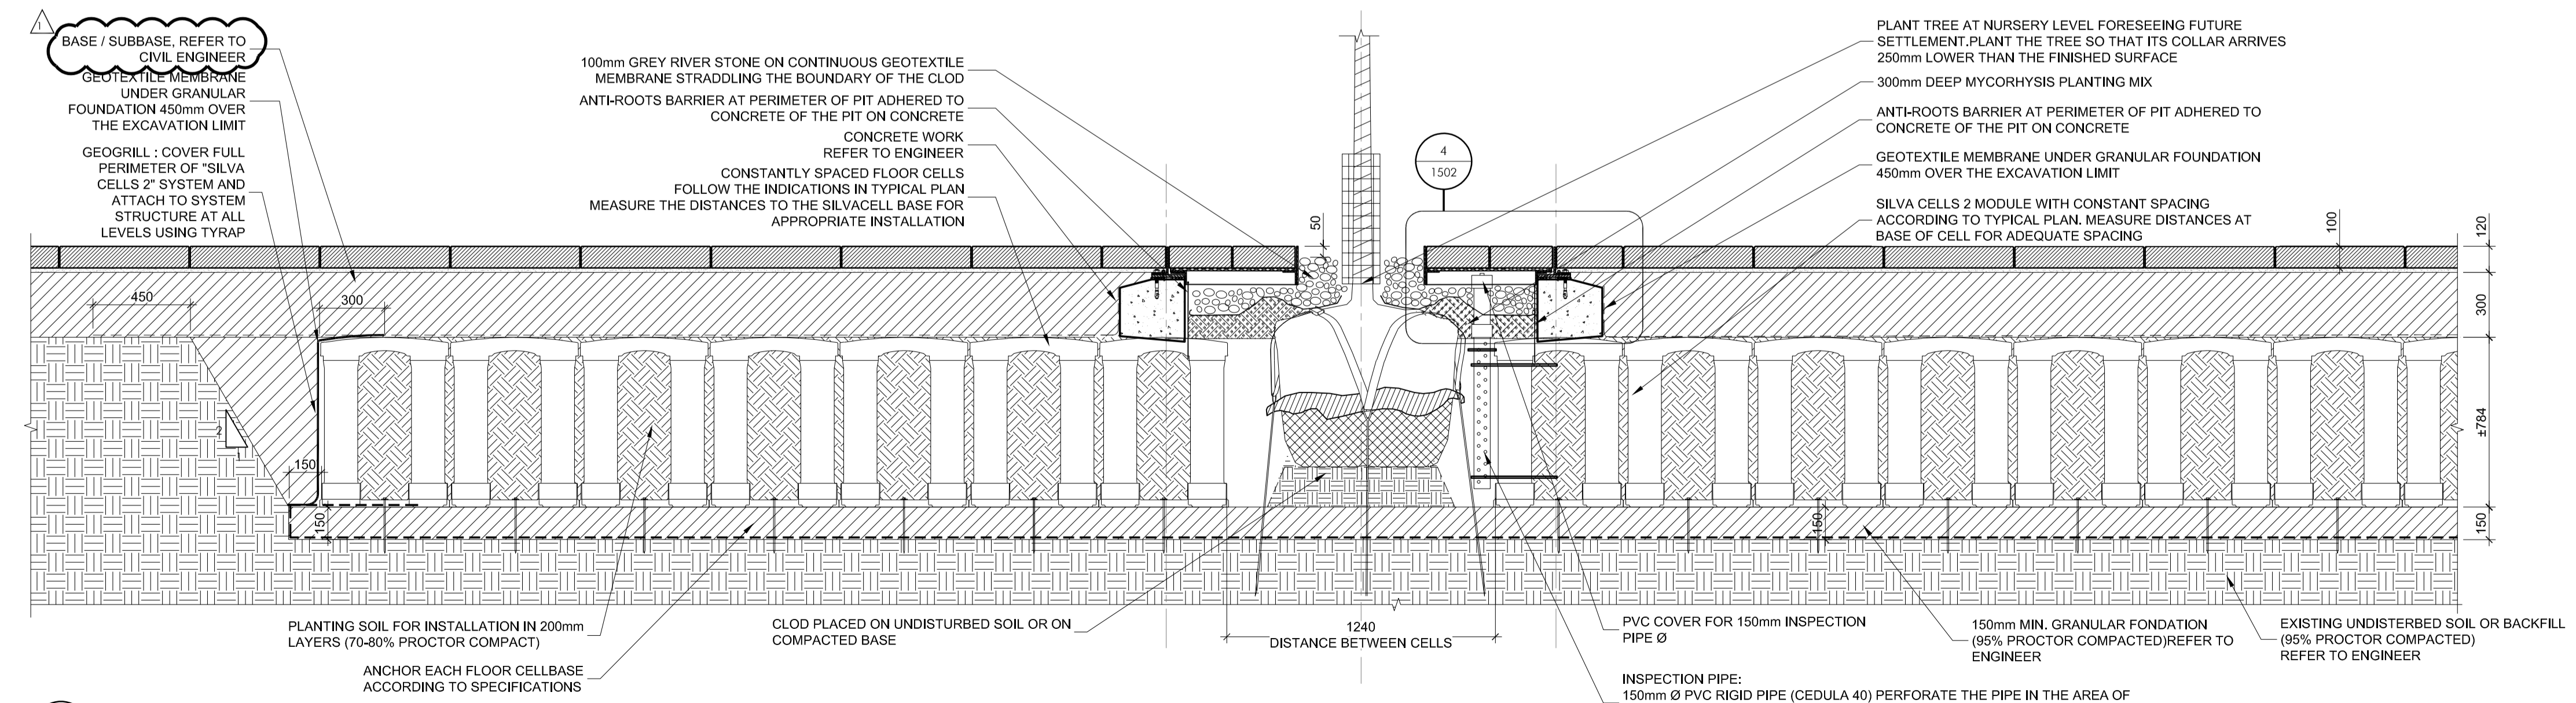

1 SILVACELLS 2 SYSTEM
SECTION DETAIL
1:20