



# THE CITY OF WINNIPEG


## PUBLIC WORKS DEPARTMENT

### 2024 RESIDENTIAL STREETS RENEWAL PROGRAM - MCADAM AVENUE AND VARIOUS OTHER LOCATIONS (24-R-02B)

TENDER NO. 181-2024


#### DRAWING LIST

- 01 - COVER SHEET
- ASPHALT RECONSTRUCTION**
- CARRUTHERS AVE - SINCLAIR ST-AIRLIES ST**
- 02 - PLAN-PROFILE (START TO STA. 1+150)
- 03 - PLAN-PROFILE (STA. 1+150 TO STA. 1+310)
- 04 - PLAN-PROFILE (STA. 1+310 TO END)
- PAVEMENT REHABILITATION/RESURFACING**
- DAHLIA AVE - SINCLAIR ST-MCADAM AVE**
- 05 - PLAN-PROFILE (START TO END)
- ASPHALT RECONSTRUCTION**
- MCADAM AVE - SINCLAIR ST-ARLINGTON ST**
- 06 - PLAN-PROFILE (START TO END)
- PAVEMENT REHABILITATION/RESURFACING**
- FORTIER AVE - PENTLAND ST-SUMMERFIELD WAY**
- 07 - PLAN-PROFILE (START TO END)
- PAVEMENT REHABILITATION/RESURFACING**
- SUMMERFIELD WAY - GILMORE AVE-GILMORE AVE**
- 08 - PLAN-PROFILE (START TO STA. 2+140)
- 09 - PLAN-PROFILE (STA. 2+140 TO STA. 2+275)
- 10 - PLAN-PROFILE (STA. 2+275 TO STA. 2+420)
- 11 - PLAN-PROFILE (STA. 2+420 TO STA. 2+575)
- 12 - PLAN-PROFILE (STA. 2+575 TO END)
- PAVEMENT REHABILITATION/RESURFACING**
- TRANQUILITY COVE - GILMORE AVE-SUMMERFIELD WAY**
- 13 - PLAN-PROFILE (START TO STA. 3+150)
- 14 - PLAN-PROFILE (STA. 3+150 TO STA. 3+220)
- 15 - PLAN-PROFILE (STA. 3+220 TO END)
- PAVEMENT REHABILITATION/RESURFACING**
- HOOD AVE - SCARFE ST-LEAHCREST CRES**
- 16 - PLAN-PROFILE (START TO MID)
- 17 - PLAN-PROFILE (MID TO END)
- MISCELLANEOUS**
- SECTIONS AND DETAILS**
- 18 - SECTIONS AND DETAILS
  
- STREET LIGHTING**
- 19 - MCADAM AVE - HYDRO DRAWING 1 OF 5
- 20 - MCADAM AVE - HYDRO DRAWING 2 OF 5
- 21 - MCADAM AVE - HYDRO DRAWING 3 OF 5
- 22 - MCADAM AVE - HYDRO DRAWING 4 OF 5
- 23 - MCADAM AVE - HYDRO DRAWING 5 OF 5
  
- NEIGHBOURHOOD GREENWAY (SEE APPENDIX)**
- LARSEN AVE & HARBISON AVE W
- KILDONAN DRIVE

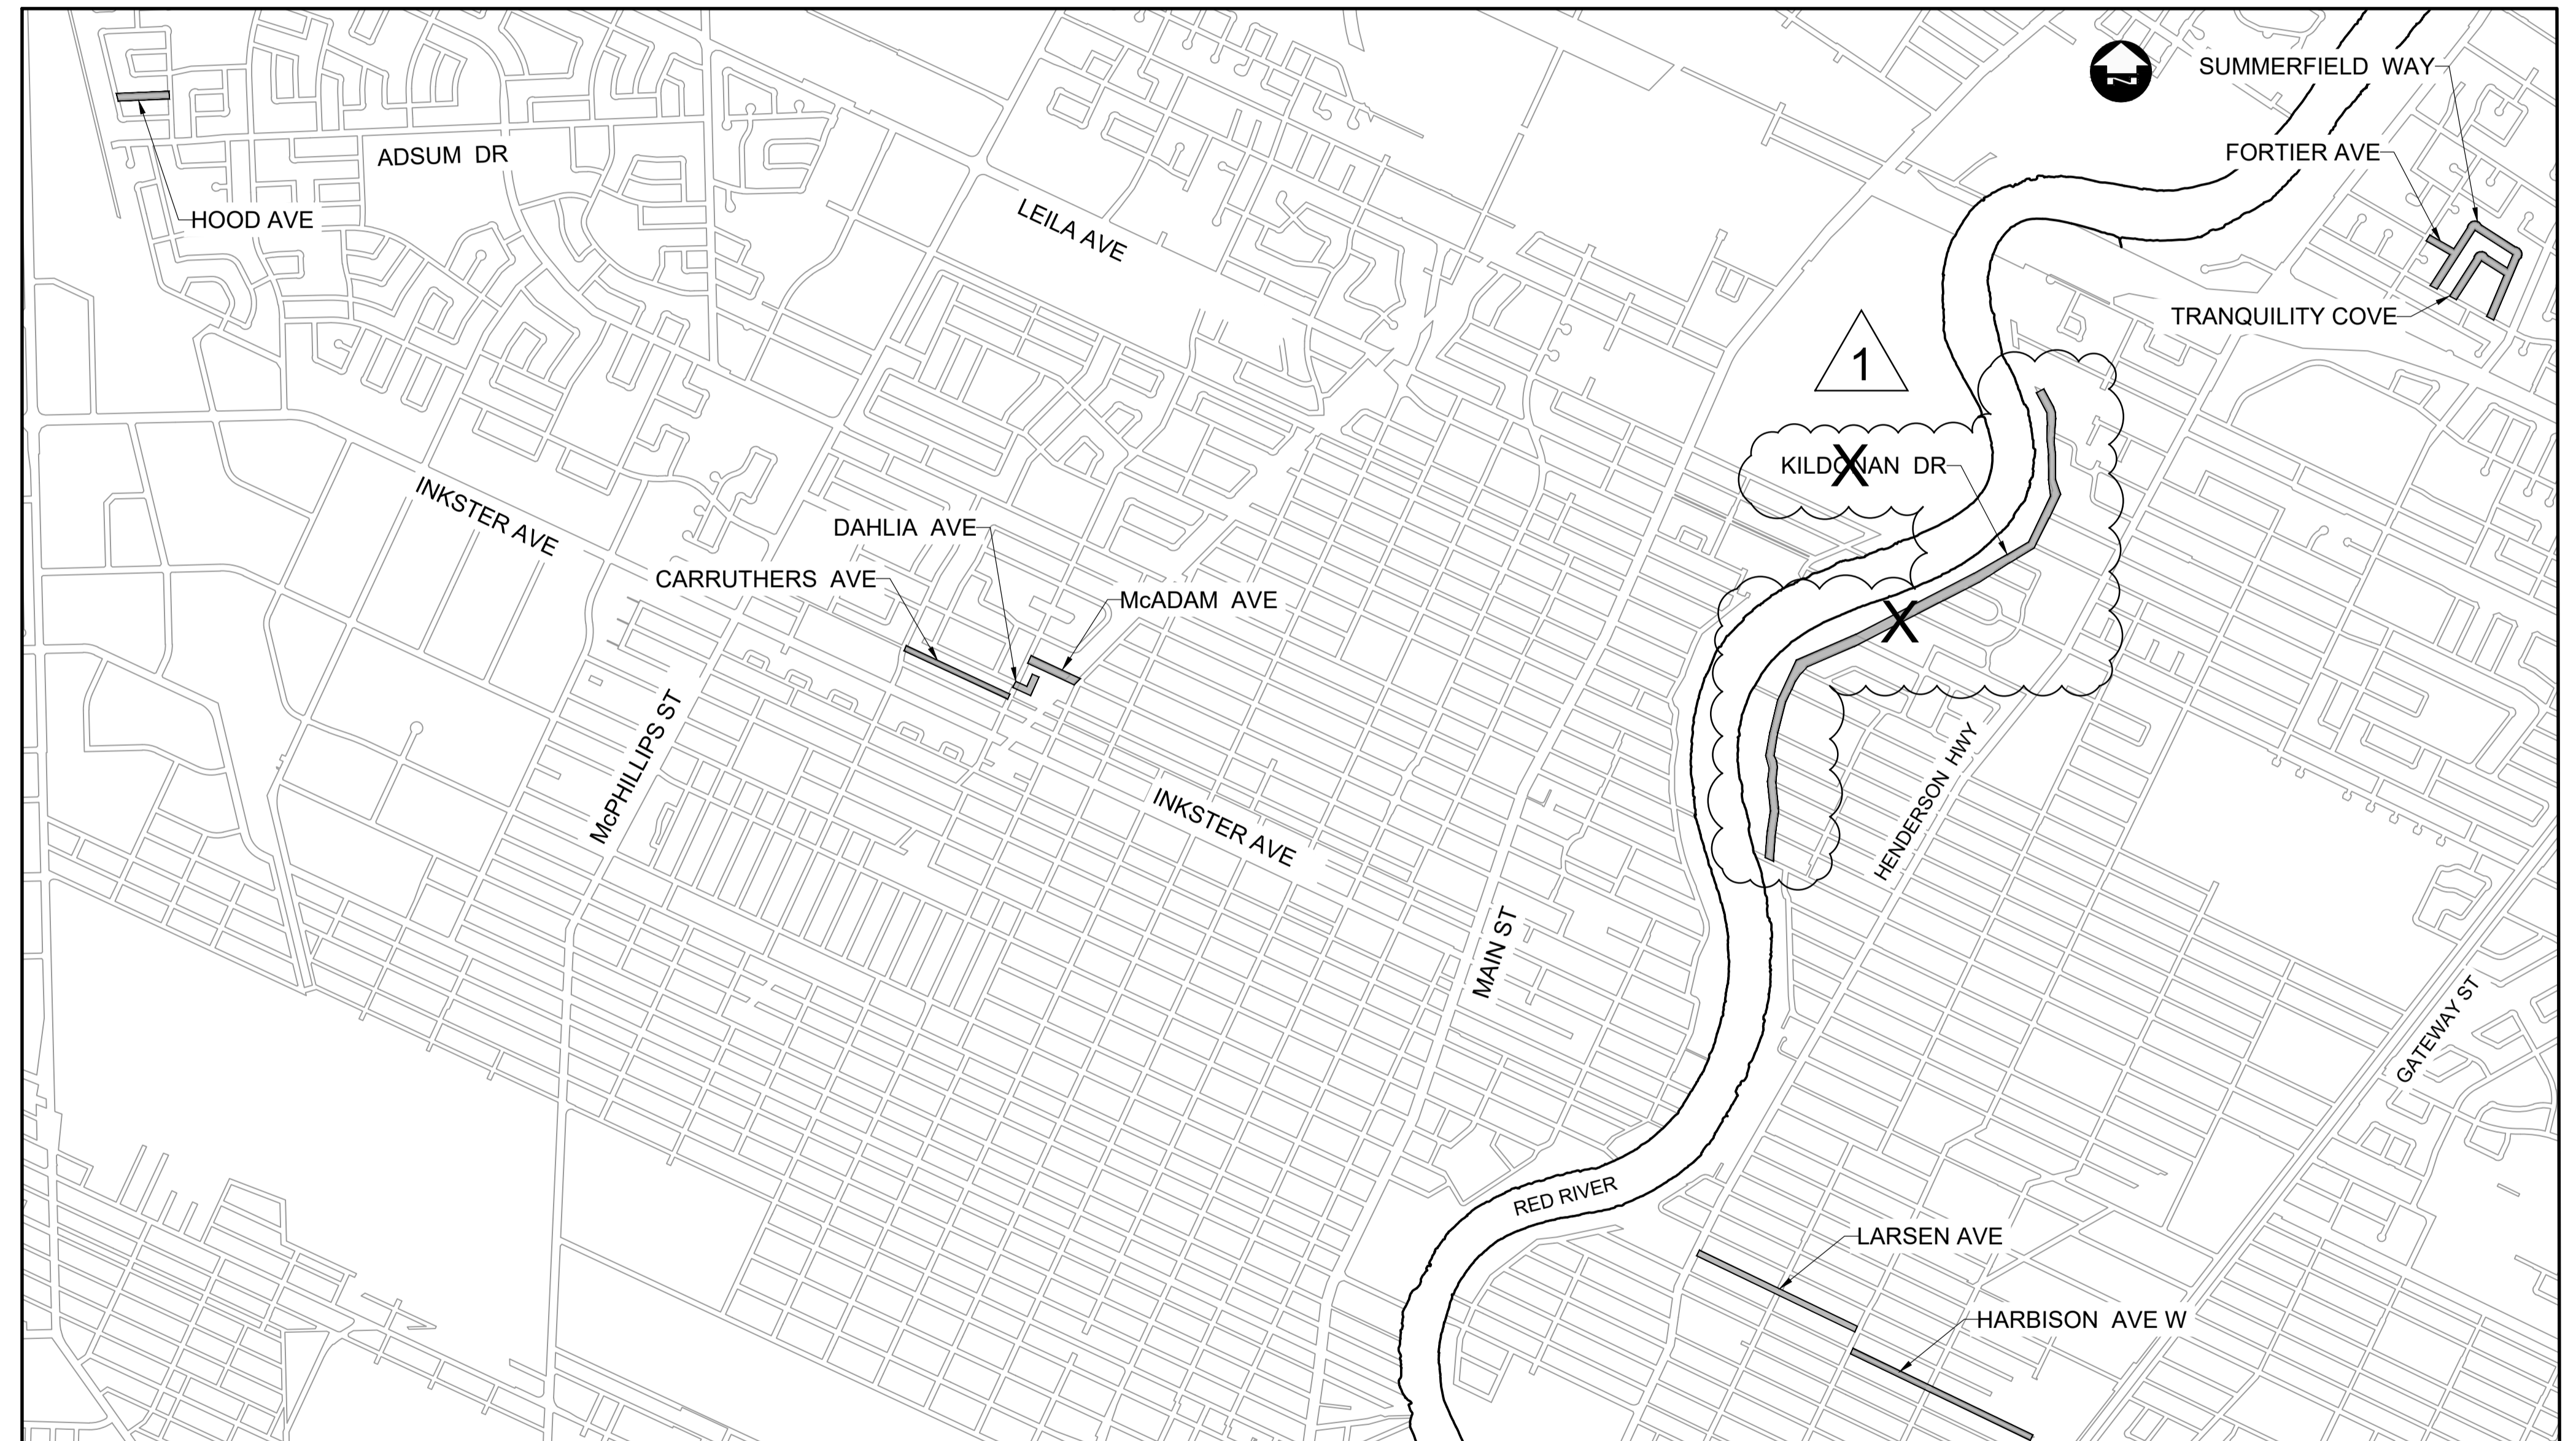

PRELIMINARY ONLY  
NOT FOR CONSTRUCTION

#### LOCATION PLANS

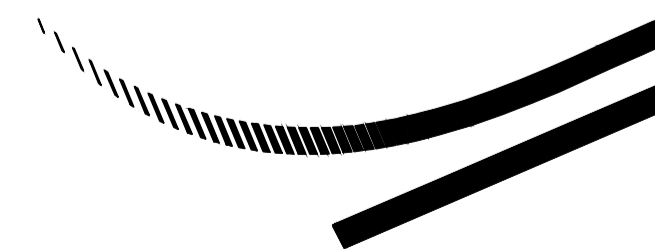

**DILLON**  
CONSULTING

RELEASED FOR CONSTRUCTION

DATE