



PLAN - CHAMBER ROOF
SCALE: 1:30

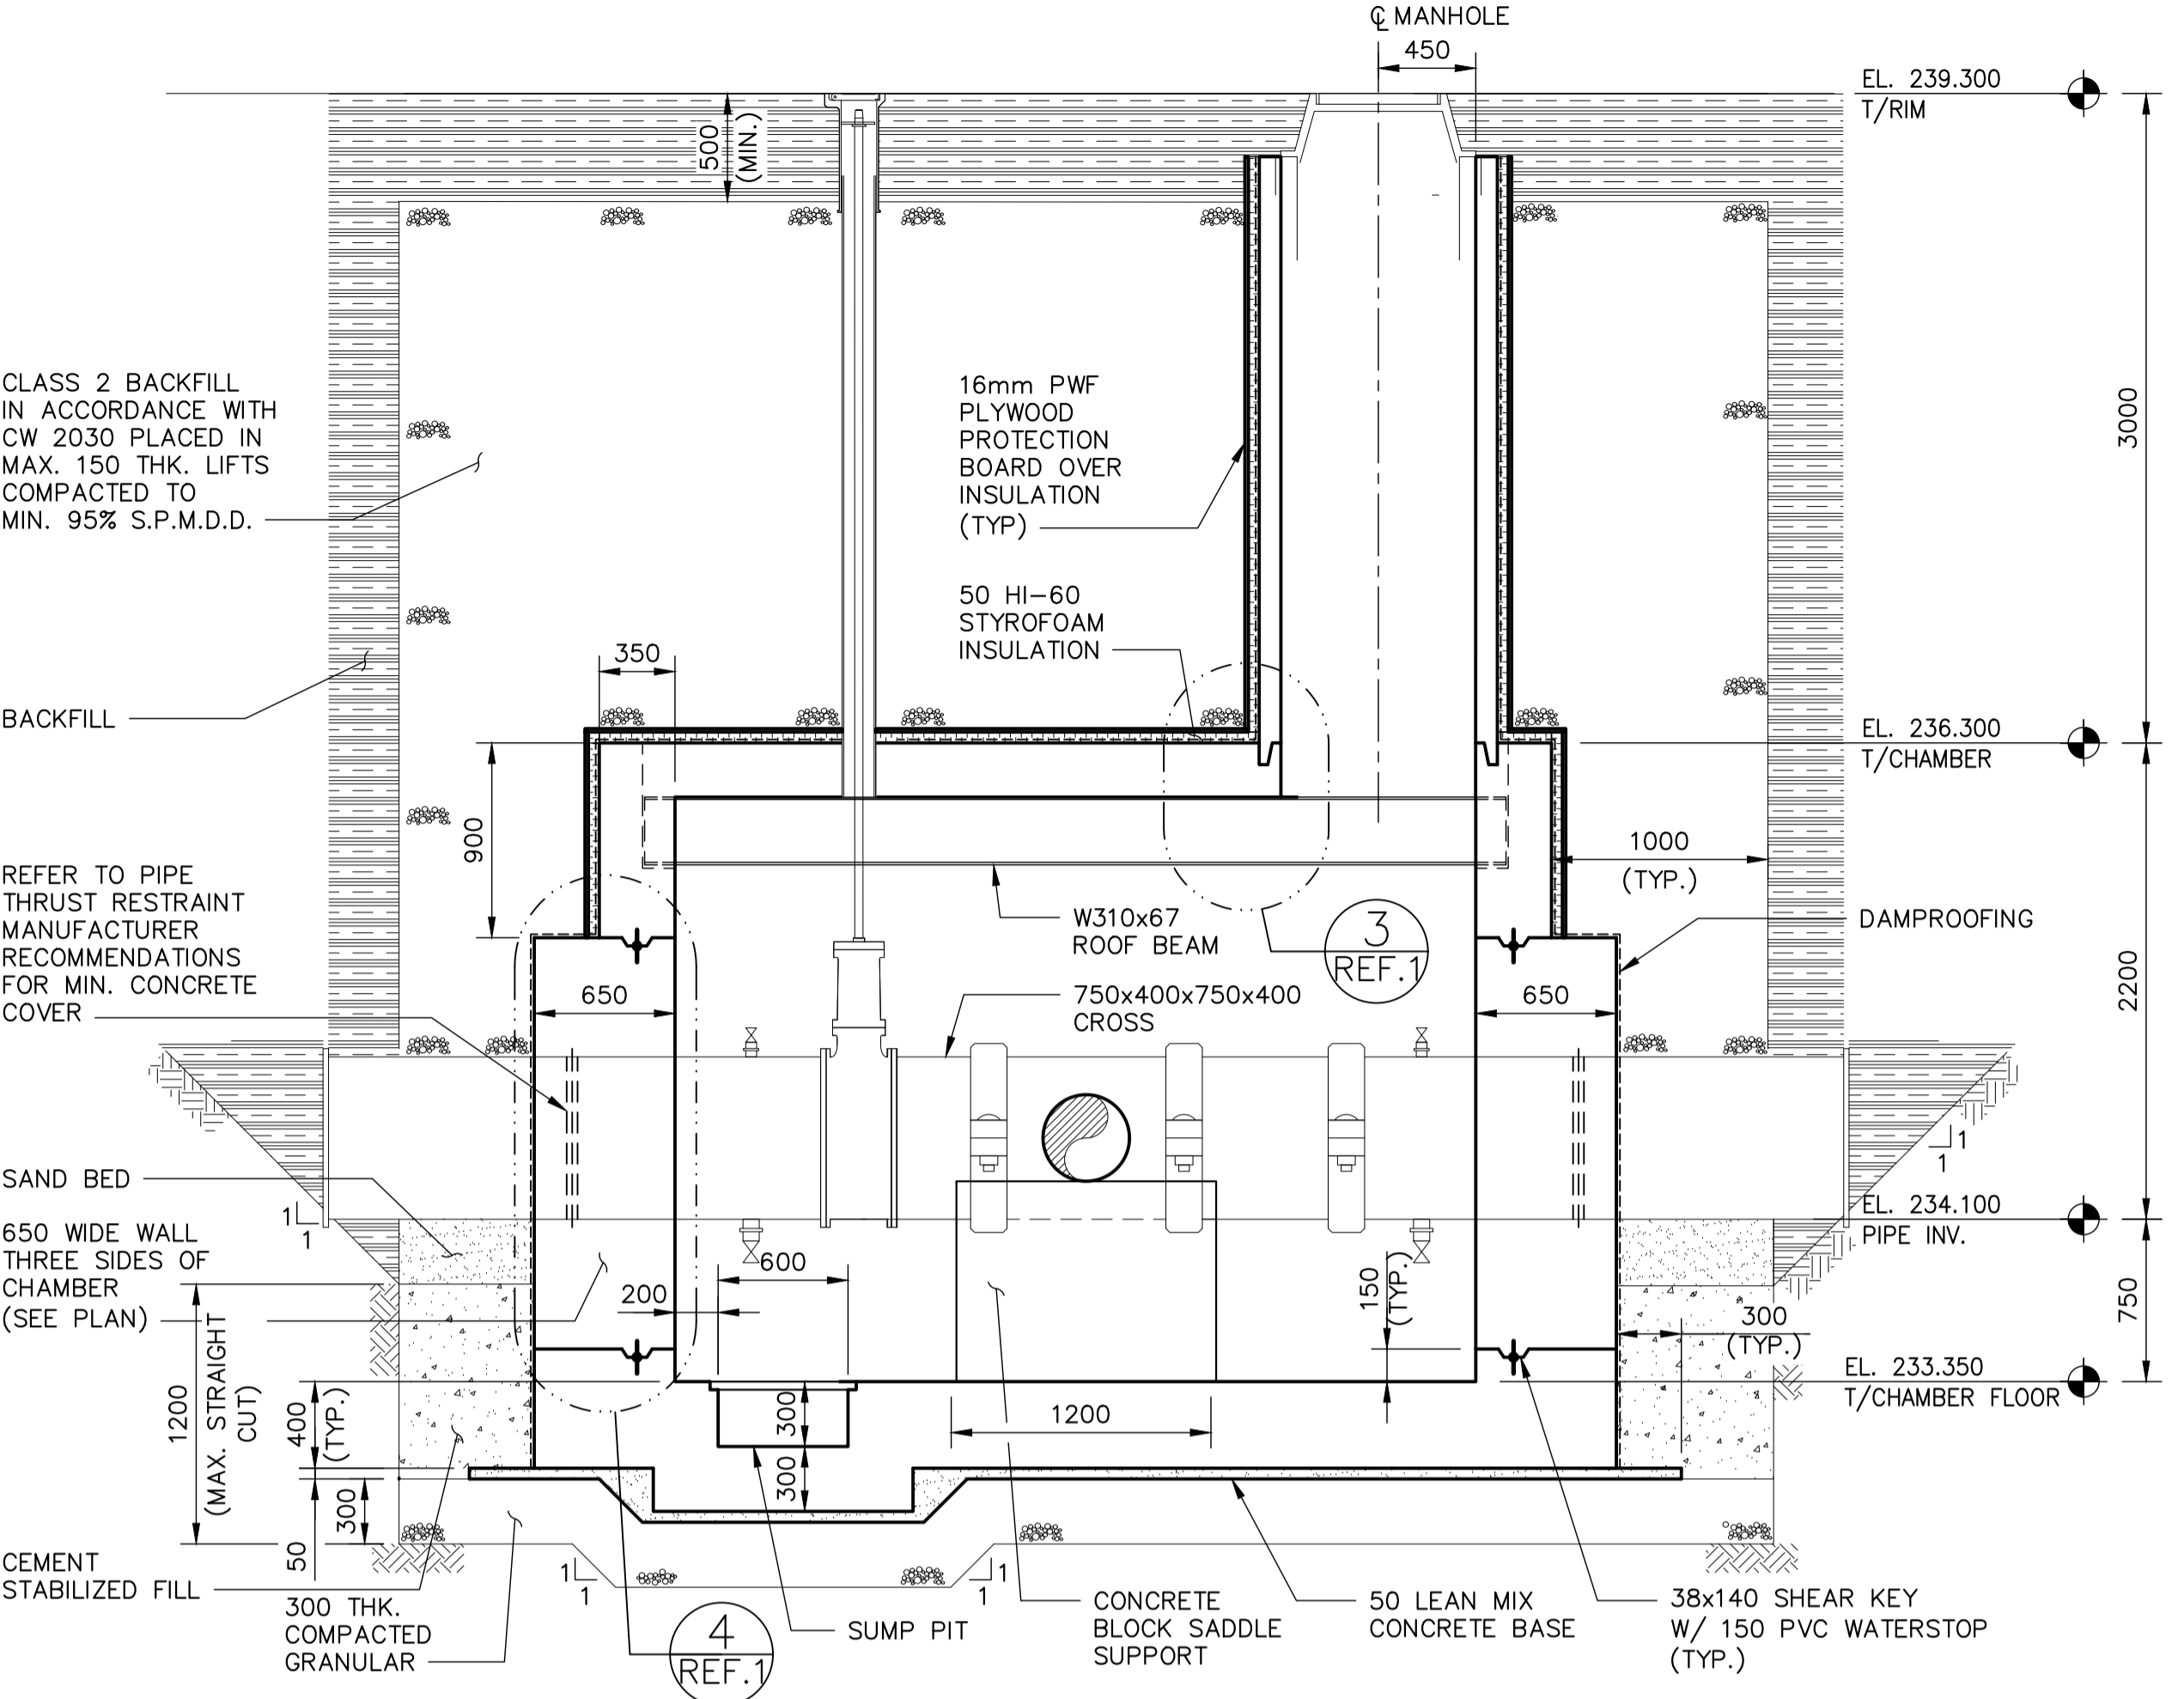


SECTION A
SCALE: 1:30

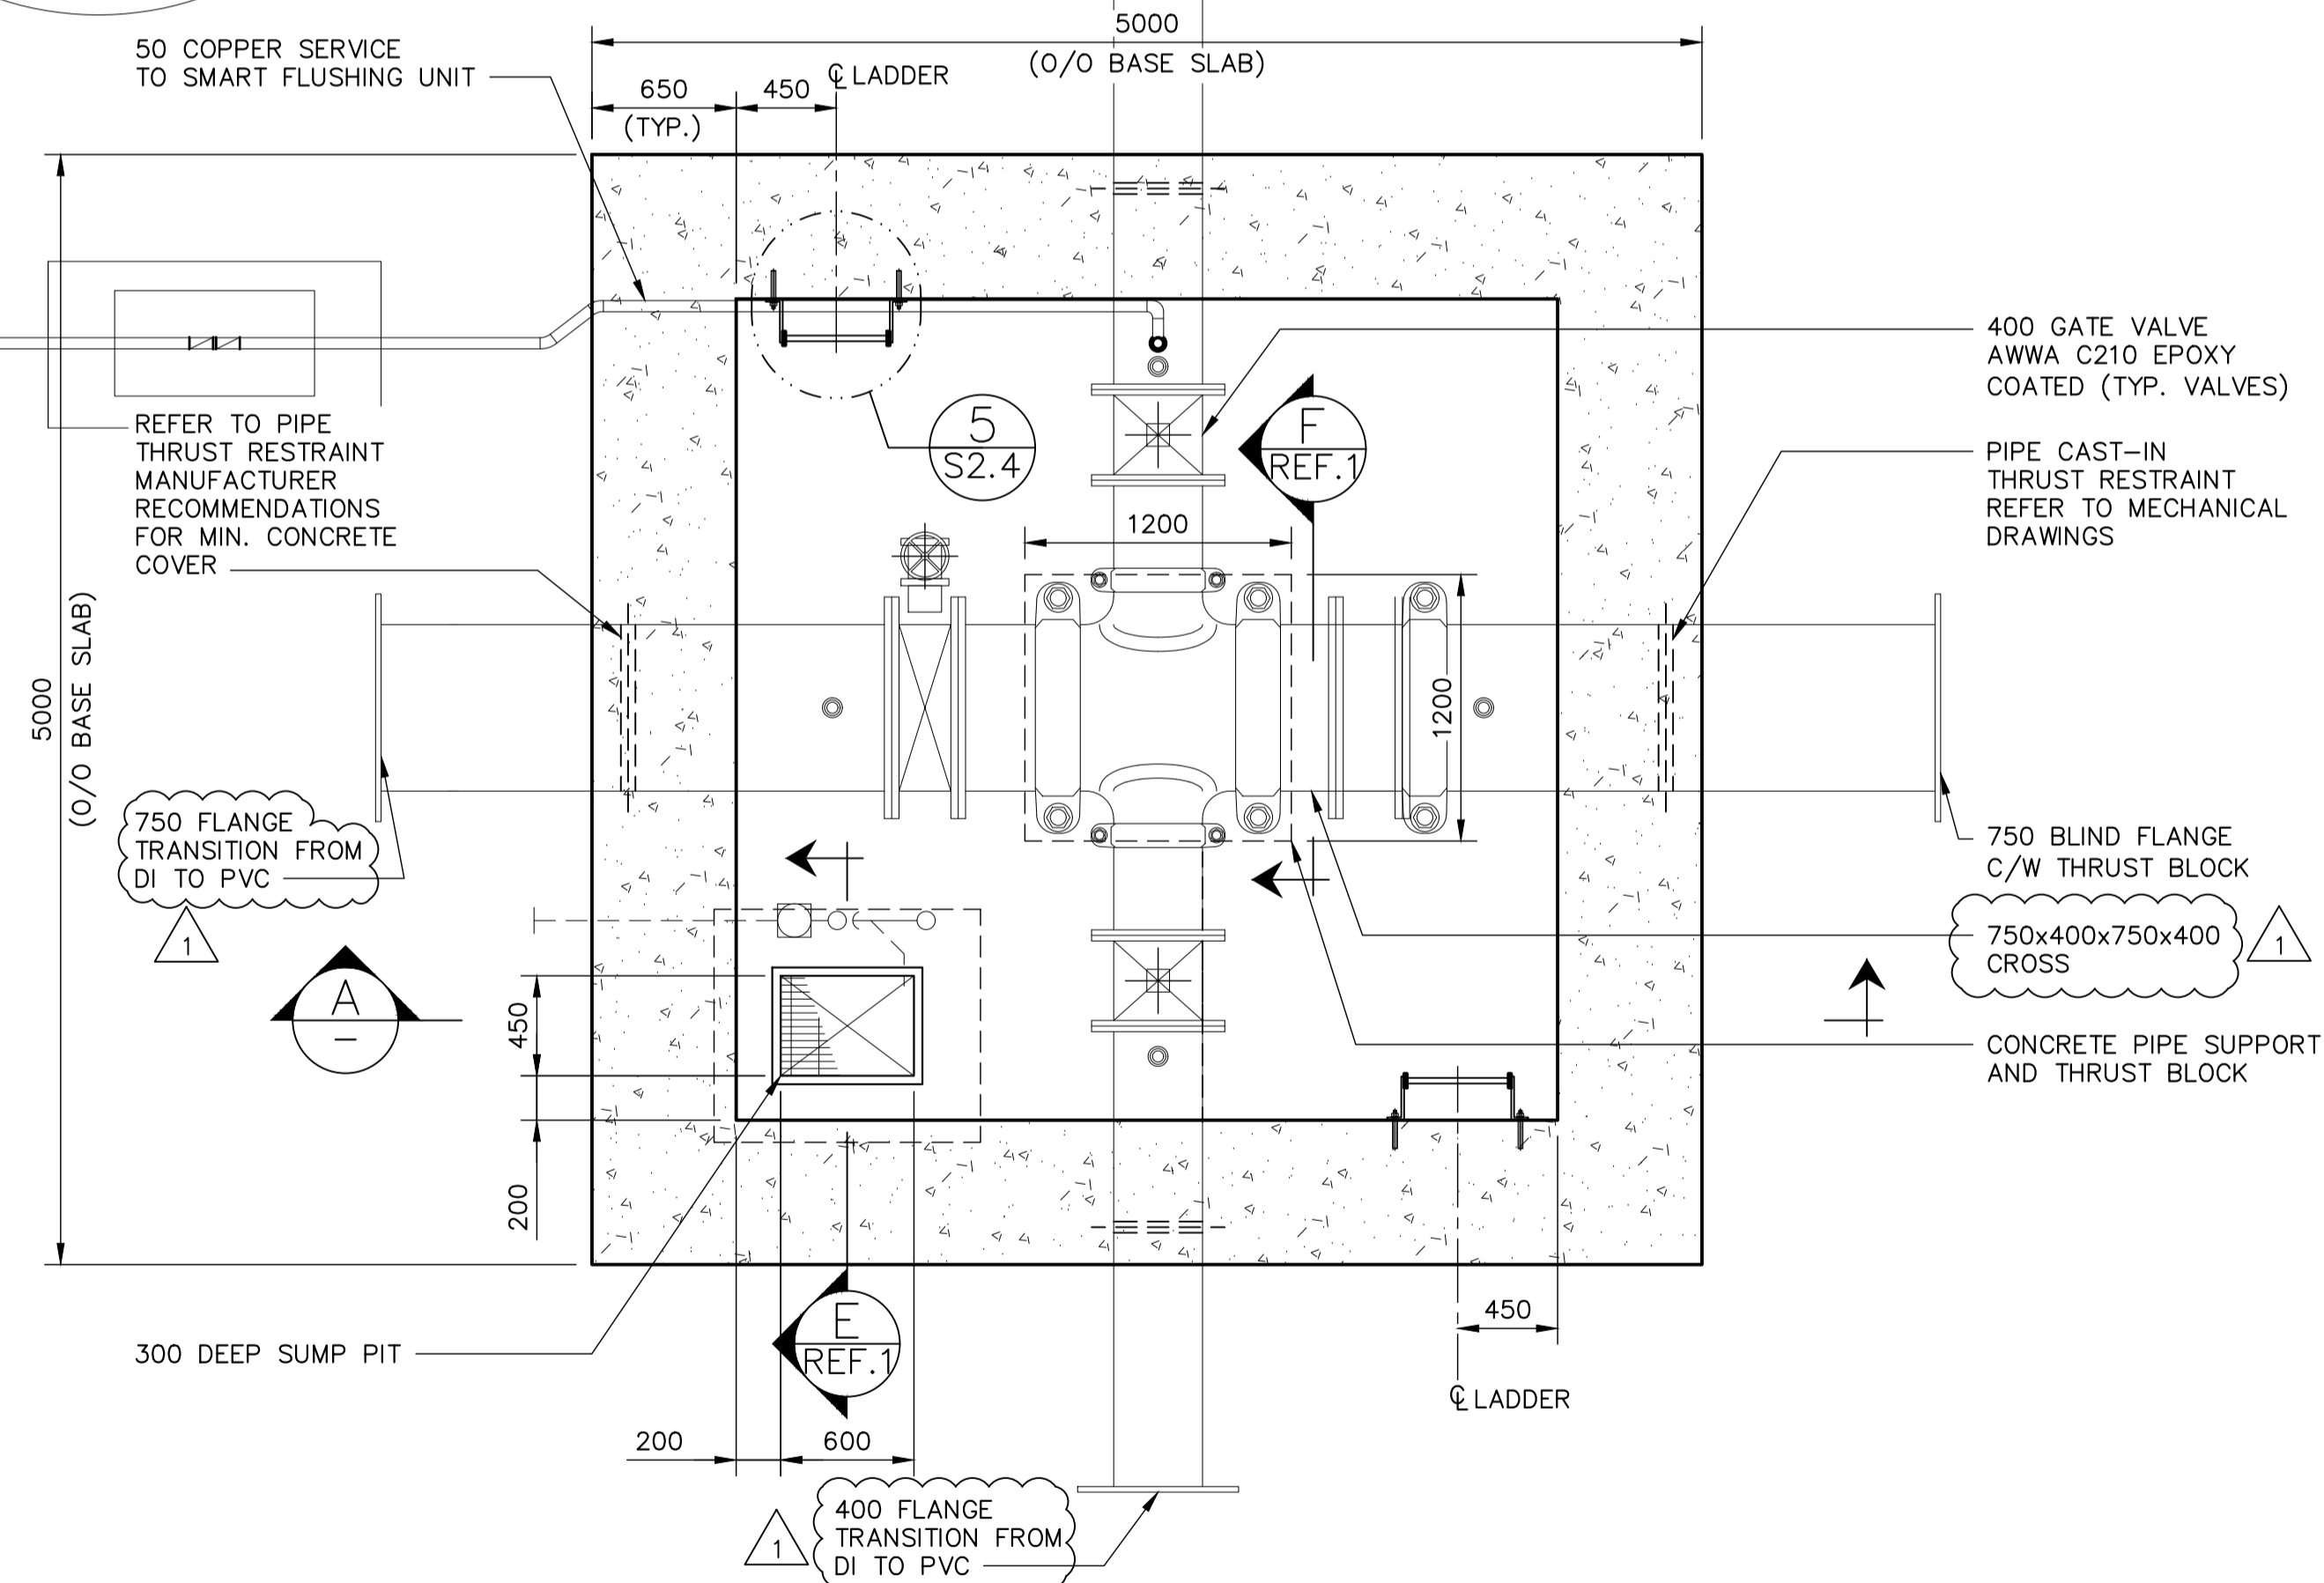

PLAN - CHAMBER BASE SLAB
SCALE: 1:30

10	-	-
9	-	-
8	-	-
7	-	-
6	-	-
5	-	-
4	-	-
3	-	-
2	-	-
1	1-0798F-S0004-001	OFFTAKE STRUCTURES 2 & 3 - DETAILS
NO.	DRAWING NUMBER	REFERENCE DRAWING TITLE
REFERENCE DRAWINGS		

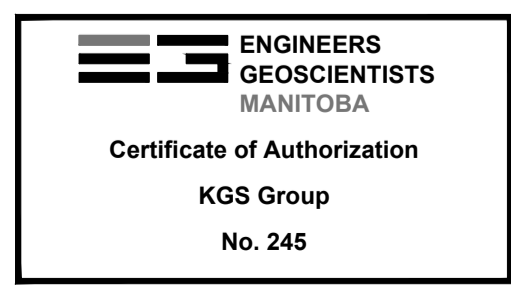

B.M. ELEV.			
CONSTRUCTION COMPLETION DATE: YYYY MM DD			
DESIGNED BY	JMW		
CHECKED BY			
DRAWN BY	FBV		
APPROVED BY	JMW		
SCALE:	AS SHOWN		
RELEASED FOR CONSTRUCTION			
DATE	2024 01 24		
DATE	2024 05 16		
DATE	2024 04 26		
DATE			
DATE			
DATE			
NO.	REVISIONS	DATE	BY
1	RE-ISSUED FOR TENDER	2024 05 16	JMW
0	ISSUED FOR TENDER	2024 04 26	JMW

KGS GROUP

ENGINEER'S SEAL

CONSULTANT DRAWING NUMBER: 23-0107-009_S2.3

THE CITY OF WINNIPEG
WATER AND WASTE DEPARTMENT
ENGINEERING DIVISION

Winnipeg

CENTREPORT SOUTH REGIONAL WATER AND WASTEWATER SERVICING
PHASE 1A CONTRACT 4A - FEEDER MAIN

STRUCTURAL
OFFTAKE STRUCTURE 3 - PLAN & SECTION

CITY DRAWING NUMBER: 1-0798F-S0003-001

SHEET 31 OF 34