



X:\P\2024\2410122000-2024 Main St & Norwood Bridges\09_CAD\07_Sheets\Staging & Traffic_Signage\2303678-MNB-Staging & Traffic_Signage.dwg Last Saved: 6/4/2024 11:38 AM by AScott Project: 6/4/2024 11:39 AM by Alan Scott A1 SIZE 594mm x 841mm

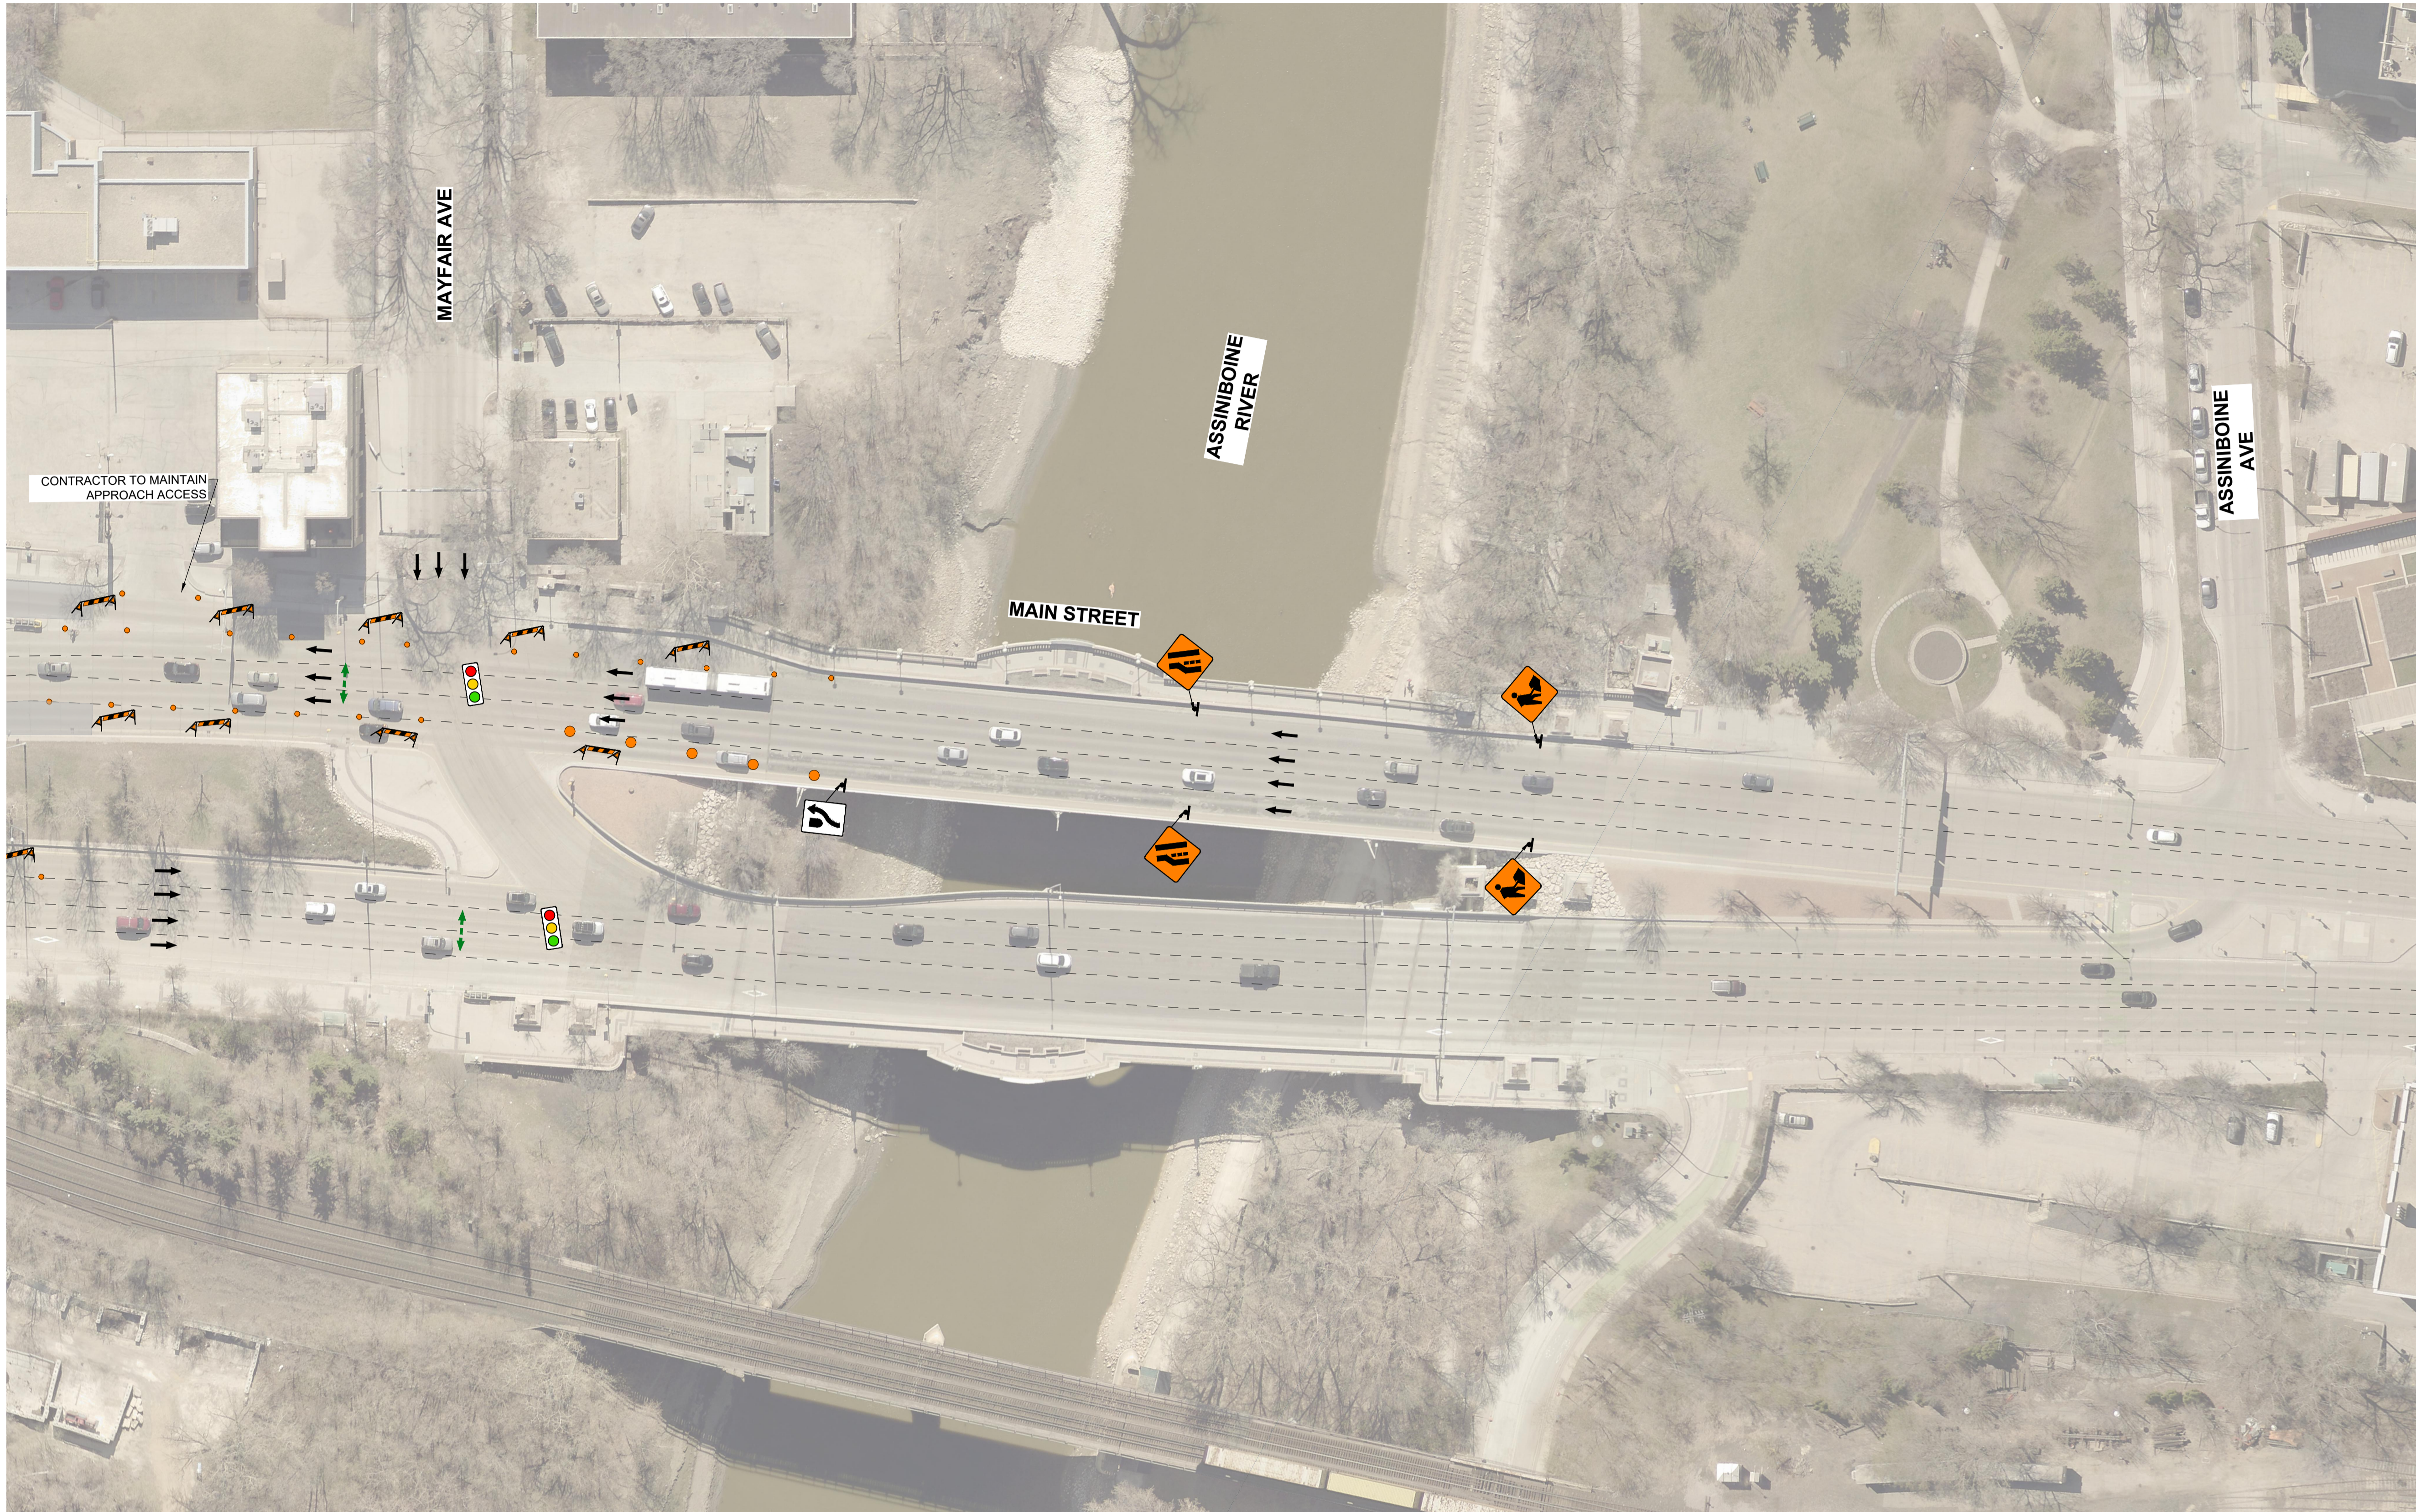

FOR CONTINUATION
SEE DRAWING 10

**STAGE 1
MAIN STREET (3 OF 3)**

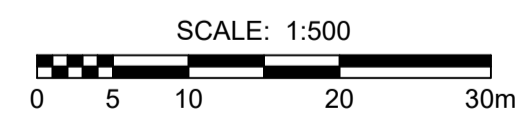

**LOCATION APPROVED
UNDERGROUND STRUCTURES**

SUPR. U/G STRUCTURES DATE COMMITTEE

NOTE:
LOCATION OF UNDERGROUND STRUCTURES AS SHOWN ARE BASED ON THE BEST INFORMATION AVAILABLE BUT NO GUARANTEE IS GIVEN THAT ALL EXISTING UTILITIES ARE SHOWN OR THAT THE GIVEN LOCATIONS ARE EXACT. CONFIRMATION OF EXISTENCE AND EXACT LOCATION OF ALL SERVICES MUST BE OBTAINED FROM THE INDIVIDUAL UTILITIES BEFORE PROCEEDING WITH CONSTRUCTION.

No.	REVISIONS	DATE	BY	ACK
1	ISSUED FOR ADDENDUM 2	24/06/03	ACK	
0	ISSUED FOR TENDER	24/05/09	ACK	
		YYMMDD		

DESIGNED BY	ACK	CHECKED BY	JGK
DRAWN BY	KMB	APPROVED BY	JGK
HOR SCALE	AS SHOWN	RELEASED FOR CONSTRUCTION	
VERT SCALE	AS SHOWN		
DATE	May 09, 2024	DATE	

PROFESSIONAL'S SEAL

CONSULTANT FILE NAME
2303678-MNB-Staging & Traffic Signage.dwg

THE CITY OF WINNIPEG
PUBLIC WORKS DEPARTMENT
ENGINEERING DIVISION

**2024 BRIDGE MAINTENANCE
MAIN STREET AND NORWOOD BRIDGES**

**TRAFFIC SIGNAGE & STAGING
STAGE 1
MAIN STREET (3 OF 3)**

CITY DRAWING NUMBER B-103-24-17 / B-104-24-10
SHEET 17 OF 31
DRAWING NUMBER 17

**ENGINEERS
GEOSCIENTISTS
MANITOBA**

Certificate of Authorization
MORRISON HERSHFIELD
No. 1736

TENDER No. 291-2024