

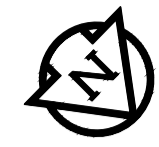


X:\P\2024\2410122000-2024 Main St & Norwood Bridges\09_CAD\07_Sheets\Staging & Traffic_Signage\2303678-MNB-Staging & Traffic_Signage.dwg Last Saved: 6/4/2024 12:20 PM by AScott Project: 6/4/2024 12:20 PM by Alan Scott A1 SIZE 594mm x 841mm

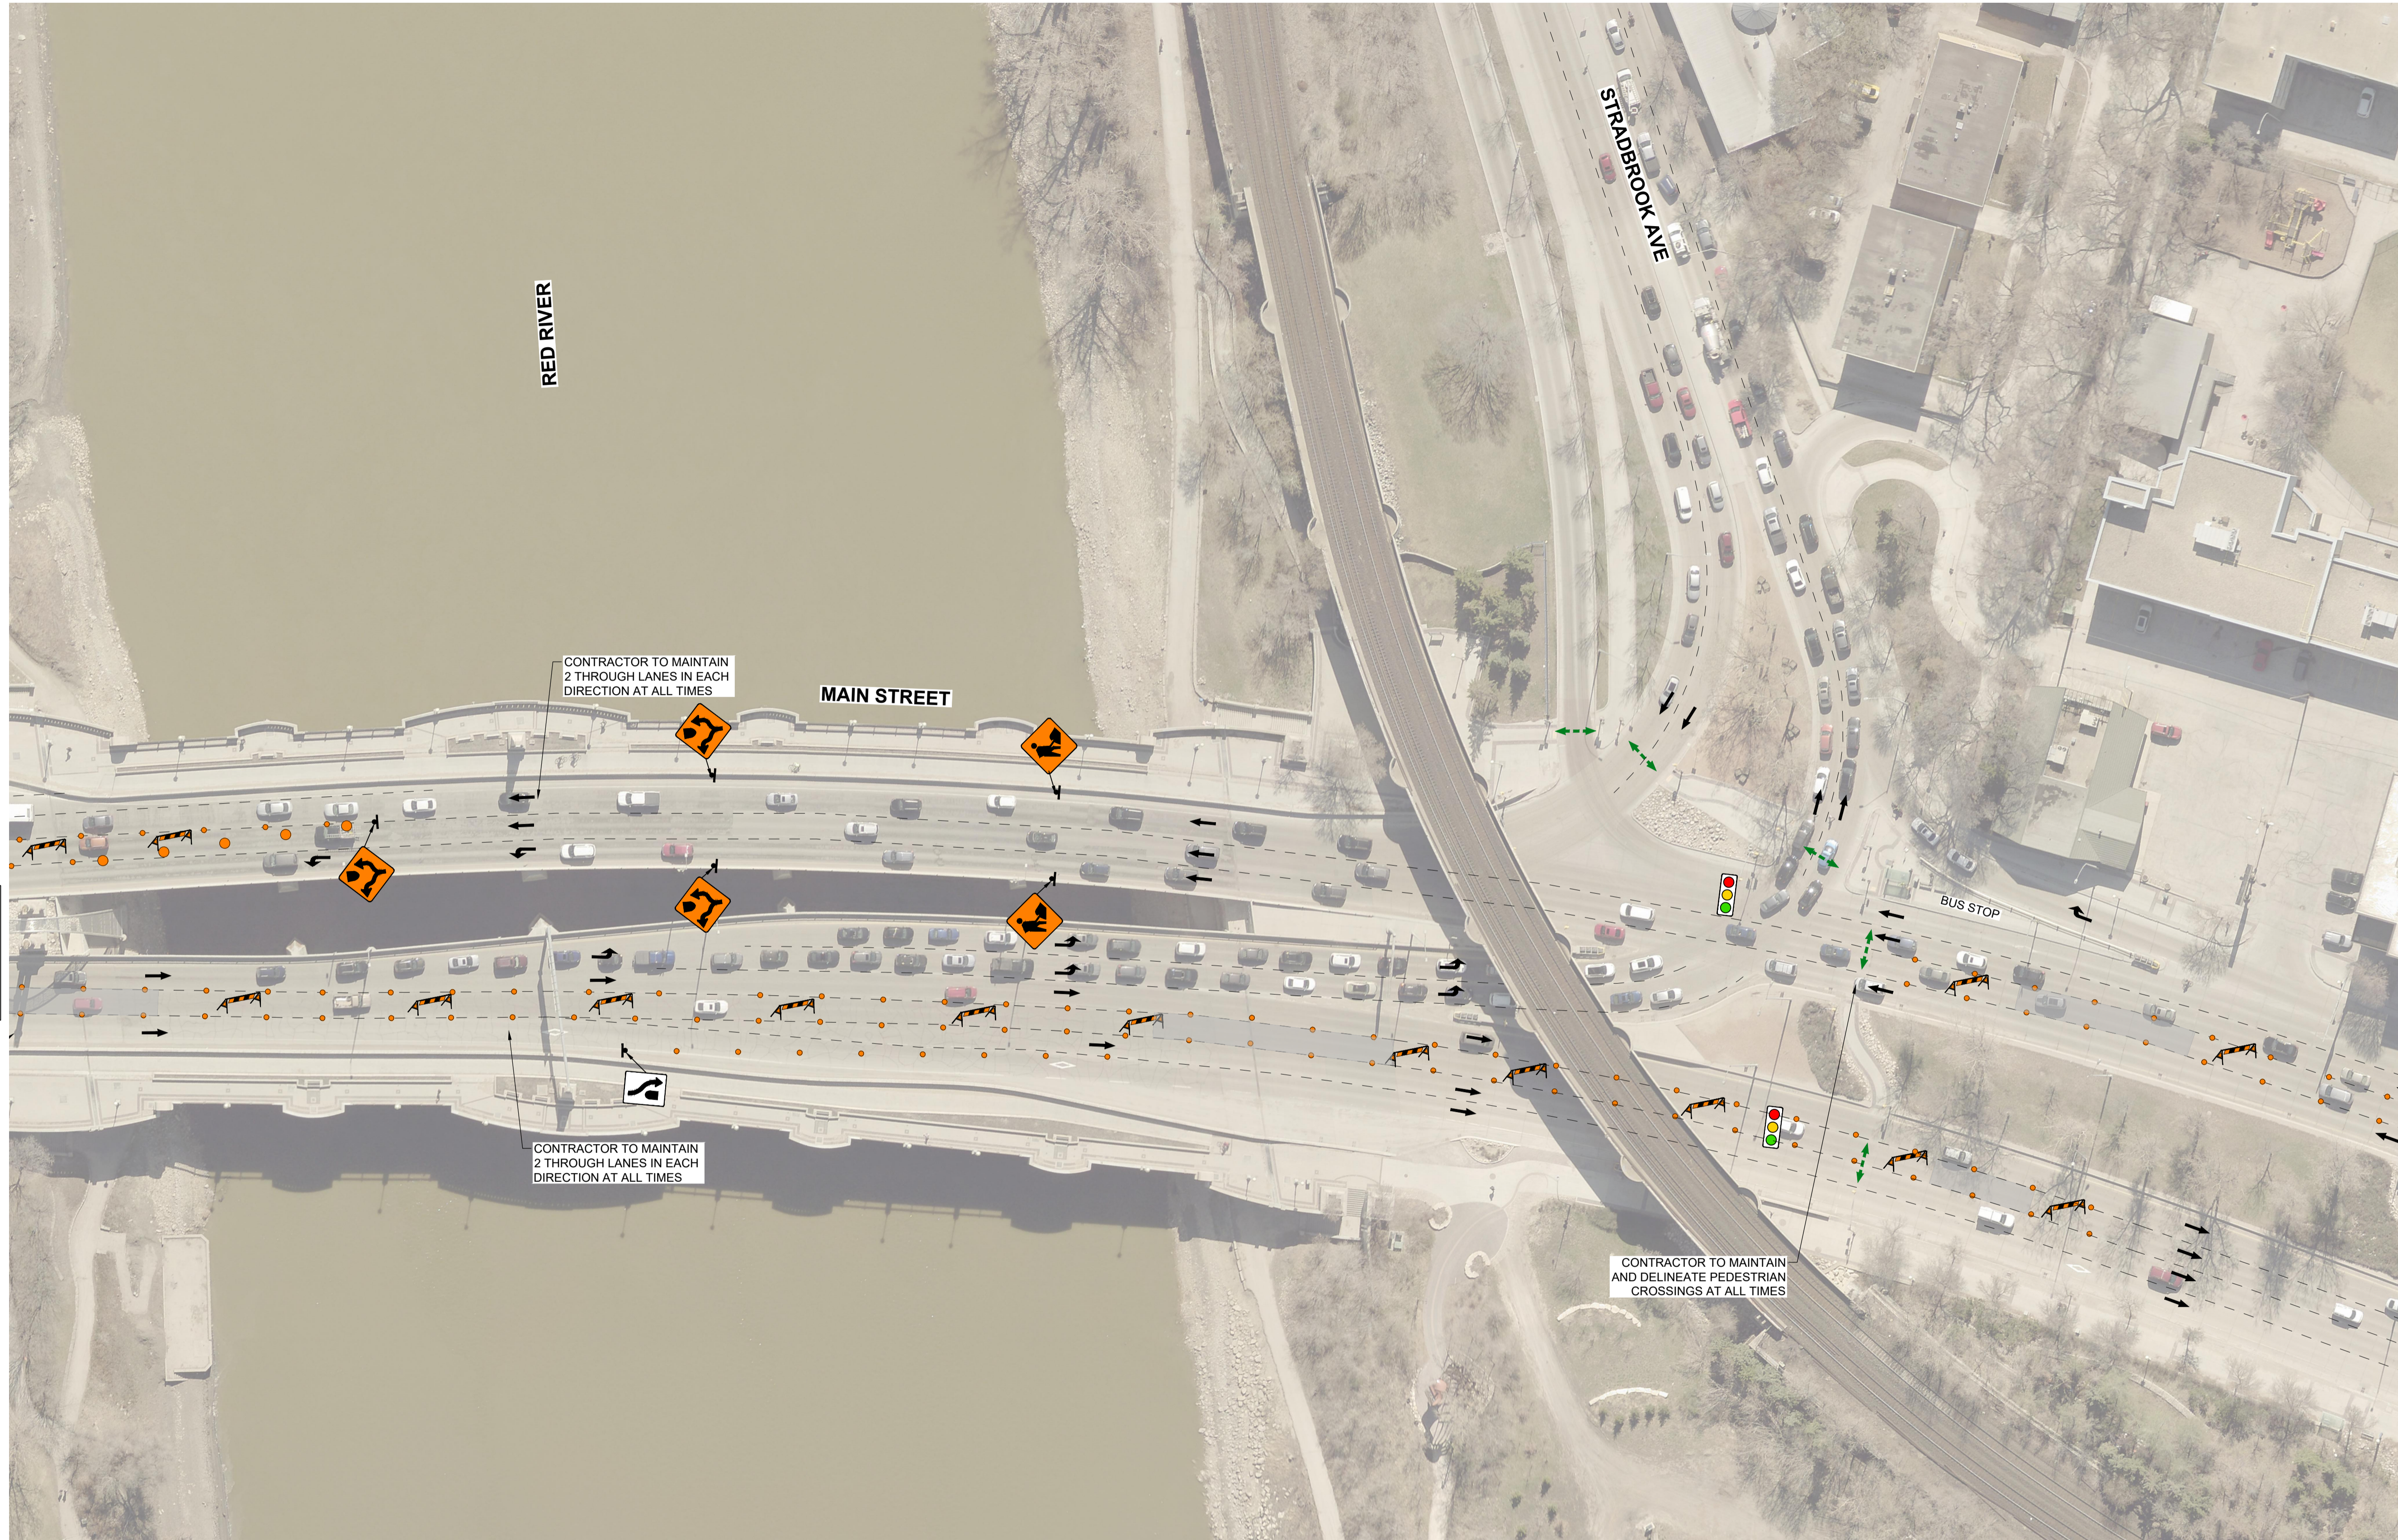

**STAGE 2
MAIN STREET / STRADBROOK AVE (2 OF 3)**

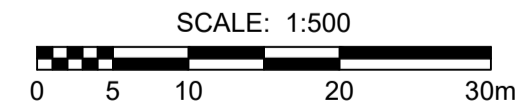

LOCATION APPROVED UNDERGROUND STRUCTURES			
SUPR. U/G STRUCTURES	DATE	COMMITTEE	
NOTE: LOCATION OF UNDERGROUND STRUCTURES AS SHOWN ARE BASED ON THE BEST INFORMATION AVAILABLE BUT NO GUARANTEE IS GIVEN THAT ALL EXISTING UTILITIES ARE SHOWN OR THAT THE GIVEN LOCATIONS ARE EXACT. CONFIRMATION OF EXISTENCE AND EXACT LOCATION OF ALL SERVICES MUST BE OBTAINED FROM THE INDIVIDUAL UTILITIES BEFORE PROCEEDING WITH CONSTRUCTION.			
1	ISSUED FOR ADDENDUM 2	24/06/03	ACK
0	ISSUED FOR TENDER	24/05/09	ACK
No.	REVISIONS	YYMMDD	BY

BM	ELEV		

DESIGNED BY	ACK	CHECKED BY	JGK
DRAWN BY	KMB	APPROVED BY	JGK
HOR SCALE	AS SHOWN	RELEASED FOR CONSTRUCTION	
VERT SCALE	AS SHOWN		
DATE	May 09, 2024	DATE	

PROFESSIONAL'S SEAL
 PROVINCE OF MANITOBA

A.C. KAUFMANN
 Member
 34804
 2024-06-04
 REGISTERED PROFESSIONAL ENGINEER
 CONSULTANT FILE NAME
 2303678-MNB-Staging & Traffic Signage.dwg

 THE CITY OF WINNIPEG PUBLIC WORKS DEPARTMENT ENGINEERING DIVISION		CITY DRAWING NUMBER B-103-24-20 / B-104-24-13
2024 BRIDGE MAINTENANCE MAIN STREET AND NORWOOD BRIDGES TRAFFIC SIGNAGE & STAGING STAGE 2 MAIN STREET / STRADBROOK AVE (2 OF 3)		SHEET 20 OF 31
		DRAWING NUMBER 20

**ENGINEERS
GEOSCIENTISTS
MANITOBA**
 Certificate of Authorization
 MORRISON HERSHFELD
 No. 1736

TENDER No. 291-2024

FOR CONTINUATION SEE DRAWING 19

FOR CONTINUATION SEE DRAWING 21