



GENERAL NOTES:


1. WALL MOUNTED AT ELEV. 233.5m.
2. LSH 152.4mm AFF.
3. H₂S GAS MONITOR WALL MOUNTED AT 600mm AFF.
4. METHANE GAS MONITOR WALL MOUNTED AT 150mm BELOW CEILING.
5. PROVIDE AND INSTALL NEW SS 1/4" TEST LINE COMPLETE WITH SPACERS AND COUPLERS FOR TESTING SENSOR. PROVIDE METHANE GAS CALIBRATION KIT FOR TESTING PURPOSES.

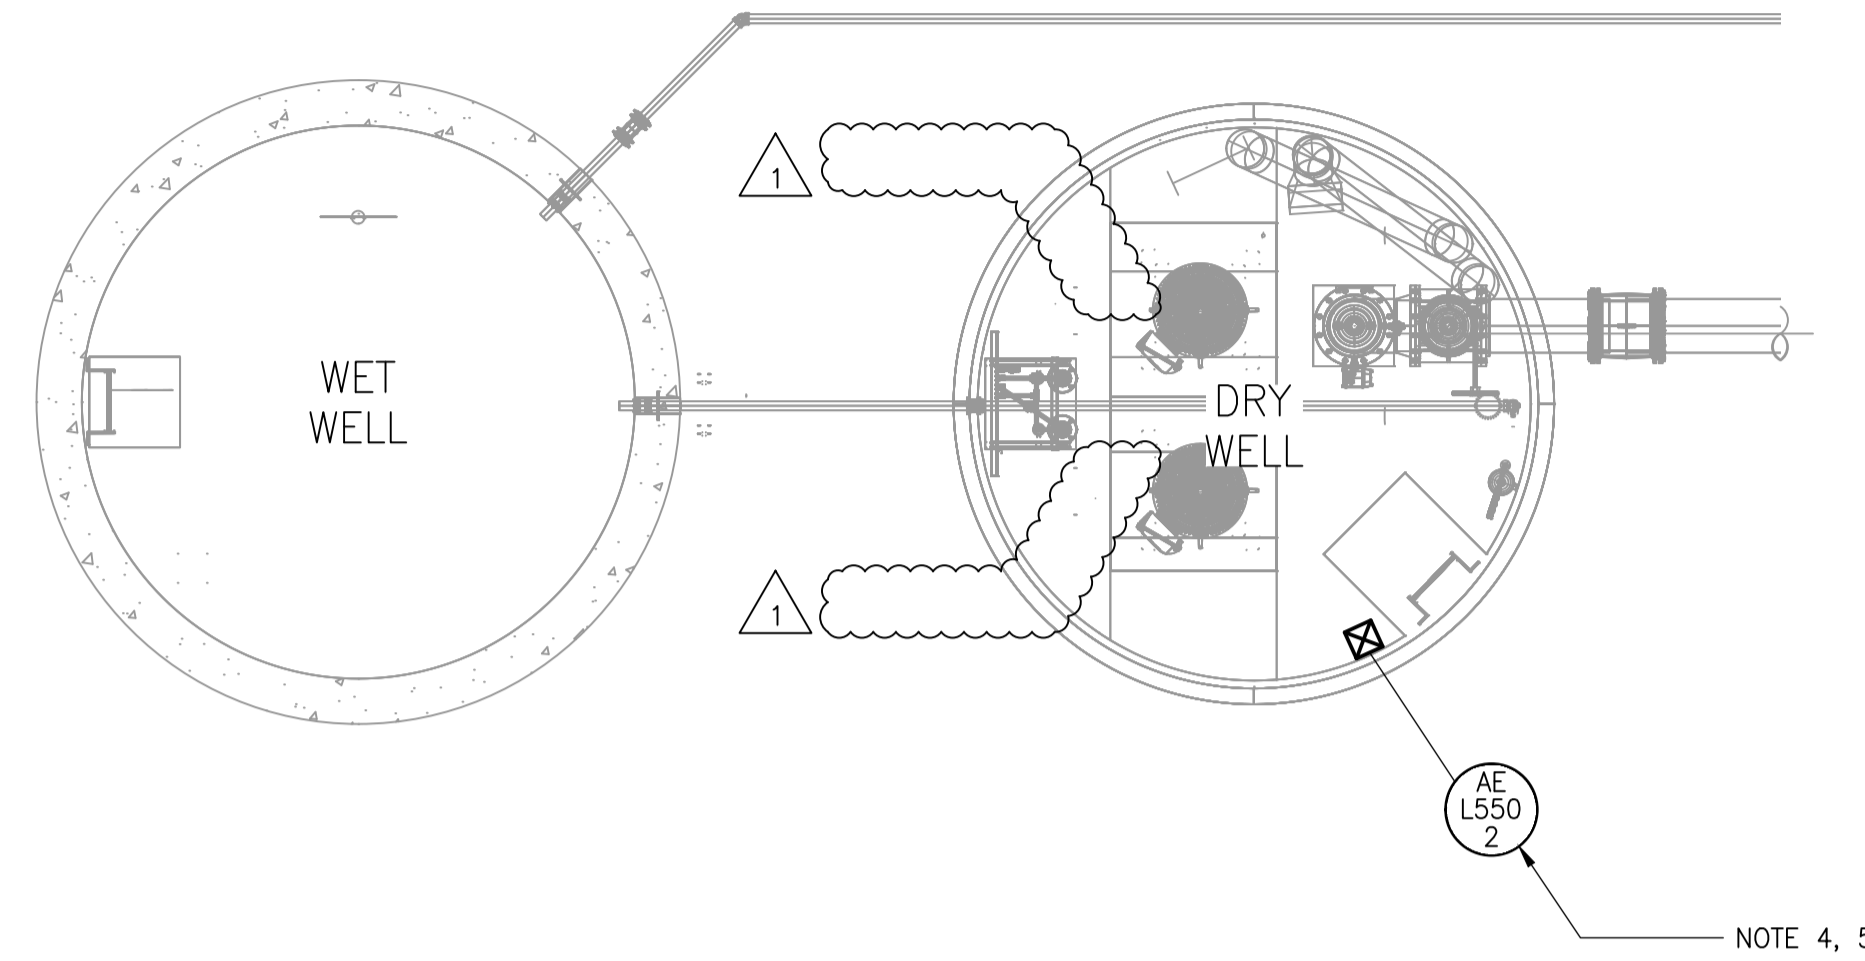


1 PLAN – WET WELL AND SUB-LEVEL 1 – ELEVATION 236.5m
SCALE: 1:50

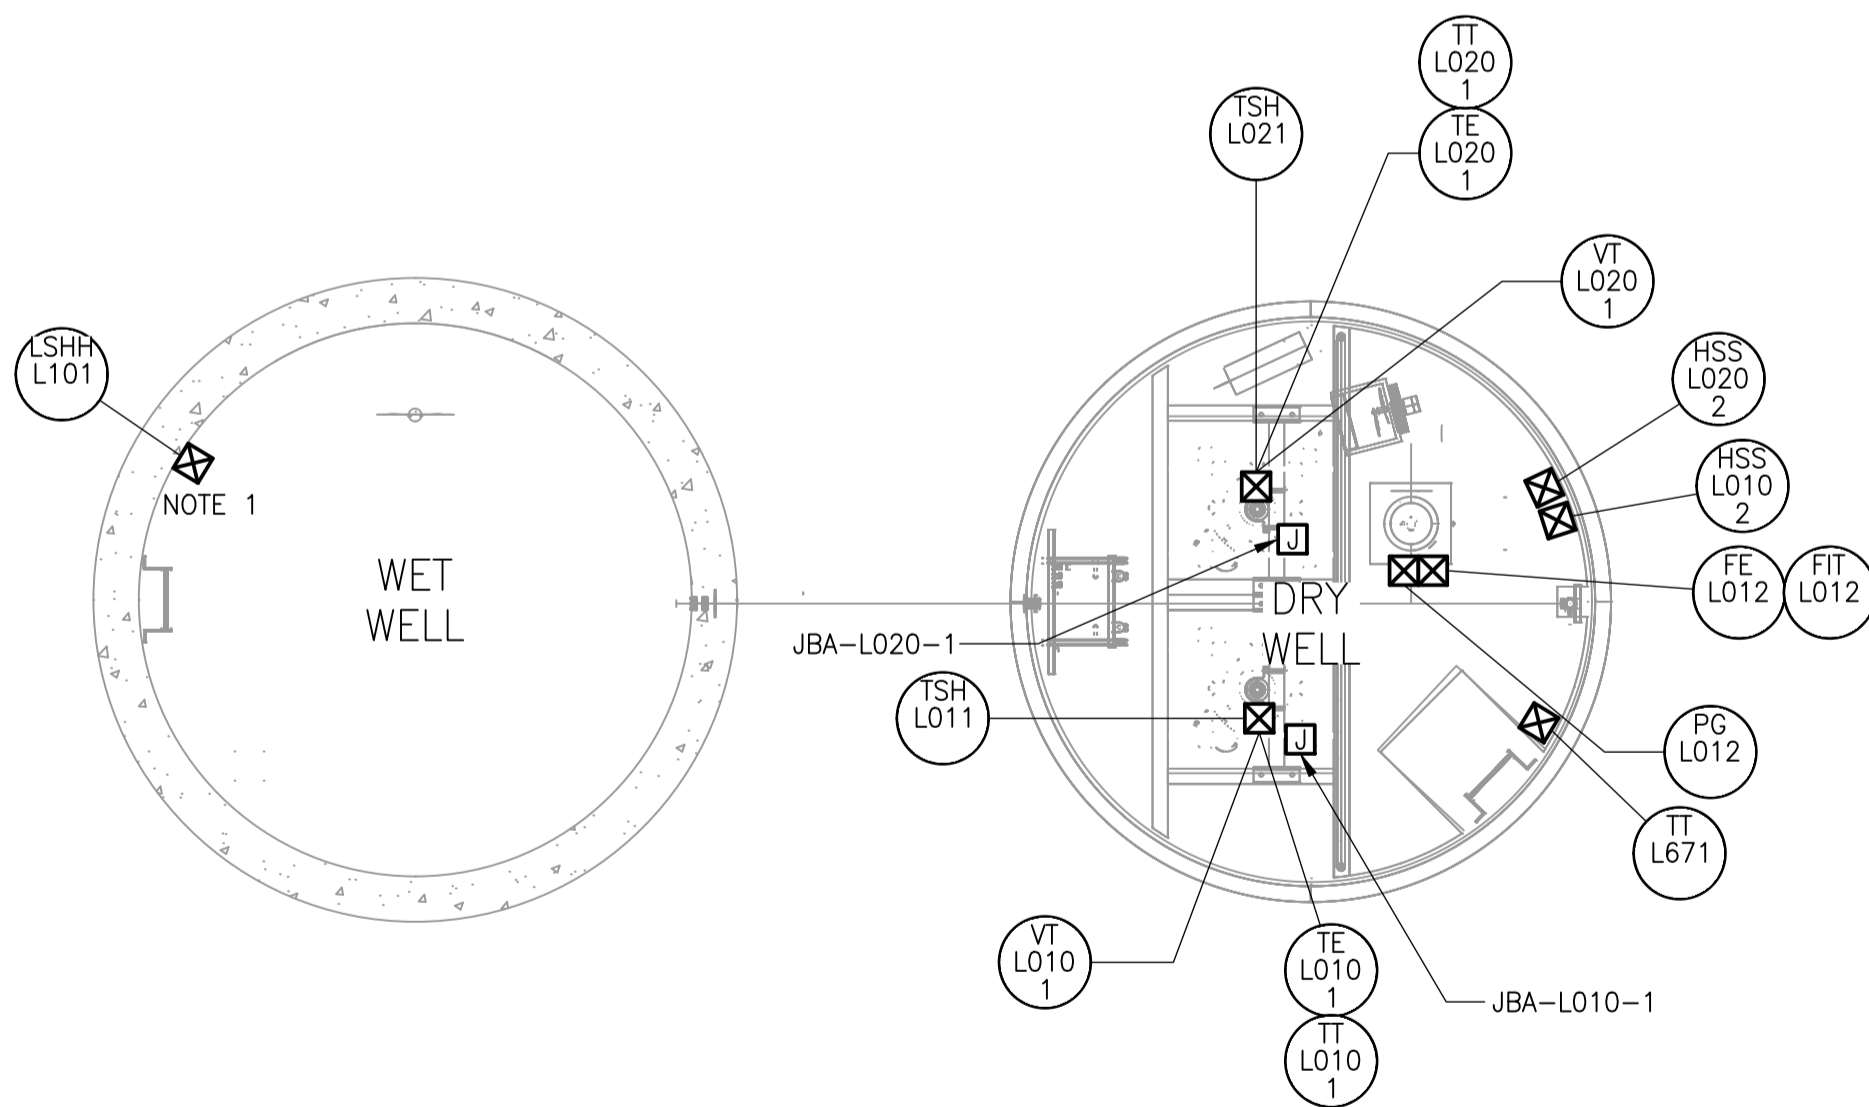

2 PLAN – WET WELL AND SUB-LEVEL 2 – ELEVATION 233m
SCALE: 1:50

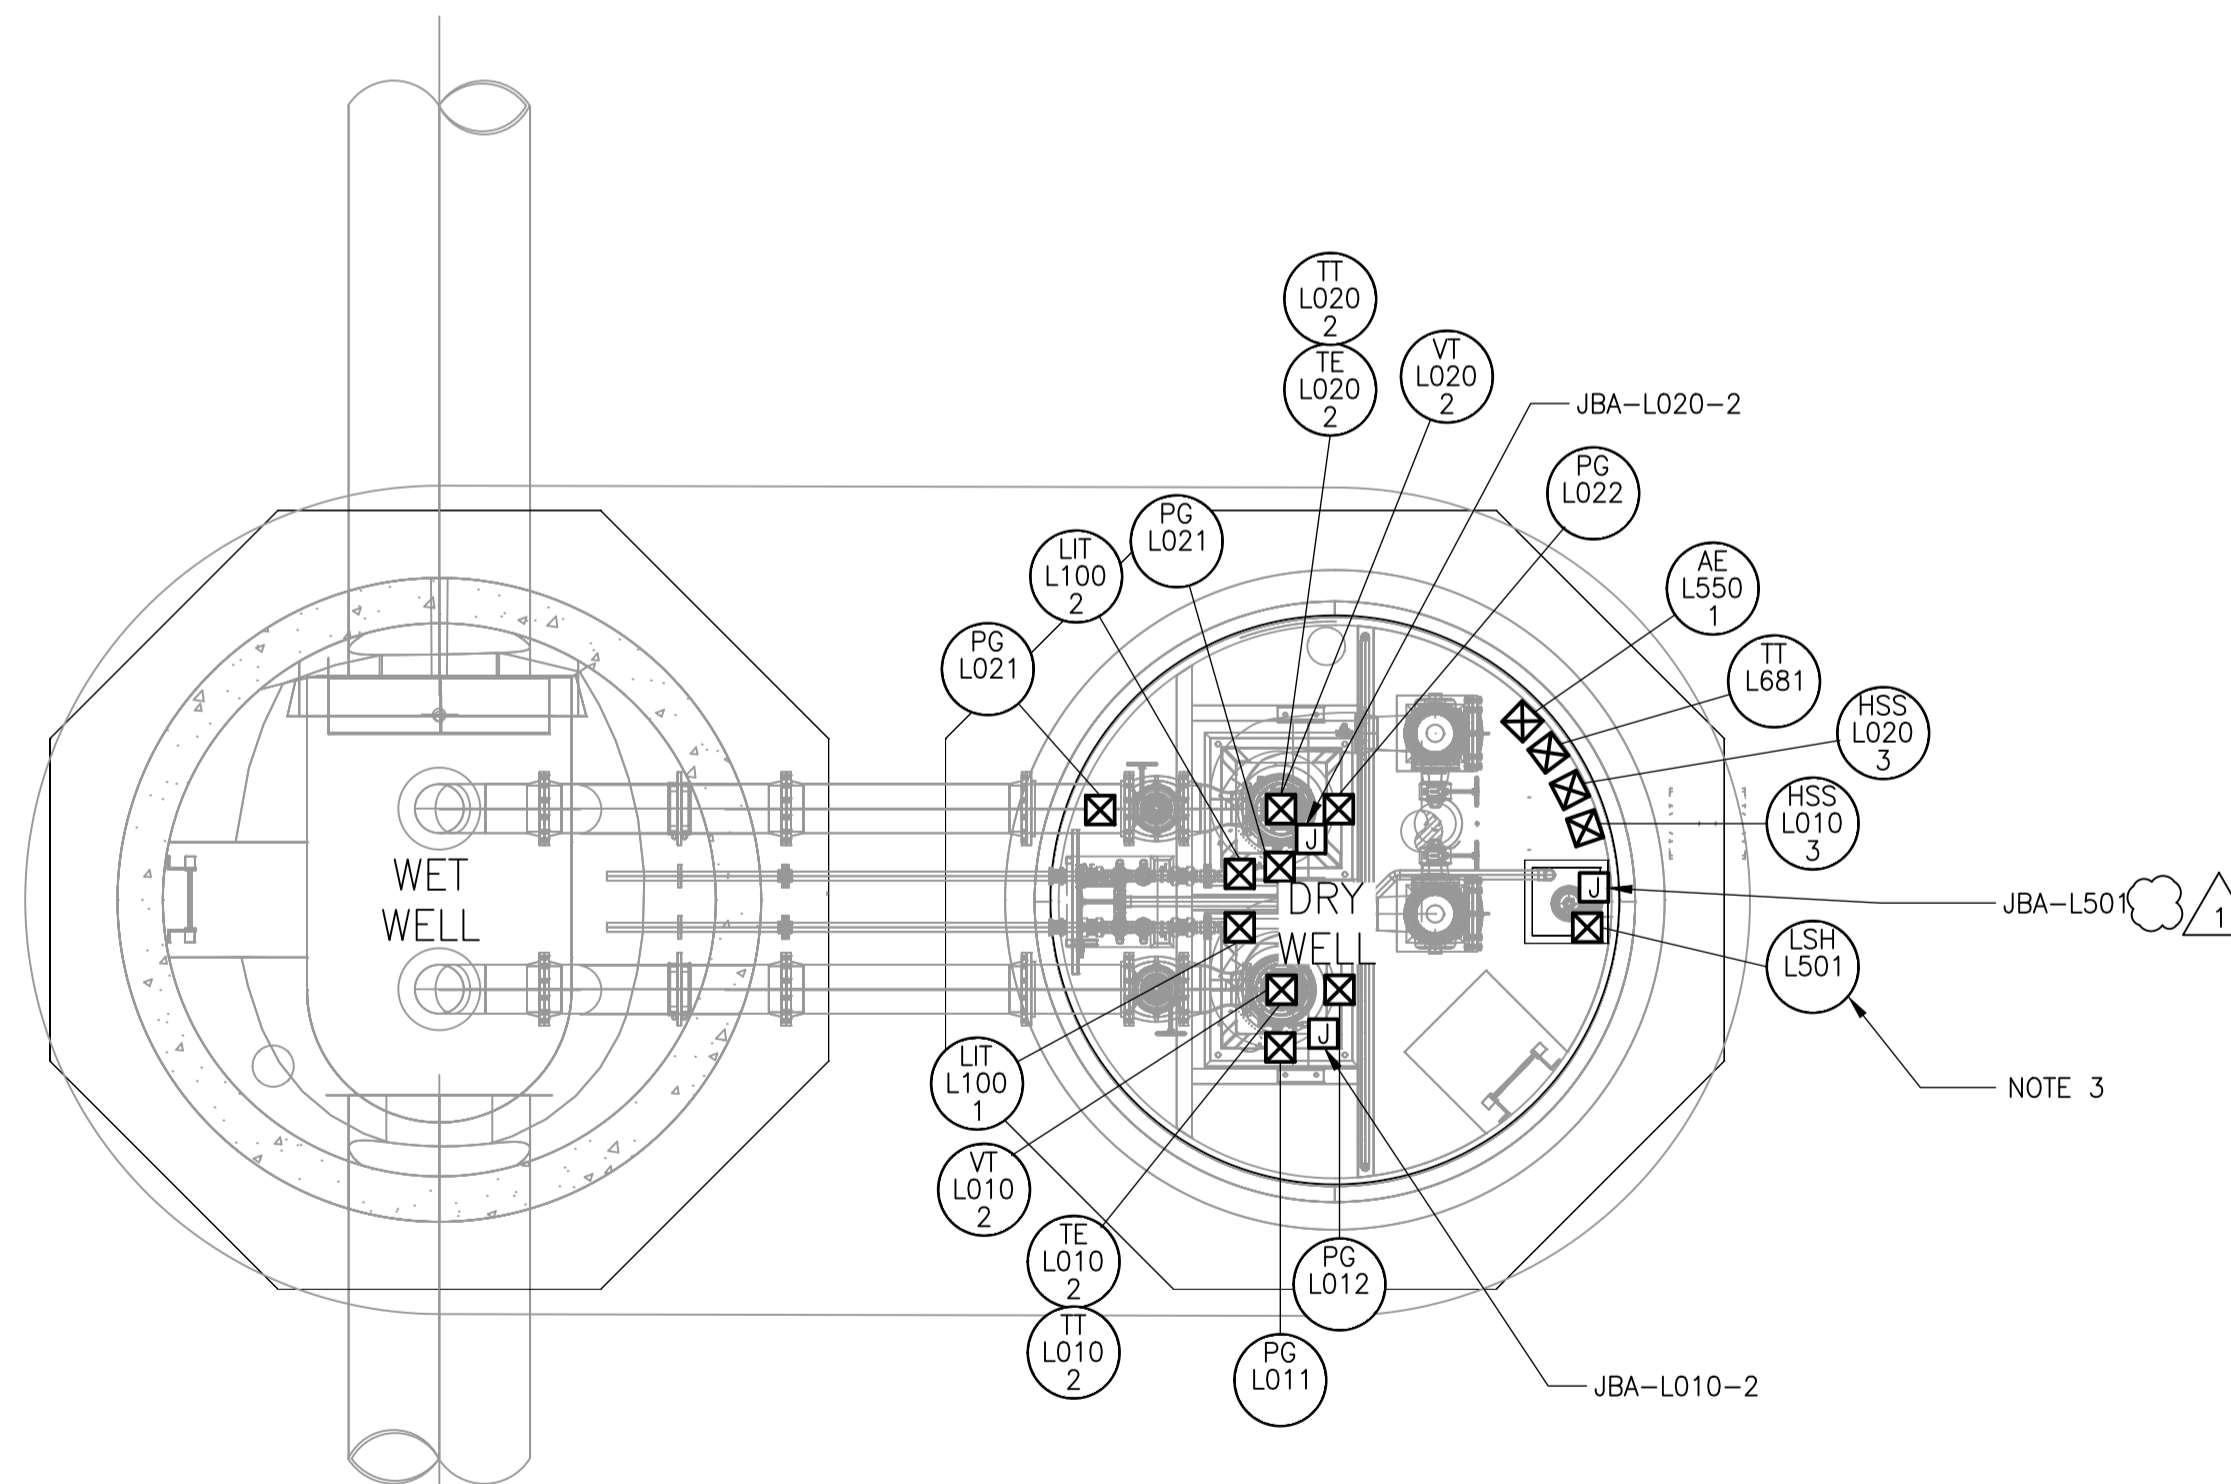

3 PLAN – WET WELL AND SUB-LEVEL 5 – ELEVATION 224.437m
SCALE: 1:50

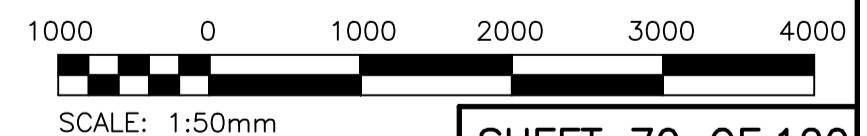

10	-	-
9	-	-
8	-	-
7	-	-
6	-	-
5	-	-
4	-	-
3	-	-
2	-	-
1	-	-
NO.	DRAWING NUMBER	REFERENCE DRAWING TITLE
REFERENCE DRAWINGS		

FOR TENDER ONLY
NOT TO BE USED FOR CONSTRUCTION



B.M. ELEV.			
CONSTRUCTION COMPLETION DATE: YYYY MM DD			
NO.	REVISIONS	DATE	BY
1	ISSUED FOR ADDENDUM 2	2024 07 12	DDW
0	ISSUED FOR TENDER	2024 06 20	DDW

KGS GROUP	
DESIGNED BY: A. SAVIGNAC	CHECKED BY: D. WILSON
DRAWN BY: D. SHABATAEV	APPROVED BY: D. WILSON
SCALE: AS SHOWN	RELEASED FOR CONSTRUCTION
DATE: 2023 12 01	DATE:

ENGINEER'S SEAL
CONSULTANT DRAWING NUMBER
23-0107-009_A2.1

THE CITY OF WINNIPEG
WATER AND WASTE DEPARTMENT
ENGINEERING DIVISION

CONSTRUCTION OF A NEW WASTEWATER LIFT STATION – CENTREPORT SOUTH
REGIONAL WATER AND WASTEWATER SERVICING PHASE 1A (CONTRACT 1A)
AUTOMATION
PLAN LAYOUT
SUB-LEVELS – WET WELL AND DRY WELL

CITY DRAWING NUMBER	1-0241L-A0002-001	SHEET 1 OF 1
---------------------	-------------------	--------------