


 \triangleleft

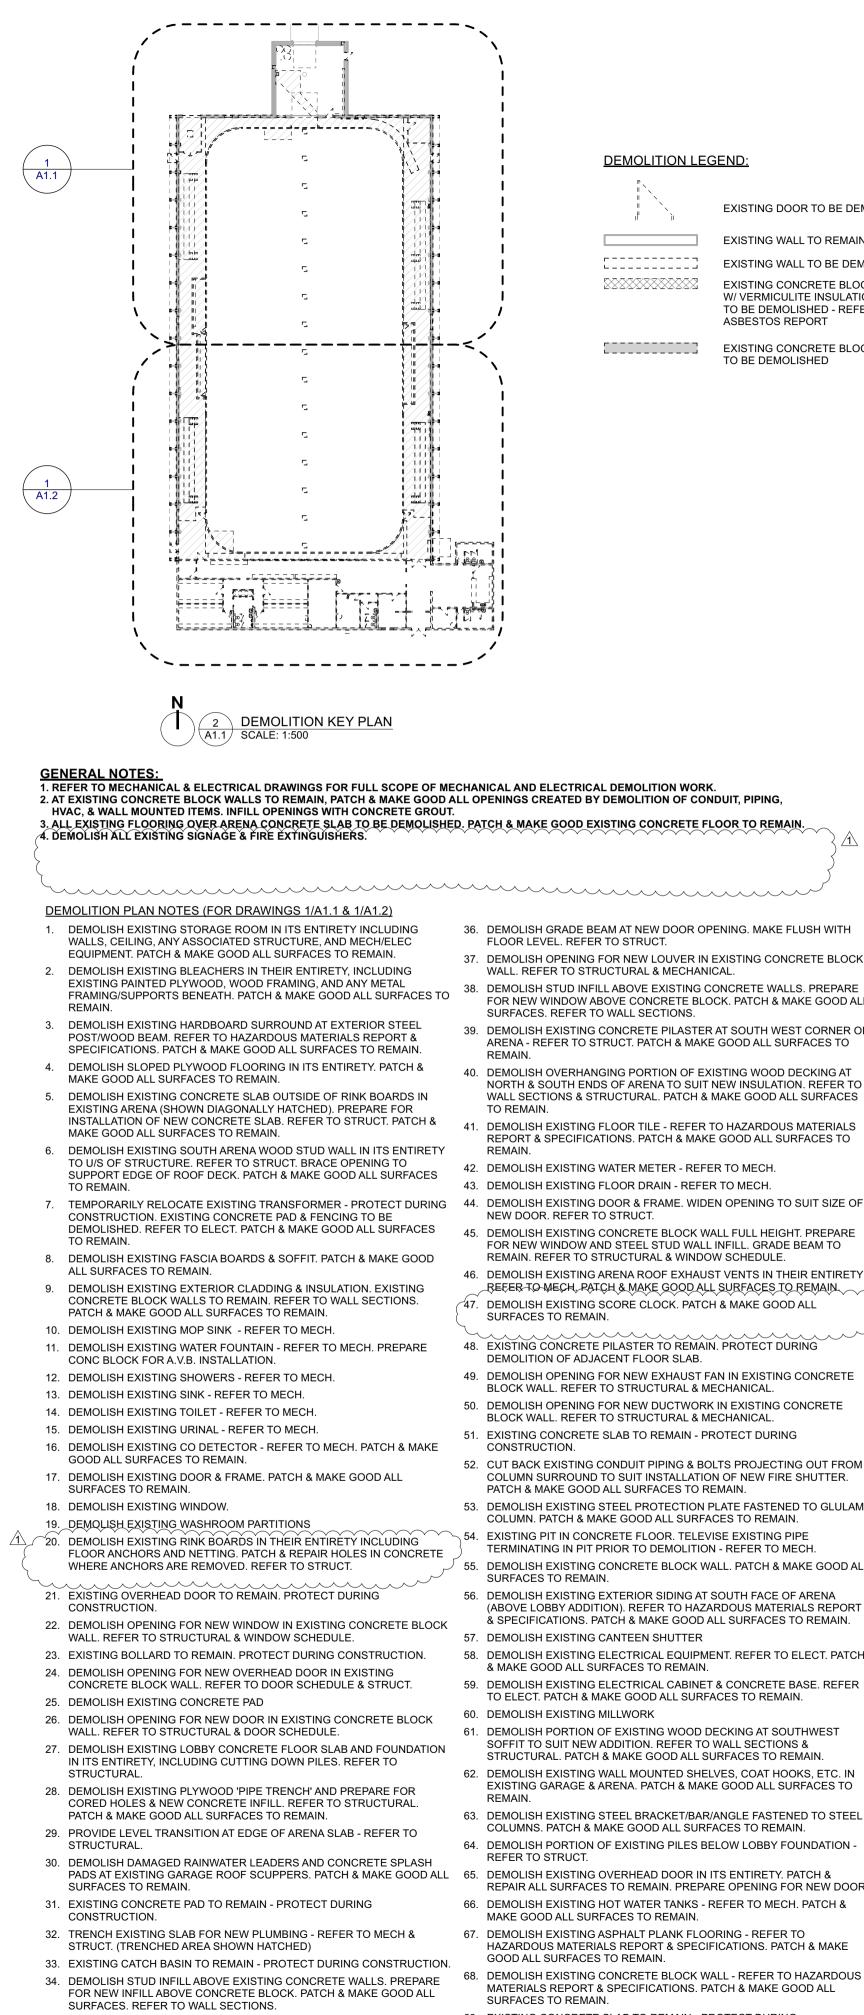

- 35. DEMOLISH EXISTING MOTORIZED, VERTICALLY RISING RINK GATE IN ITS ENTIRETY INCLUDING STEEL FRAMES, MOTOR/ELECTRICAL CONNECTIONS, AND ALL FLOOR, WALL, AND CEILING ANCHORS, PATCH & REPAIR ANY HOLES WHERE ANCHORS ARE REMOVED.
- 69. EXISTING CONCRETE SLAB TO REMAIN PROTECT DURING CONSTRUCTION. PREPARE FLOOR FOR INSTALLATION OF NEW RESILIENT TILE & SHEET FLOORING WHERE SCHEDULED- REFER TO ROOM SCHEDULE & FINISH PLANS.

- NEW DOOR. REFER TO STRUCT.
- BLOCK WALL. REFER TO STRUCTURAL & MECHANICAL. 51. EXISTING CONCRETE SLAB TO REMAIN - PROTECT DURING
- PATCH & MAKE GOOD ALL SURFACES TO REMAIN. 53. DEMOLISH EXISTING STEEL PROTECTION PLATE FASTENED TO GLULAM COLUMN. PATCH & MAKE GOOD ALL SURFACES TO REMAIN. 54. EXISTING PIT IN CONCRETE FLOOR. TELEVISE EXISTING PIPE
- SURFACES TO REMAIN.
- 56. DEMOLISH EXISTING EXTERIOR SIDING AT SOUTH FACE OF ARENA (ABOVE LOBBY ADDITION). REFER TO HAZARDOUS MATERIALS REPORT & SPECIFICATIONS. PATCH & MAKE GOOD ALL SURFACES TO REMAIN. 57. DEMOLISH EXISTING CANTEEN SHUTTER
- 58. DEMOLISH EXISTING ELECTRICAL EQUIPMENT. REFER TO ELECT. PATCH & MAKE GOOD ALL SURFACES TO REMAIN. 59. DEMOLISH EXISTING ELECTRICAL CABINET & CONCRETE BASE. REFER TO ELECT. PATCH & MAKE GOOD ALL SURFACES TO REMAIN.

- SOFFIT TO SUIT NEW ADDITION. REFER TO WALL SECTIONS & STRUCTURAL. PATCH & MAKE GOOD ALL SURFACES TO REMAIN. 62. DEMOLISH EXISTING WALL MOUNTED SHELVES, COAT HOOKS, ETC. IN EXISTING GARAGE & ARENA. PATCH & MAKE GOOD ALL SURFACES TO
- 63. DEMOLISH EXISTING STEEL BRACKET/BAR/ANGLE FASTENED TO STEEL COLUMNS. PATCH & MAKE GOOD ALL SURFACES TO REMAIN. 64. DEMOLISH PORTION OF EXISTING PILES BELOW LOBBY FOUNDATION -
- REFER TO STRUCT.
- 65. DEMOLISH EXISTING OVERHEAD DOOR IN ITS ENTIRETY. PATCH & REPAIR ALL SURFACES TO REMAIN. PREPARE OPENING FOR NEW DOOR. 66. DEMOLISH EXISTING HOT WATER TANKS - REFER TO MECH. PATCH & MAKE GOOD ALL SURFACES TO REMAIN.
- 67. DEMOLISH EXISTING ASPHALT PLANK FLOORING REFER TO HAZARDOUS MATERIALS REPORT & SPECIFICATIONS. PATCH & MAKE GOOD ALL SURFACES TO REMAIN.
- 68. DEMOLISH EXISTING CONCRETE BLOCK WALL REFER TO HAZARDOUS MATERIALS REPORT & SPECIFICATIONS. PATCH & MAKE GOOD ALL SURFACES TO REMAIN.

DEMOLITION LEGEND

r-----L_____

EXISTING DOOR TO BE DEMOLISHED EXISTING WALL TO REMAIN

EXISTING WALL TO BE DEMOLISHED EXISTING CONCRETE BLOCK WALL W/ VERMICULITE INSULATION

TO BE DEMOLISHED - REFER TO ASBESTOS REPORT EXISTING CONCRETE BLOCK WALL TO BE DEMOLISHED

36. DEMOLISH GRADE BEAM AT NEW DOOR OPENING. MAKE FLUSH WITH 37. DEMOLISH OPENING FOR NEW LOUVER IN EXISTING CONCRETE BLOCK

38. DEMOLISH STUD INFILL ABOVE EXISTING CONCRETE WALLS. PREPARE FOR NEW WINDOW ABOVE CONCRETE BLOCK. PATCH & MAKE GOOD ALL SURFACES. REFER TO WALL SECTIONS.


39. DEMOLISH EXISTING CONCRETE PILASTER AT SOUTH WEST CORNER OF ARENA - REFER TO STRUCT. PATCH & MAKE GOOD ALL SURFACES TO

40. DEMOLISH OVERHANGING PORTION OF EXISTING WOOD DECKING AT NORTH & SOUTH ENDS OF ARENA TO SUIT NEW INSULATION. REFER TO WALL SECTIONS & STRUCTURAL. PATCH & MAKE GOOD ALL SURFACES

41. DEMOLISH EXISTING FLOOR TILE - REFER TO HAZARDOUS MATERIALS REPORT & SPECIFICATIONS. PATCH & MAKE GOOD ALL SURFACES TO

- 42. DEMOLISH EXISTING WATER METER REFER TO MECH.
- 43. DEMOLISH EXISTING FLOOR DRAIN REFER TO MECH.
- 45. DEMOLISH EXISTING CONCRETE BLOCK WALL FULL HEIGHT. PREPARE FOR NEW WINDOW AND STEEL STUD WALL INFILL. GRADE BEAM TO REMAIN. REFER TO STRUCTURAL & WINDOW SCHEDULE.
- 46. DEMOLISH EXISTING ARENA ROOF EXHAUST VENTS IN THEIR ENTIRETY -REFER TO MECH, PATCH & MAKE GOOD ALL SURFACES TO REMAIN. 47. DEMOLISH EXISTING SCORE CLOCK. PATCH & MAKE GOOD ALL
- 48. EXISTING CONCRETE PILASTER TO REMAIN. PROTECT DURING DEMOLITION OF ADJACENT FLOOR SLAB.
- 49. DEMOLISH OPENING FOR NEW EXHAUST FAN IN EXISTING CONCRETE BLOCK WALL. REFER TO STRUCTURAL & MECHANICAL. 50. DEMOLISH OPENING FOR NEW DUCTWORK IN EXISTING CONCRETE
- 52. CUT BACK EXISTING CONDUIT PIPING & BOLTS PROJECTING OUT FROM COLUMN SURROUND TO SUIT INSTALLATION OF NEW FIRE SHUTTER.
- TERMINATING IN PIT PRIOR TO DEMOLITION REFER TO MECH. 55. DEMOLISH EXISTING CONCRETE BLOCK WALL. PATCH & MAKE GOOD ALL
- 61. DEMOLISH PORTION OF EXISTING WOOD DECKING AT SOUTHWEST

architecture inc.

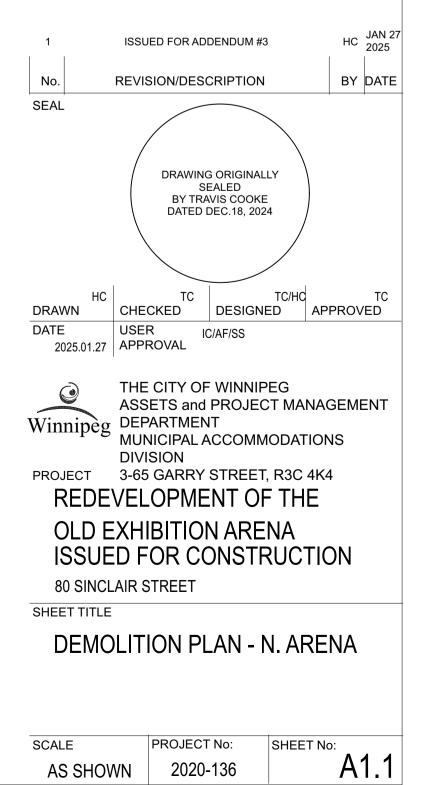

DRAWING SHEET SIZE: A1 (841mm x 594mm) PLOT 1:1