


NOTES:

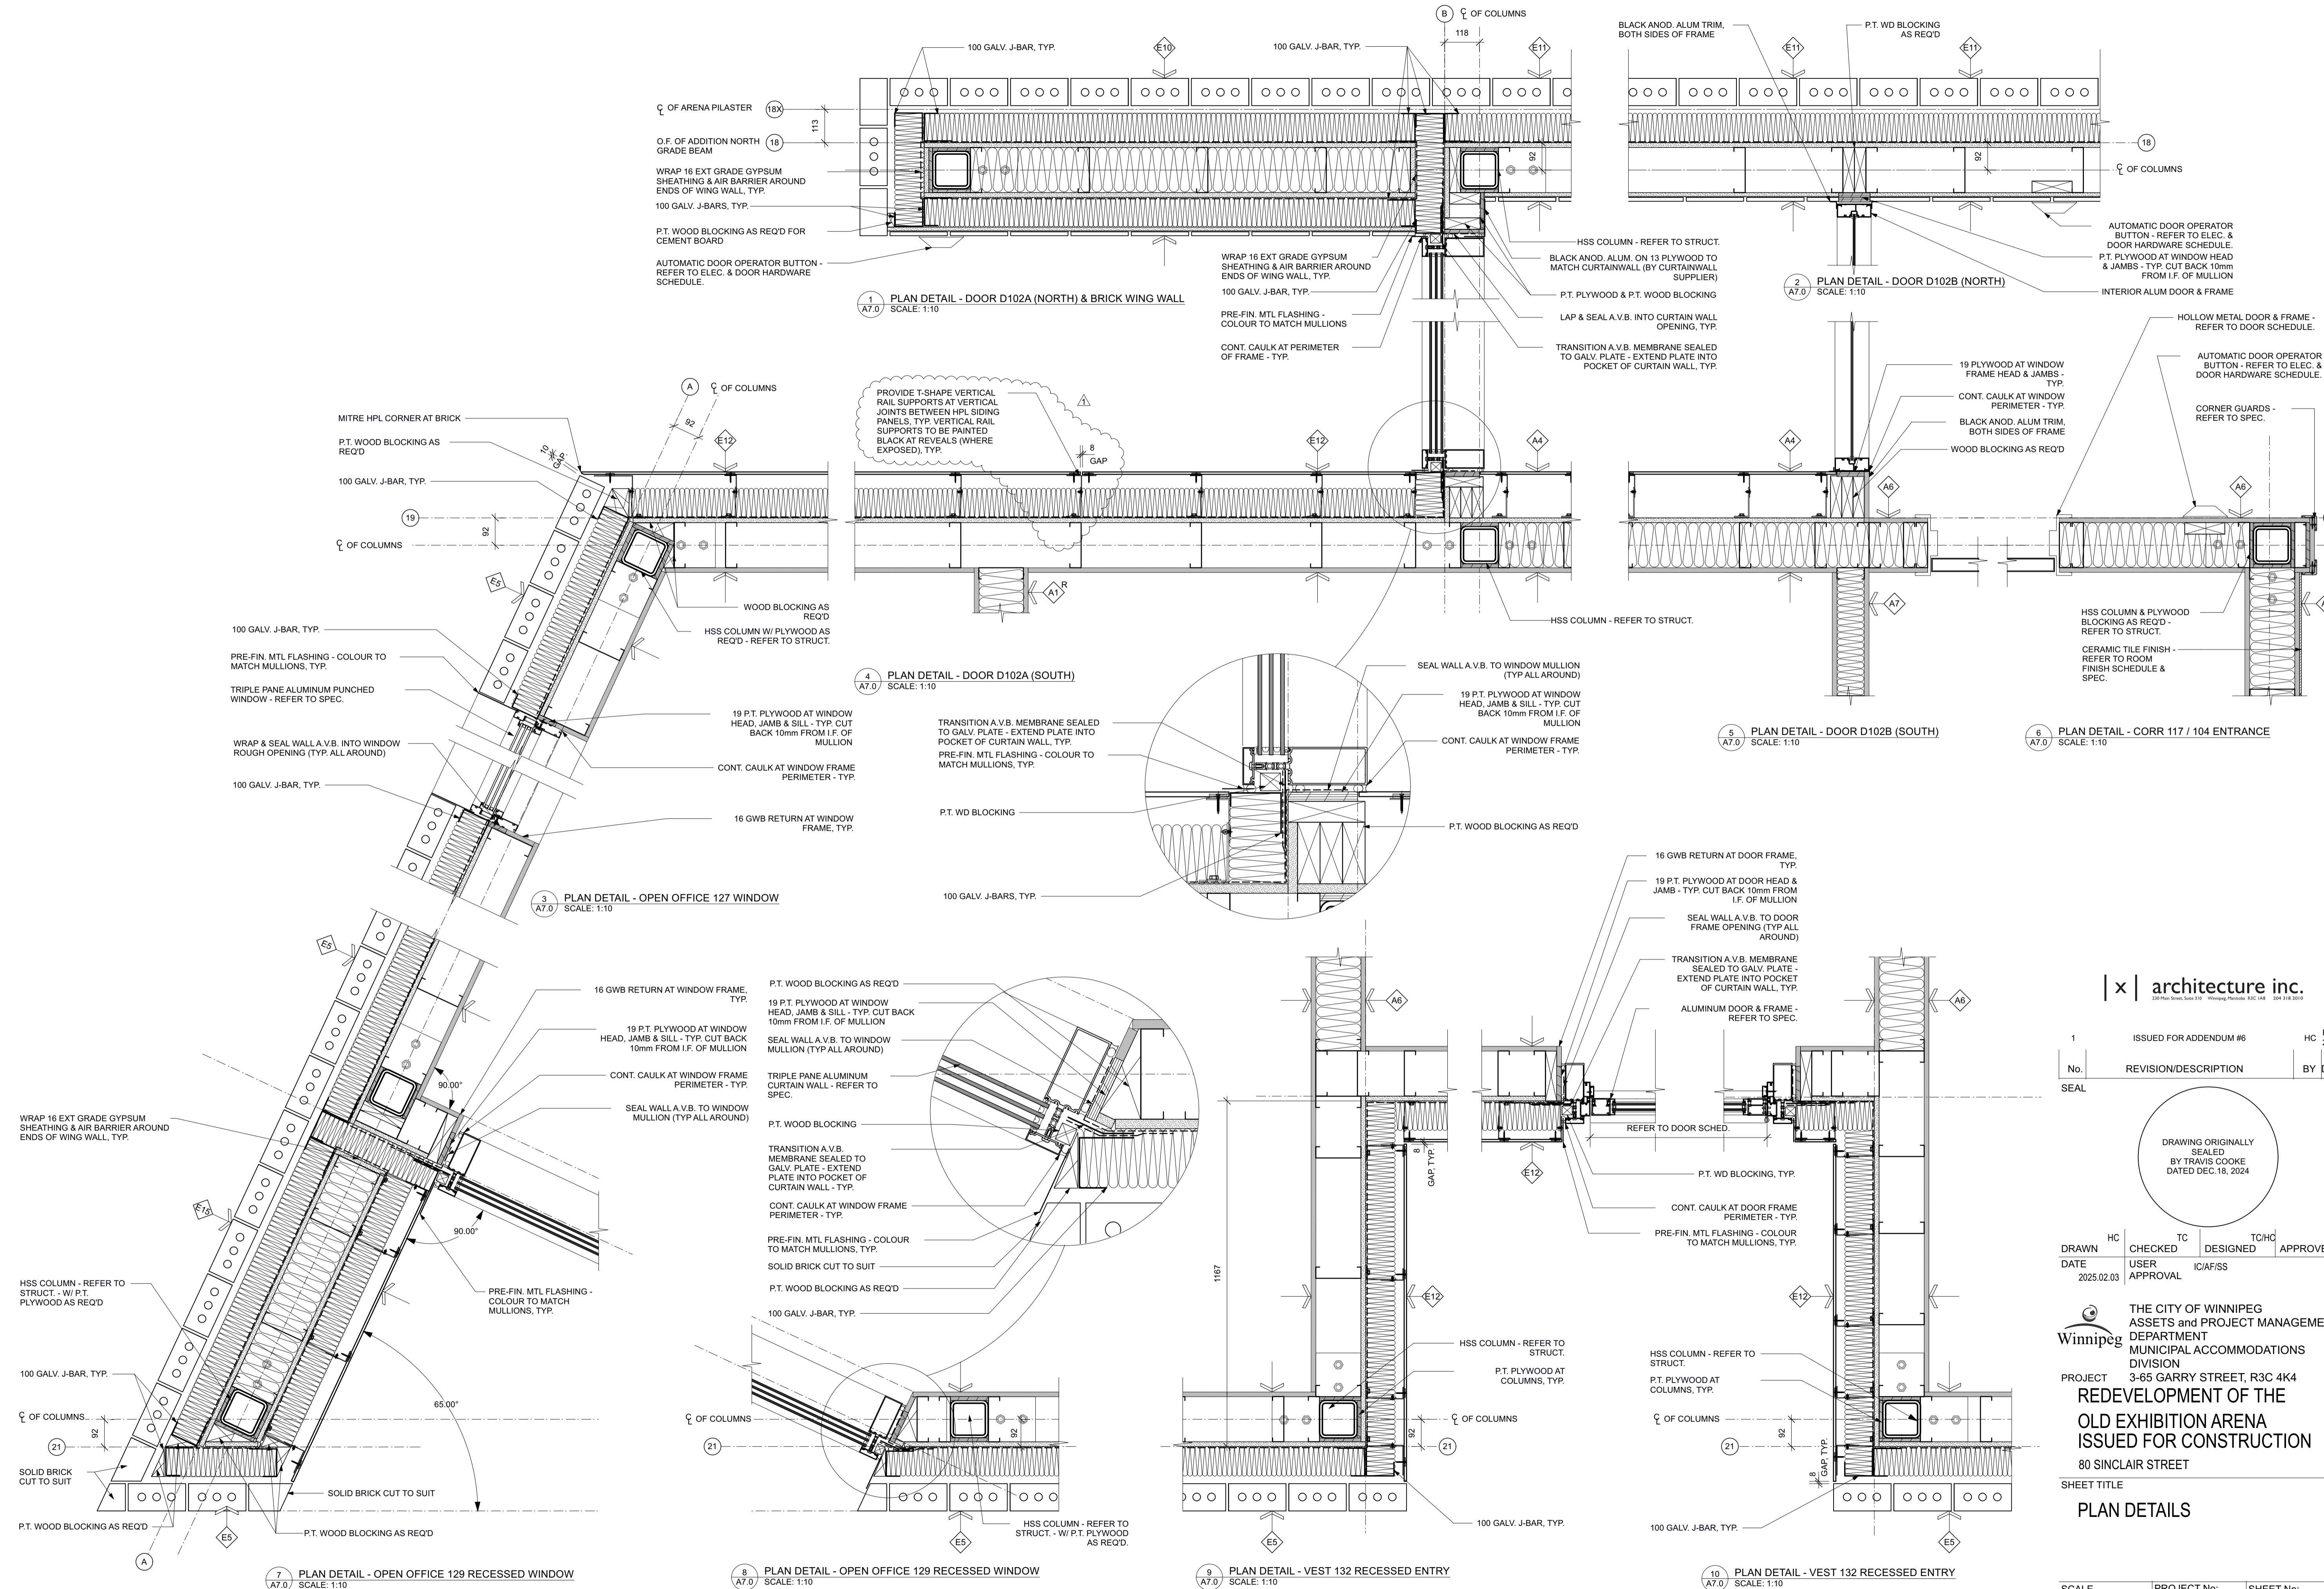

x | architecture inc.  
237 Main Street, Suite 210 Winnipeg, Manitoba, R3C 1A6 204 318 2010

No.	REVISION/DESCRIPTION	BY	DATE
1	ISSUED FOR ADDENDUM #6	HC	FEB 3 2025
SEAL			

DRAWING ORIGINALLY SEALED BY TRAVIS COOKE DATED DEC. 18, 2024

DRAWN	HC	CHECKED	TC	DESIGNED	TCHC	APPROVED	TC
DATE	2025.02.03	USER APPROVAL		IC/AF/SS			

THE CITY OF WINNIPEG  
ASSETS and PROJECT MANAGEMENT  
DEPARTMENT  
MUNICIPAL ACCOMMODATIONS  
DIVISION  
PROJECT  
3-65 GARRY STREET, R3C 4K4  
**REDEVELOPMENT OF THE  
OLD EXHIBITION ARENA  
ISSUED FOR CONSTRUCTION**  
80 SINCLAIR STREET

SHEET TITLE  
**PLAN DETAILS**

SCALE	PROJECT No:	SHEET No:
AS SHOWN	2020-136	<b>A7.0</b>