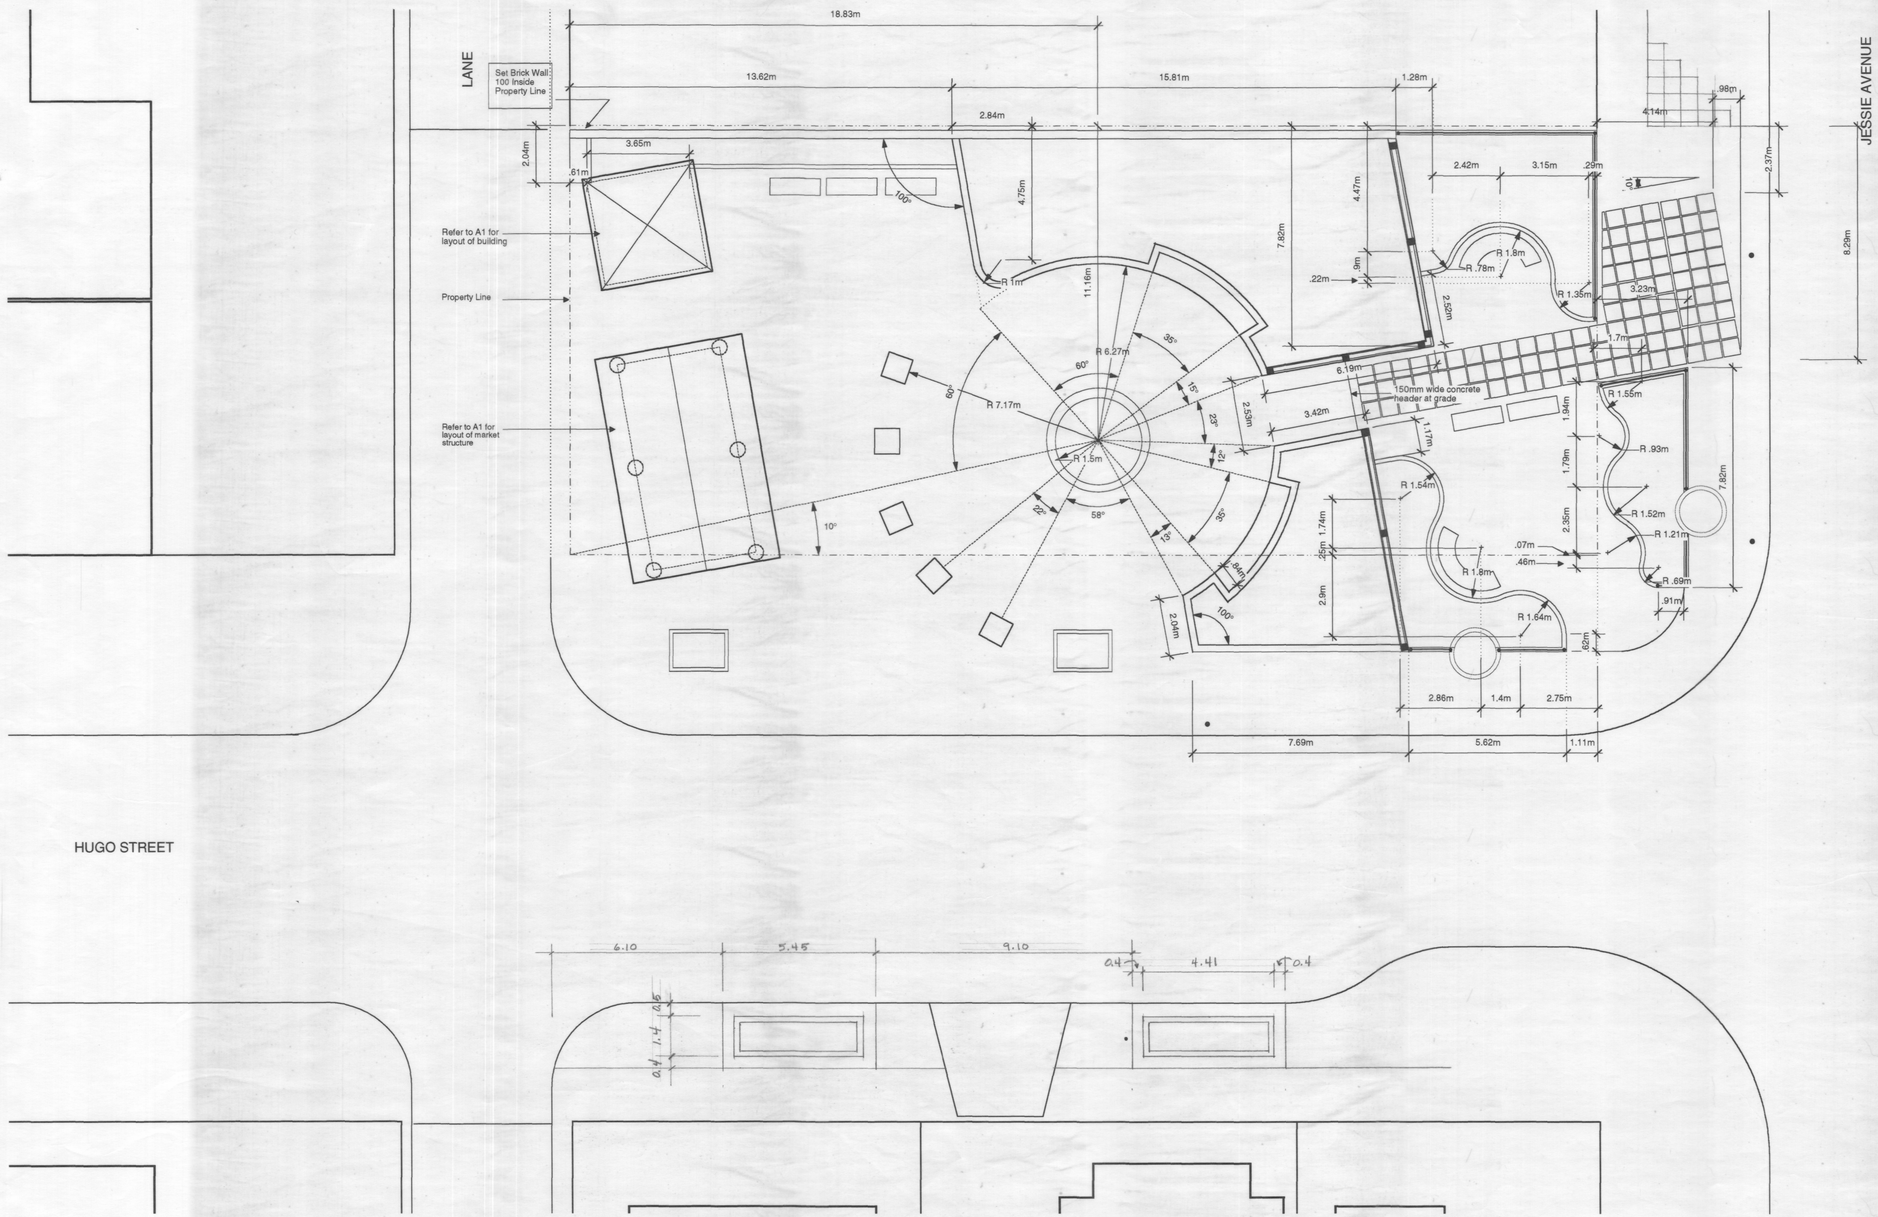

HUGO STREET

1 / L2 Layout Plan

1 : 100

Drawings and specifications as instruments of service, are the property of theLandscape Architect, the copyright in the same being reserved to him / her. No reproductions may be made without the permission of the Landscape Architect and when made, must bear his / her name. All prints to be returned to the Landscape Architect on request.

This drawing shall not be used for building purposes until countersigned by the Landscape Architect.

The contractor shall check all dimensions and other data on site and report any discrepancies to the Landscape Architect.

Figured dimensions to be taken in preference to scaled dimensions.

If in doubt please ask.

Notes

Layout to be confirmed on-site by Landscape Architect prior to construction.

Site furnishings shall be located on-site by Landscape Architect.

Refer to A1 for Layout of Artist's Frieze, Storage Building, Market Structure and Piles.

EXISTING	LEGEND - PLAN	PROPOSED	EXISTING	LEGEND - PLAN	PROPOSED	EXISTING	LEGEND - PROFILE	PROPOSED
	WATERMAIN			HYDRO		150mm W.M.	WATERMAIN	150mm W.M.
	HYDRANT			M.T.S.			HYDRANT	
	VALVE			CONCRETE			VALVE	
	LAND DRAINAGE SEWER			ASPHALT		300mm L.D.S.	LAND DRAINAGE SEWER	300mm L.D.S.
	WASTE WATER SEWER			PROPERTY LINE		250mm W.W.S.	WASTE WATER SEWER	250mm W.W.S.
	MANHOLE			SURVEY BAR				
	CATCH BINLET			CURB STOP				
	CURB INLET			C.B. LEAD				
	PARKING METER			SIDEWALK				
	STEAMHEAT			SIDEWALK RAMP				
	GAS		32.55	ELEVATIONS	32.55			

LOCATION APPROVED
UNDERGROUND STRUCTURES

SUPV. U/G STRUCTURES DATE
COMMITTEE

NOTE:

LOCATION OF UNDERGROUND STRUCTURES AS SHOWN ARE BASED ON THE BEST INFORMATION AVAILABLE BUT NO GUARANTEE IS GIVEN THAT ALL EXISTING UTILITIES ARE SHOWN OR THAT THE GIVEN LOCATIONS ARE EXACT. CONFIRMATION OF EXISTENCE AND EXACT LOCATION OF ALL SERVICES MUST BE OBTAINED FROM THE INDIVIDUAL UTILITIES BEFORE PROCEEDING WITH CONSTRUCTION.

B.M.
ELEV.

NO.	REVISIONS	DATE	BY
1	Additions/Deletions	10.26.95	LLW
2	AS BUILT	11.06.96	LLW

David Wagner Associates Inc.
4 - 430 River Avenue Winnipeg, Manitoba. R3L 0C6 (204) 452-2426
LANDSCAPE ARCHITECTURE • URBAN DESIGN • GOLF COURSE ARCHITECTURE

DESIGNED BY	D.M./D.W.	CHECKED BY	
DRAWN BY	D.M.	APPROVED BY	
HOR. SCALE:	As Shown	RELEASED FOR CONSTRUCTION	
VERT. SCALE:	Not Applicable		
DATE	08 / 95	DATE	

LANDSCAPE ARCHITECT'S SEAL

the manitoba association of landscape architects
DAVID WAGNER
Member no. 35

CONSULTANT DRAWING NO.
CAD9509(L2)

CORYDON AVE. BIZ STREET ENHANCEMENT COMMITTEE / CORYDON VILLAGE RESIDENTS ASSOCIATION

Corydon Ave. / Hugo St. Piazza

Layout Plan

CITY DRAWING NO.

SHEET 2 OF 10

L2