
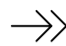
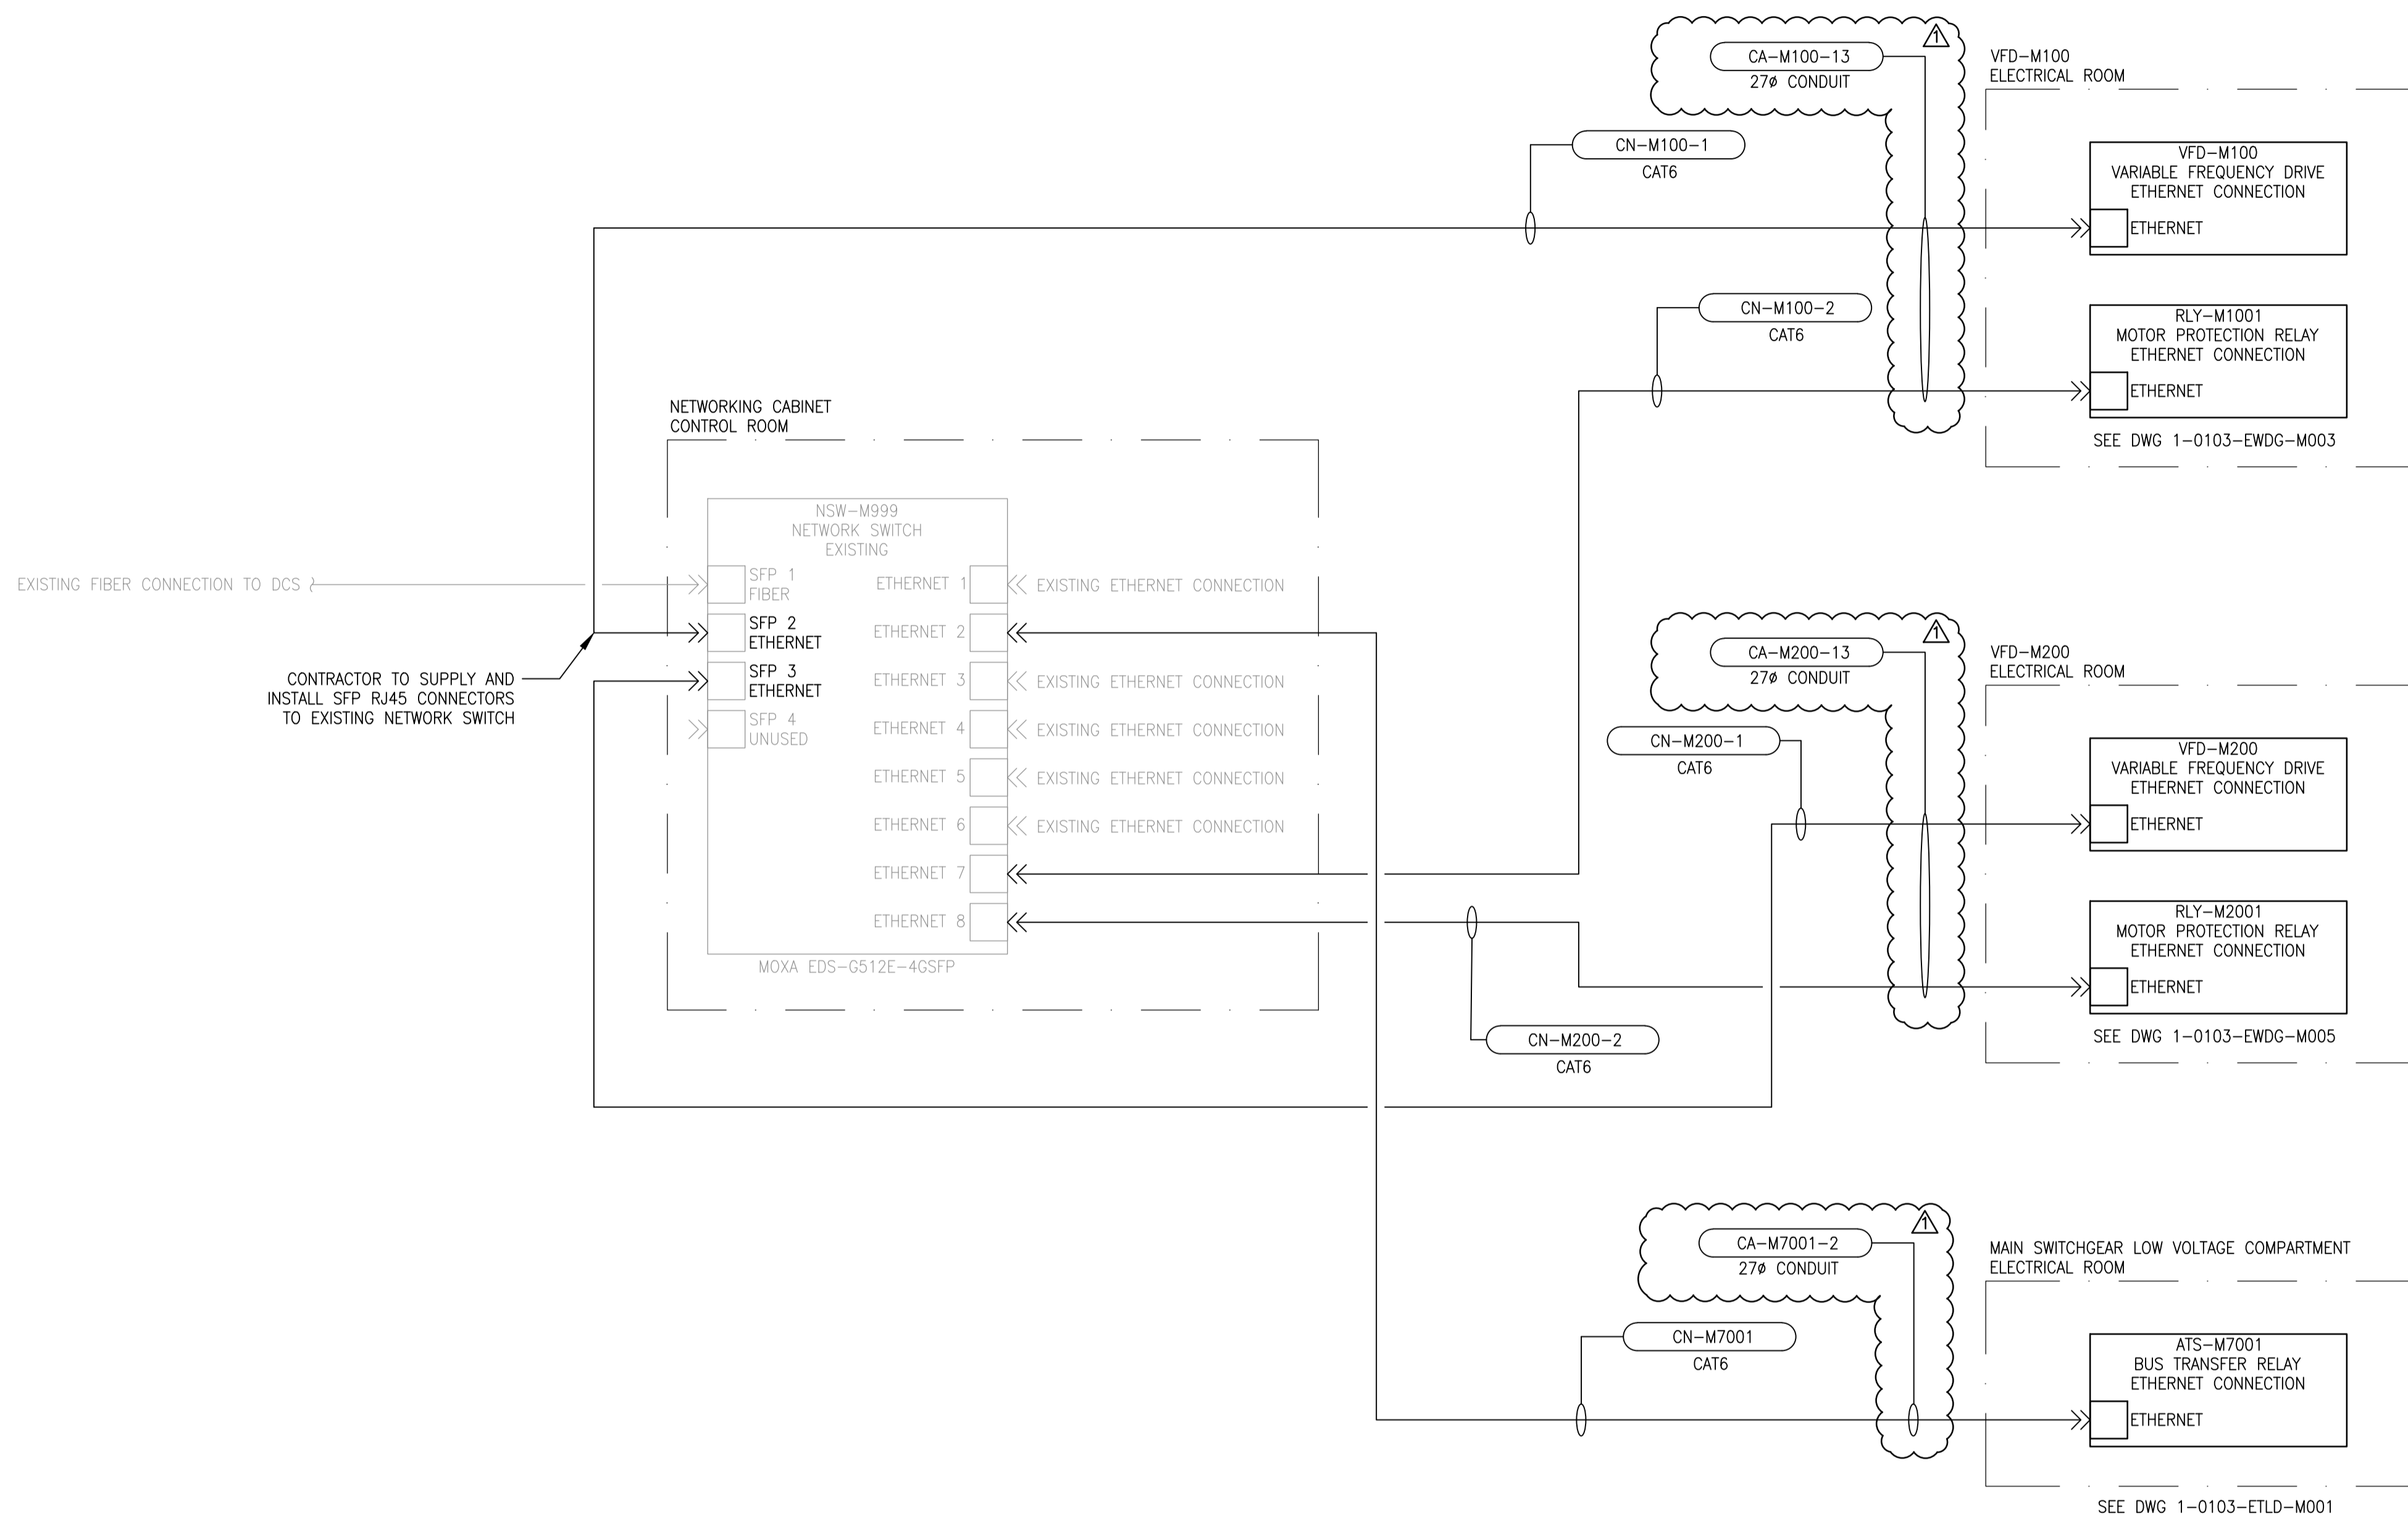


NOTES:

- ALL ITEMS SHOWN AS LIGHT INDICATE EXISTING CONDITIONS. ALL ITEMS SHOWN AS BOLD INDICATE WORK TO BE DONE.

LEGEND:

-  RJ45 PORT
-  CONNECTOR



9		
8		
7		
6		
5		
4		
3		
2		
1		
NO.	DRAWING NUMBER	REFERENCE DRAWINGS



01	ISSUED FOR ADDENDUM 1	2024-07-09	J.A.S., R.G.O.	R.G.O.
00	ISSUED FOR CONSTRUCTION	2024-06-20	M.J.B., R.G.B.	R.G.O.
NO.	REVISIONS	DATE	DESIGN	CHECK

MPE
 a division of Englobe

DESIGNED BY: J.A.S., R.G.O. CHECKED BY: R.G.O.
 DRAWN BY: N.O.W., J.A.S. APPROVED BY: R.G.O.
 SCALE: NOT TO SCALE RELEASED FOR CONSTRUCTION BY: R.G.O.
 DATE: 2024/06/20

CONSULTANT NO.:

ENGINEER'S SEAL

JULY 9, 2024

REV 01

THE CITY OF WINNIPEG
 WATER AND WASTE DEPARTMENT

PERIMETER ROAD PUMPING STATION
 2024 UPGRADES
 NETWORK DIAGRAM

CITY DRAWING NUMBER: **1-0103-ANET-M001** SHEET: **001** REV: **01** SIZE: **A**