
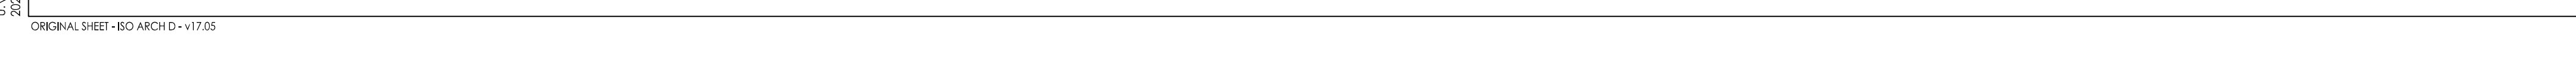
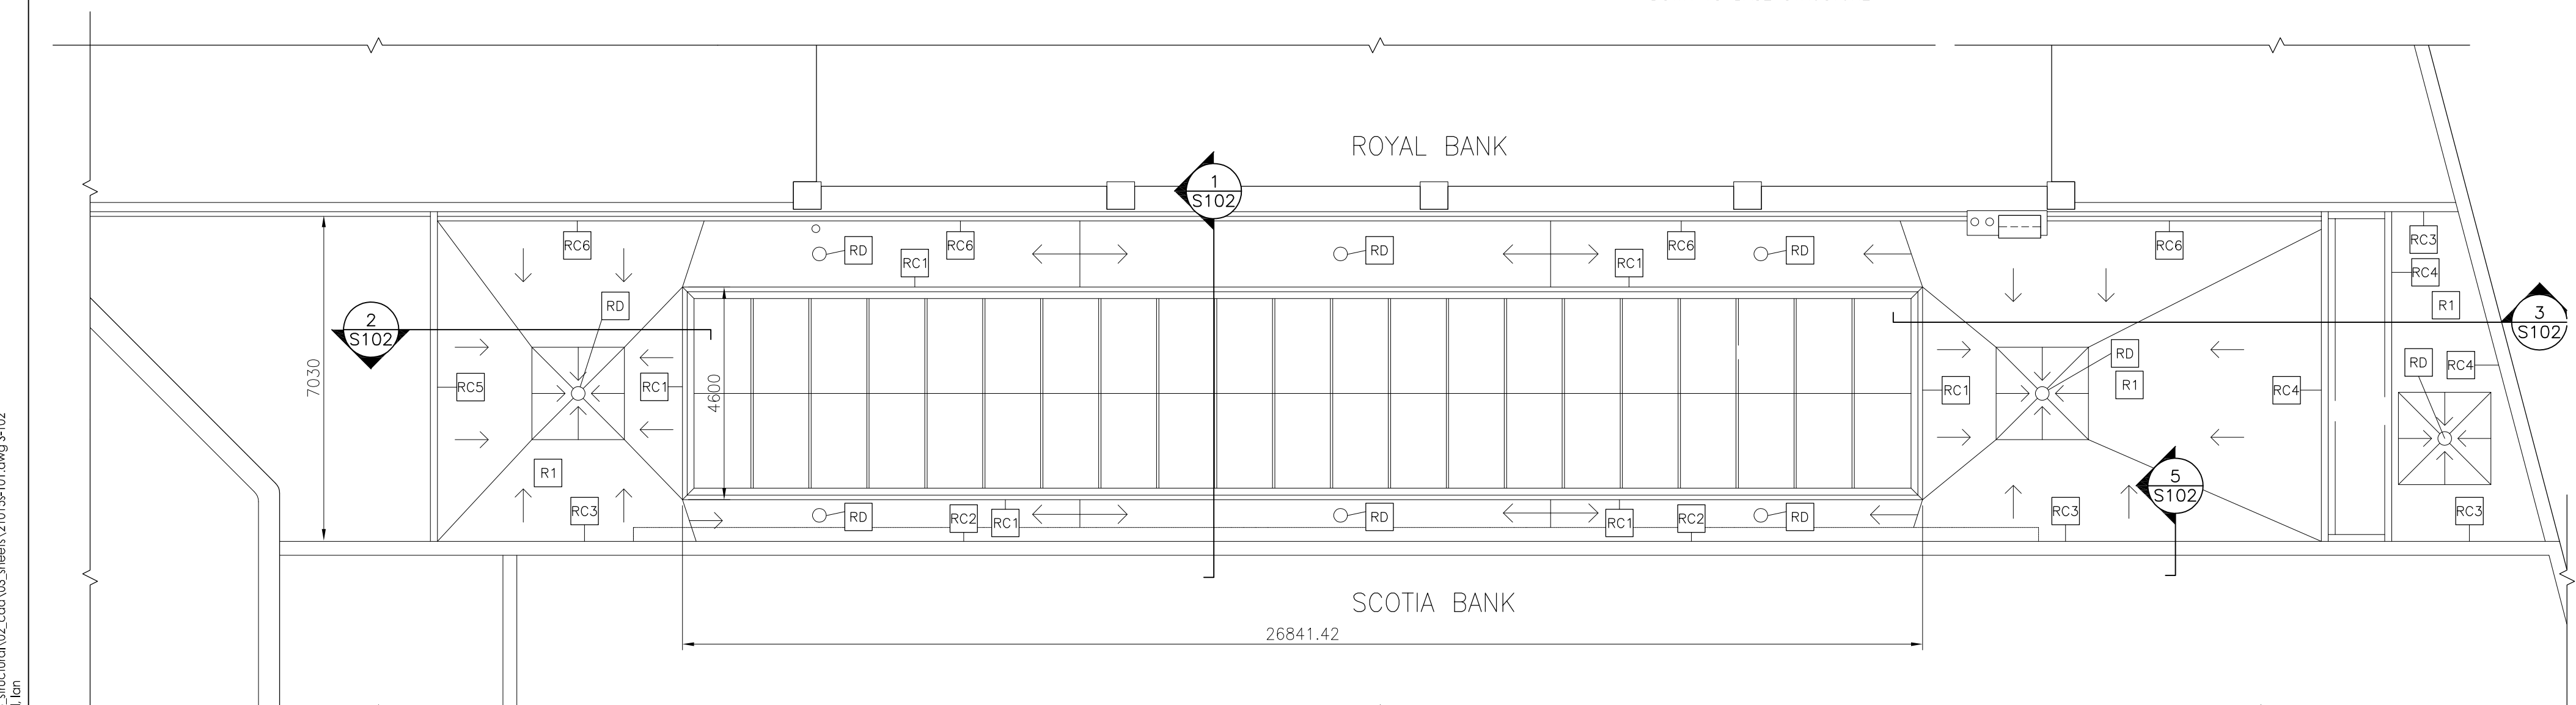
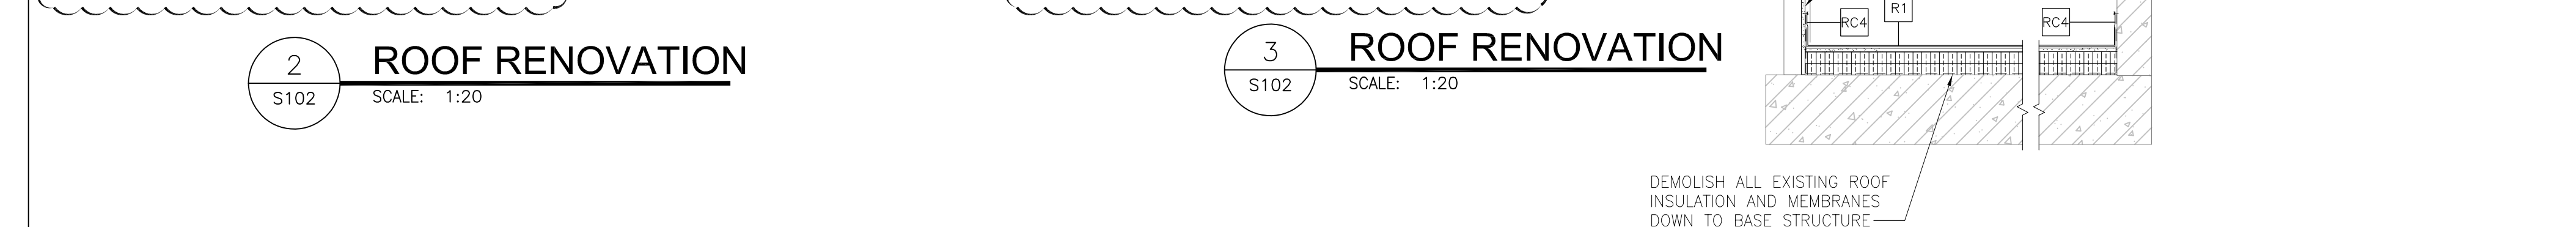
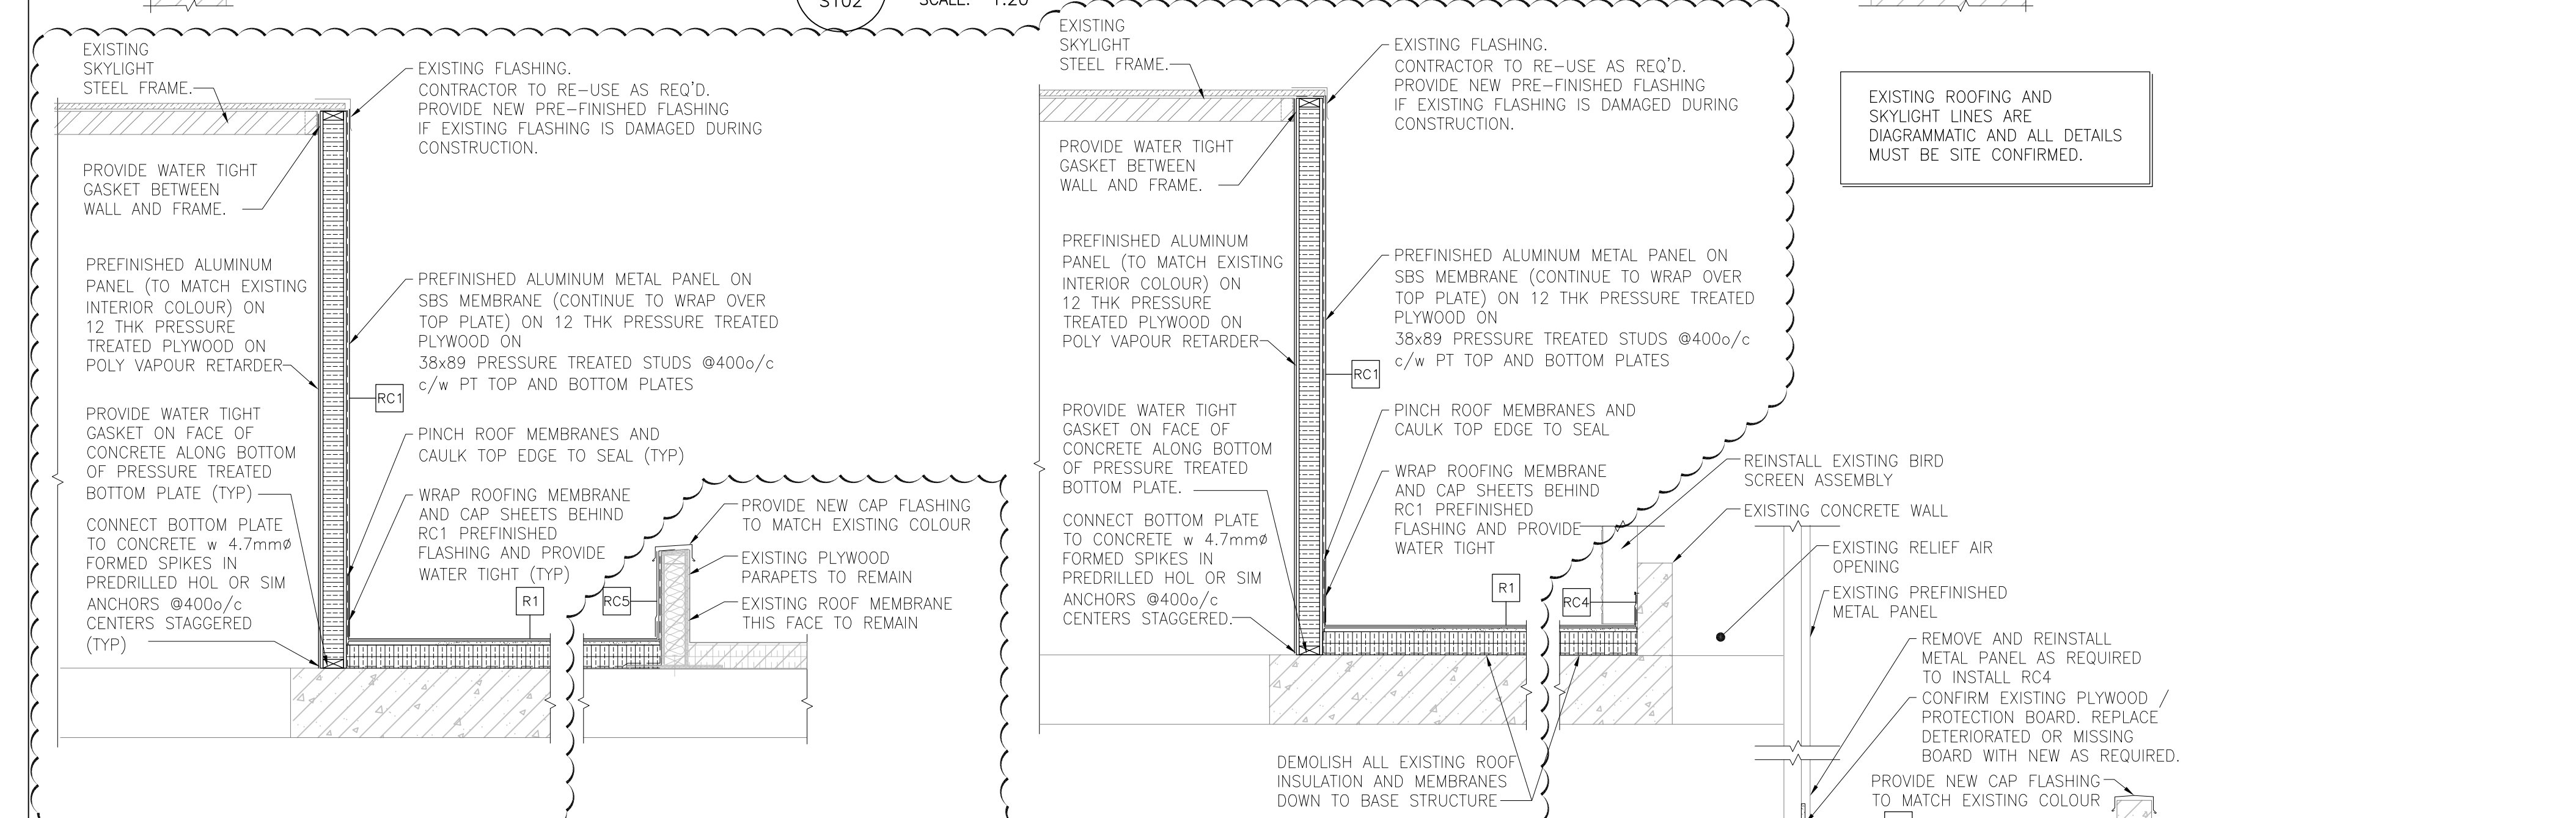


E			
D			
C			
B	ISSUED FOR ADDENDUM	IR	BF 2024.08.27
A	ISSUED FOR CONSTRUCTION	IR	BF 2024.04.28
Issued		By	Appd. YY.MM.DD
File Name:	21015-101	VF/IR	BC BF 24.08.27
		Dwn.	Chkd. Dsgn. YY.MM.DD

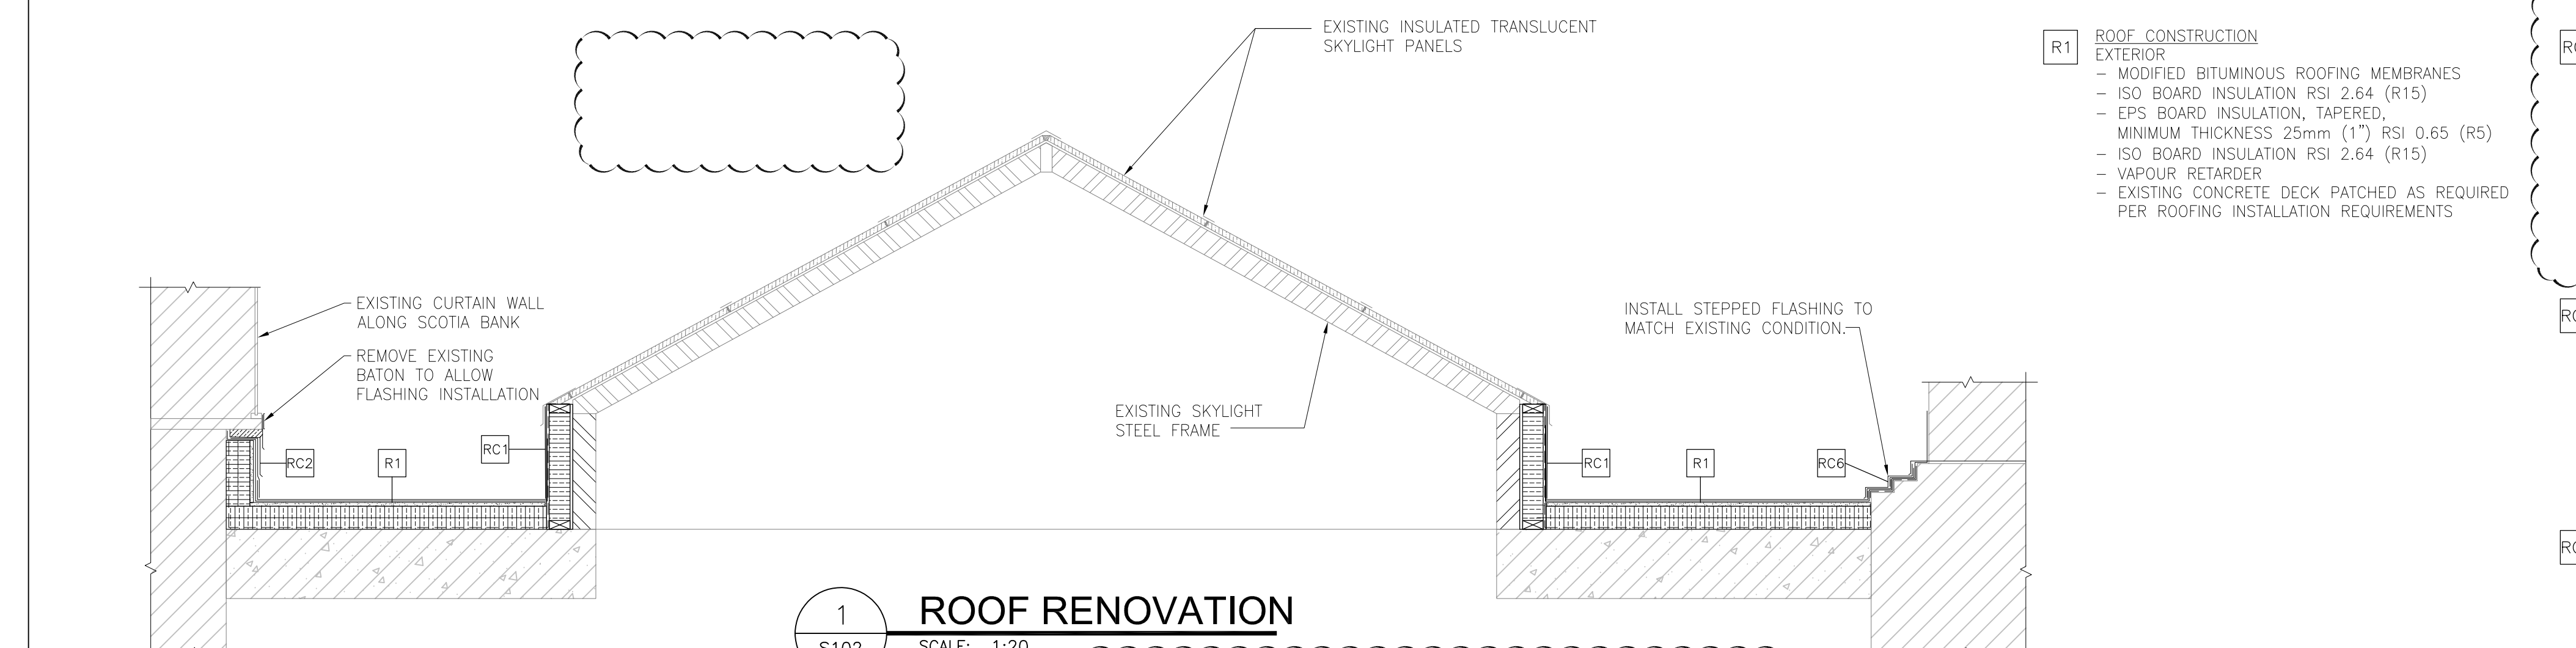

**R1 ROOF CONSTRUCTION**  
 EXTERIOR  
 - MODIFIED BITUMINOUS ROOFING MEMBRANES  
 - ISO BOARD INSULATION RSI 2.64 (R15)  
 - EPS BOARD INSULATION, TAPERED,  
 MINIMUM THICKNESS 25mm (1") RSI 0.65 (R5)  
 - ISO BOARD INSULATION RSI 2.64 (R15)  
 - VAPOUR RETARDER  
 - EXISTING CONCRETE DECK PATCHED AS REQUIRED  
 PER ROOFING INSTALLATION REQUIREMENTS

**RC1 ROOF CURB / WALL CONSTRUCTION**  
 EXTERIOR  
 - PREFINISHED ALUMINUM METAL PANEL  
 - SBS MEMBRANE (WRAP OVER TOP PLATE)  
 - 12 THK PRESSURE TREATED PLYWOOD  
 - 38x89 PRESSURE TREATED STUDS @400o/c  
 c/w PT TOP AND BOTTOM PLATE  
 - VAPOUR RETARDER  
 - 12 THK PRESSURE TREATED PLYWOOD  
 - PREFINISHED ALUMINUM PANEL (TO MATCH  
 EXISTING INTERIOR COLOUR)  
 - EX. STEEL FRAME SKYLIGHT PAINTED

**RC2 ROOF CURB CONSTRUCTION**  
 EXTERIOR  
 - GALVANIZED CURB FLASHING  
 - SPRAYFOAM INSULATION  
 - SECONDARY FLASHING W/KEEPER BAR  
 - MODIFIED BITUMINOUS ROOFING MEMBRANES  
 - PROTECTION BOARD OR PLYWOOD ANCHORED  
 TO FACE OF CONCRETE WALL  
 - 100mm RIGID INSULATION  
 - EX. BLUESKIN MEMBRANE  
 - EX. FACE OF WALL


**RC3 ROOF CURB CONSTRUCTION**  
 EXTERIOR  
 - GALVANIZED CURB FLASHING  
 - SPRAYFOAM INSULATION  
 - SECONDARY FLASHING W/KEEPER BAR  
 - MODIFIED BITUMINOUS ROOFING MEMBRANES  
 - PROTECTION BOARD OR PLYWOOD ANCHORED  
 TO FACE OF CONCRETE WALL  
 - 50mm RIGID INSULATION  
 - EX. BLUESKIN MEMBRANE  
 - EX. FACE OF WALL

**RC4 ROOF CURB CONSTRUCTION**  
 EXTERIOR  
 - FLASHING W/KEEPER BAR  
 - MODIFIED BITUMINOUS ROOFING MEMBRANES  
 - VAPOUR RETARDER  
 - EX. CONCRETE CUTOFF WALL  
 - EX. RELIEF AIR OPENING

**RC5 ROOF CURB CONSTRUCTION**  
 EXTERIOR  
 - NEW CAP FLASHING TO MATCH EX. COLOUR  
 - MODIFIED BITUMINOUS ROOFING MEMBRANES  
 - VAPOUR RETARDER  
 - EX. ROOF CURB

**RC6 ROOF CURB CONSTRUCTION**  
 EXTERIOR  
 - NEW STEPPED CAP FLASHING TO MATCH EX.  
 COLOUR  
 - MODIFIED BITUMINOUS ROOFING MEMBRANES  
 - VAPOUR RETARDER  
 - EX. BUILDING STRUCTURE

**RD ROOF DRAIN**  
 U-FLOW HERCULES-A (ALUMINUM STRAINER DOME)  
 c/w STONE RETAINER FILTER RING  
 - CONTRACTOR TO EXAMINE EXISTING CONDITIONS  
 AND CONFIRM THAT THE U-FLOW HERCULES DRAIN  
 WILL WORK. INSTALL AS PER MANUFACTURERS'  
 RECOMMENDATIONS.

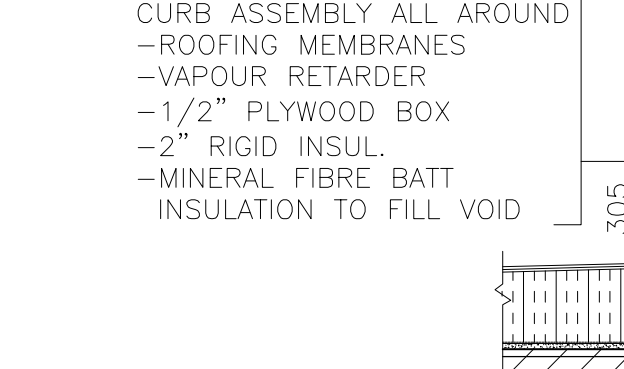

I:\115421015\4\_wdring\_ban\03\_struct\02\_cad\03\_sheets\21015a101.dwg 5:102  
 2024/08/27 4:17 PM By: Roranzogel, lan