


SYNTHETIC TURFS CONNECTION DETAIL

NOTES:


1. Concrete To Be As Per City Of Winnipeg Specification Cw 3310 Portland Cement Concrete Pavement Works (latest Revision)
2. Contraction Joints @ 2439 Max C/c. Seal Joint With Approved Polyethylene Sealant For Flush Finish
3. Synthetic Turf To Be Suitable For Sports Field Application And Approved By Contract Administrator. Installed As Per Manufacturer's Written Instructions.
4. Subgrade And Compacted Granular Base As Per City Of Winnipeg Specification Cw 3110 – Sub-grade, Sub-base And Base Course Construction (latest Revision)
- ~~5. 2x2 x2' Long ACQ Treated Pressure Treat Wood Stakes to be Placed Every 610 (2') Along Outer Edges of 6x6 Pressure Treat Lumber Where Granular Surfacing Located. Ensure top of Stake is Set 2" Below Top of Finished 6x6 Framing.~~
6. Concrete to Have Light Broom Finish
7. Measurements in PITCH PLAN Are From Outside Edge of 6x6 Lumber

1 CRICKET PITCH PLAN
Scale: 1:250

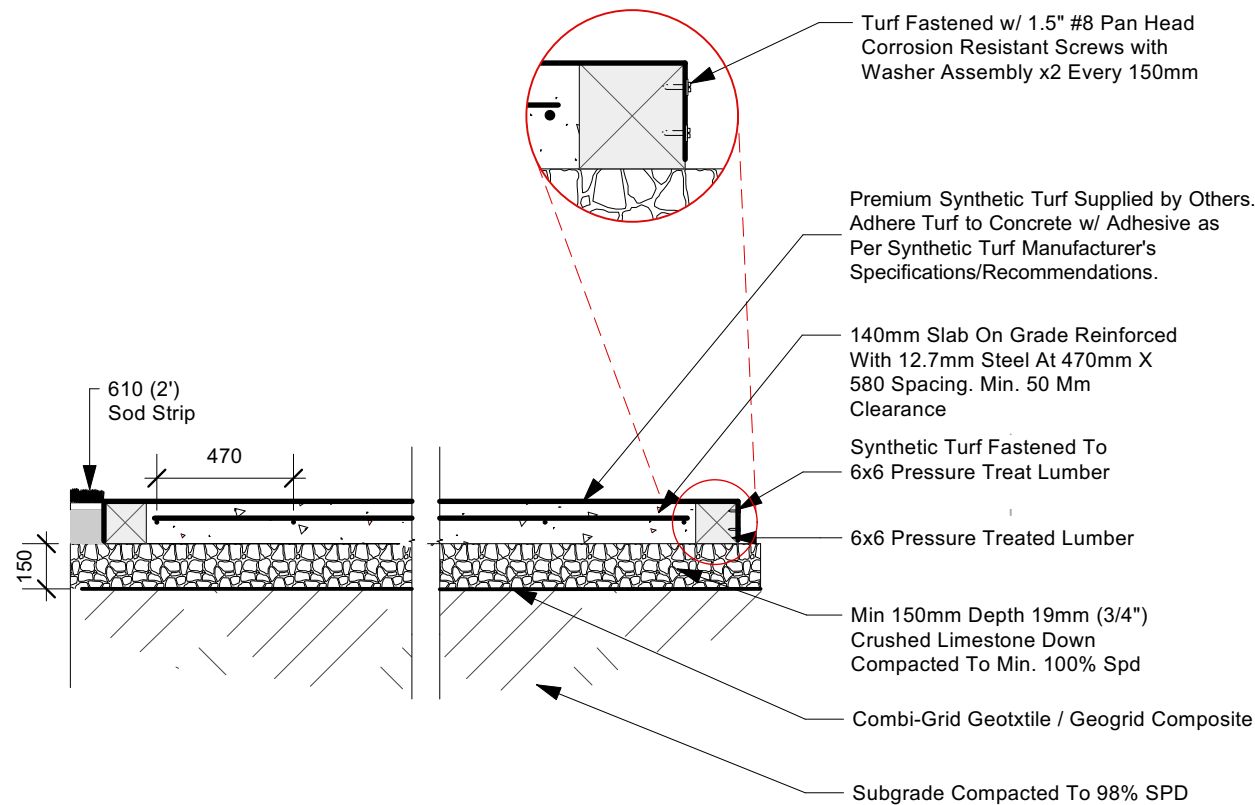

2 CRICKET PITCH WITH CONCRETE BASE
Scale: 1:25

Combi-grid geotextile / geogrid composite
150mm depth 19mm (3/4" down) compacted limestone.
50mm depth 1/4" down compacted limestone Ensure granular is compacted to top of timber edge beyond chamfered edge. Contract Administrator to approve prior to turf install.
Basic Synthetic turf. Installed as per manufacturers' written specifications
Artificial turf wrapped around side of timber ~~stapled~~ x 2 every 100mm. Turf to wrapped to 100mm down edge of timber

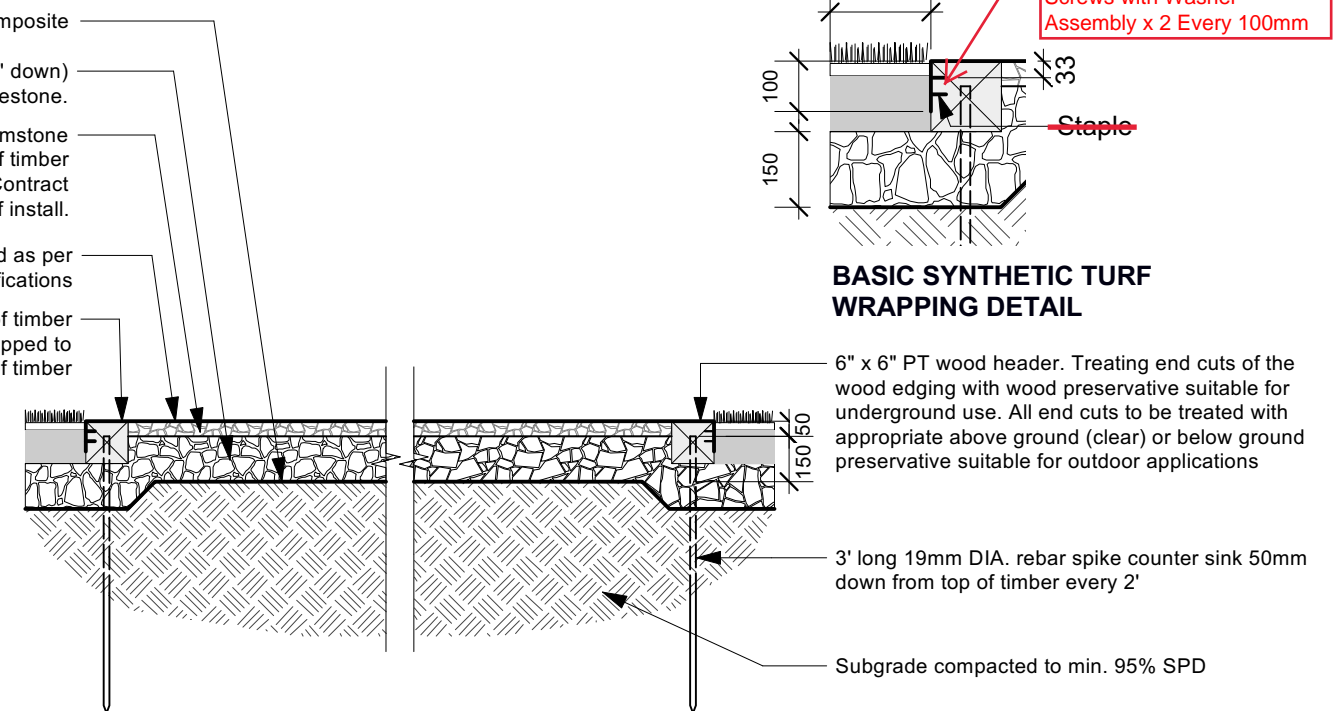

3 CRICKET PITCH WITH GRANULAR BASE
Scale: 1:25

CONTRACTOR TO CONFIRM ALL DIMENSIONS AND REPORT ANY DISCREPANCIES TO CONTRACT ADMINISTRATOR PRIOR TO CONSTRUCTION. LOCATION OF UNDERGROUND STRUCTURES AS SHOWN ARE BASED ON THE BEST INFORMATION AVAILABLE BUT NO GUARANTEE IS GIVEN THAT ALL EXISTING UTILITIES ARE SHOWN OR THAT THE GIVEN LOCATIONS ARE EXACT. CONFIRMATION OF EXISTENCE AND EXACT LOCATION OF ALL SERVICES MUST BE OBTAINED FROM THE INDIVIDUAL UTILITIES BEFORE PROCEEDING WITH CONSTRUCTION.



THE CITY OF WINNIPEG
Planning, Property and Development Department
Planning and Land Use Division
Unit 15 - 30 Fort Street, Winnipeg, MB, (R3C 4X5)

DESIGNED BY	DL	CHECKED BY	
DRAWN BY	DL	APPROVED BY	
HORIZ. SCALE	AS NOTED		
VERT. SCALE			
DATE	February 2024		

MANAGER, PARK AND OPEN SPACES	DATE
MANAGER, PLANNING AND LAND USE DIVISION	DATE

DRAWING TITLE	DRAWING NO.
Bridgwater Lakes Park	
Adult Cricket Pitch	B.105-A2-R1
Details	
SITE ADDRESS 200 Bridge Lake Drive	BID OPPORTUNITY NO. 55-2024