


SYNTHETIC TURFS CONNECTION DETAIL


NOTES:

1. Concrete To Be As Per City Of Winnipeg Specification Cw 3310 Portland Cement Concrete Pavement Works (latest Revision)
2. Contraction Joints @ 2439 Max C/c. Seal Joint With Approved Polyethylene Sealant For Flush Finish
3. Synthetic Turf To Be Suitable For Sports Field Application And Approved By Contract Administrator. Installed As Per Manufacturer's Written Instructions.
4. Subgrade And Compacted Granular Base As Per City Of Winnipeg Specification Cw 3110 – Sub-grade, Sub-base And Base Course Construction (latest Revision)
- ~~5. 2x2 x2' Long ACQ Treated Pressure Treat Wood Stakes to be Placed Every 610 (2') Along Outer Edges of 6x6 Pressure Treat Lumber Where Granular Surfacing Located. Ensure top of Stake is Set 2" Below Top of Finished 6x6 Framing.~~
6. Concrete to Have Light Broom Finish
7. Measurements in PITCH PLAN Are From Outside Edge of 6x6 Lumber

1 CRICKET PITCH PLAN
Scale: 1:250

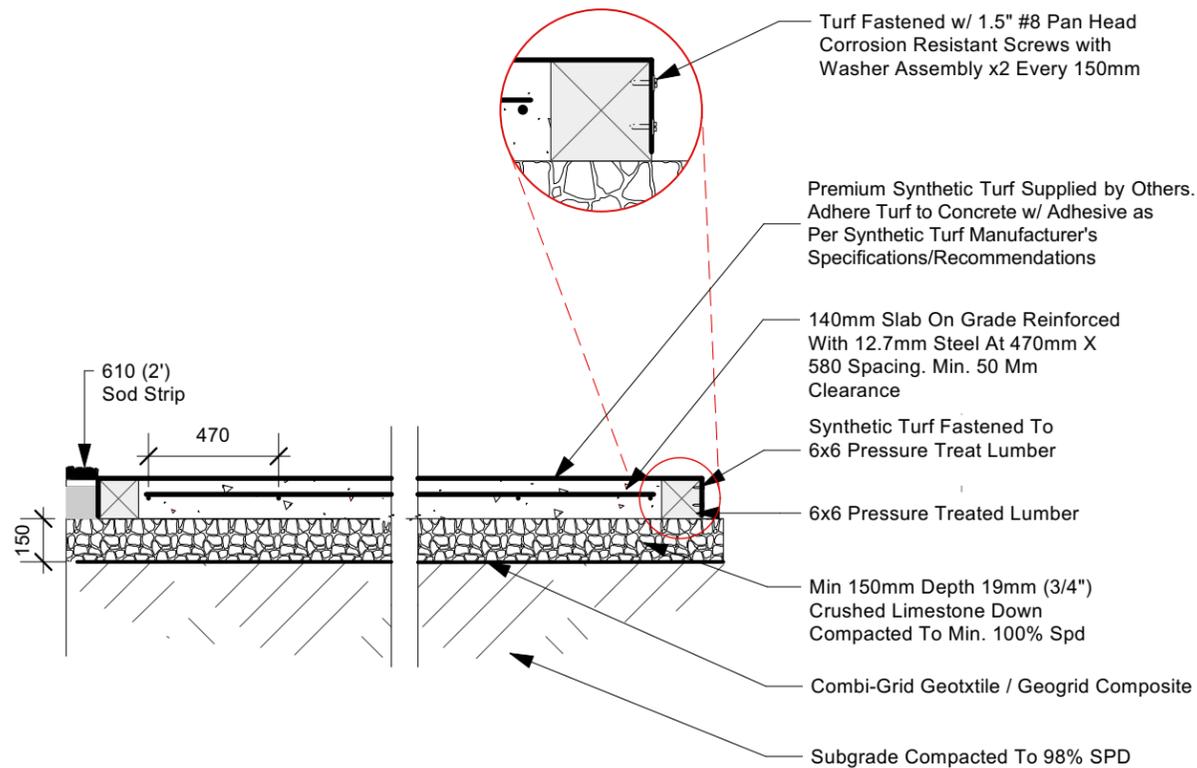

2 CRICKET PITCH WITH CONCRETE BASE
Scale: 1:25

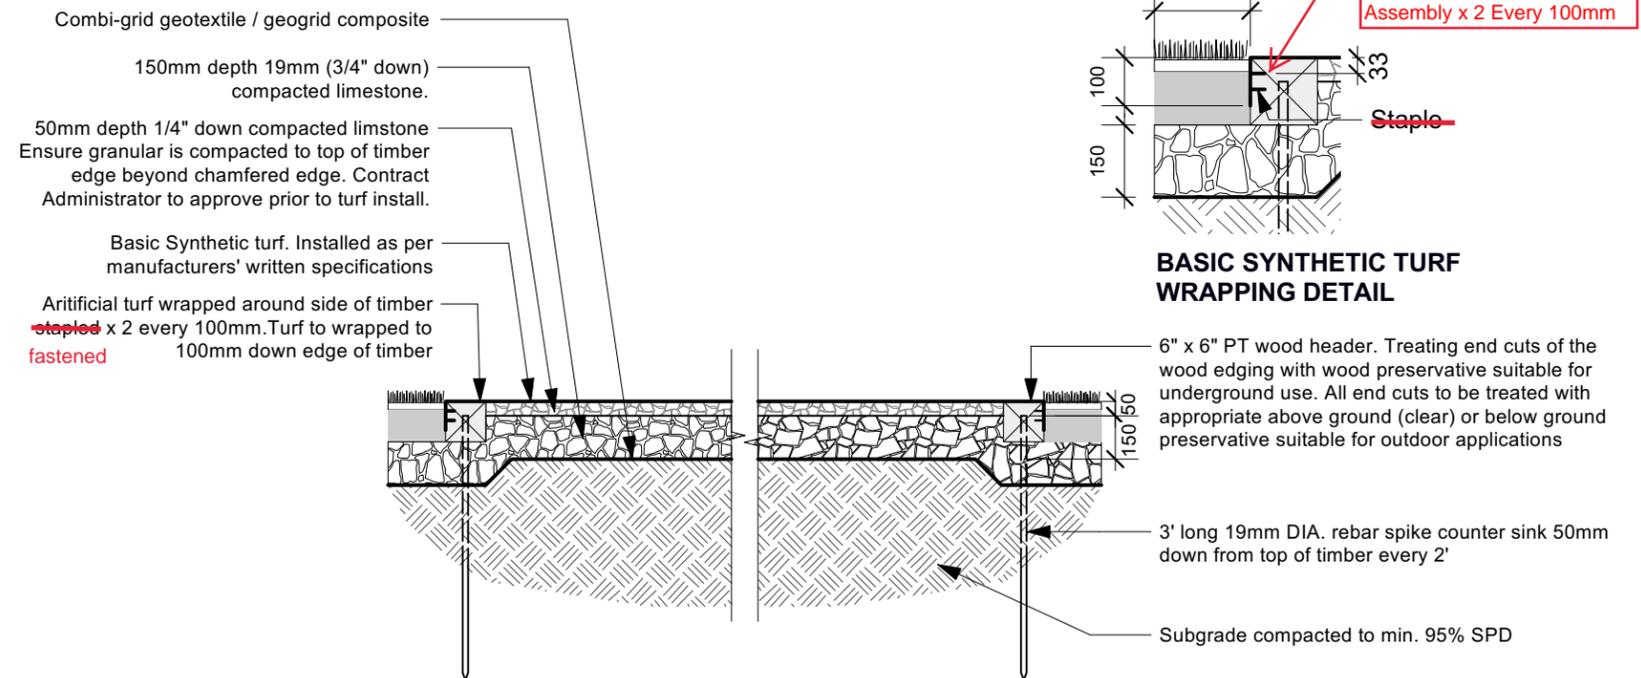

3 CRICKET PITCH WITH GRANULAR BASE
Scale: 1:25

CONTRACTOR TO CONFIRM ALL DIMENSIONS AND REPORT ANY DISCREPANCIES TO CONTRACT ADMINISTRATOR PRIOR TO CONSTRUCTION. LOCATION OF UNDERGROUND STRUCTURES AS SHOWN ARE BASED ON THE BEST INFORMATION AVAILABLE BUT NO GUARANTEE IS GIVEN THAT ALL EXISTING UTILITIES ARE SHOWN OR THAT THE GIVEN LOCATIONS ARE EXACT. CONFIRMATION OF EXISTENCE AND EXACT LOCATION OF ALL SERVICES MUST BE OBTAINED FROM THE INDIVIDUAL UTILITIES BEFORE PROCEEDING WITH CONSTRUCTION.

<p>THE CITY OF WINNIPEG Planning, Property and Development Department Planning and Land Use Division Unit 15 - 30 Fort Street, Winnipeg, MB, (R3C 4X5)</p>	DESIGNED BY	DL	CHECKED BY		DRAWING TITLE Chancellor Park Youth Cricket Pitch Details	DRAWING NO. C.18-C2-R1
	DRAWN BY	DL	APPROVED BY			
	HORIZ. SCALE	AS NOTED			MANAGER, PARK AND OPEN SPACES	DATE
	DATE	February 2024			MANAGER, PLANNING AND LAND USE DIVISION	DATE
					SITE ADDRESS	1264 Markham Rd
					BID OPPORTUNITY NO. 55-2024	