

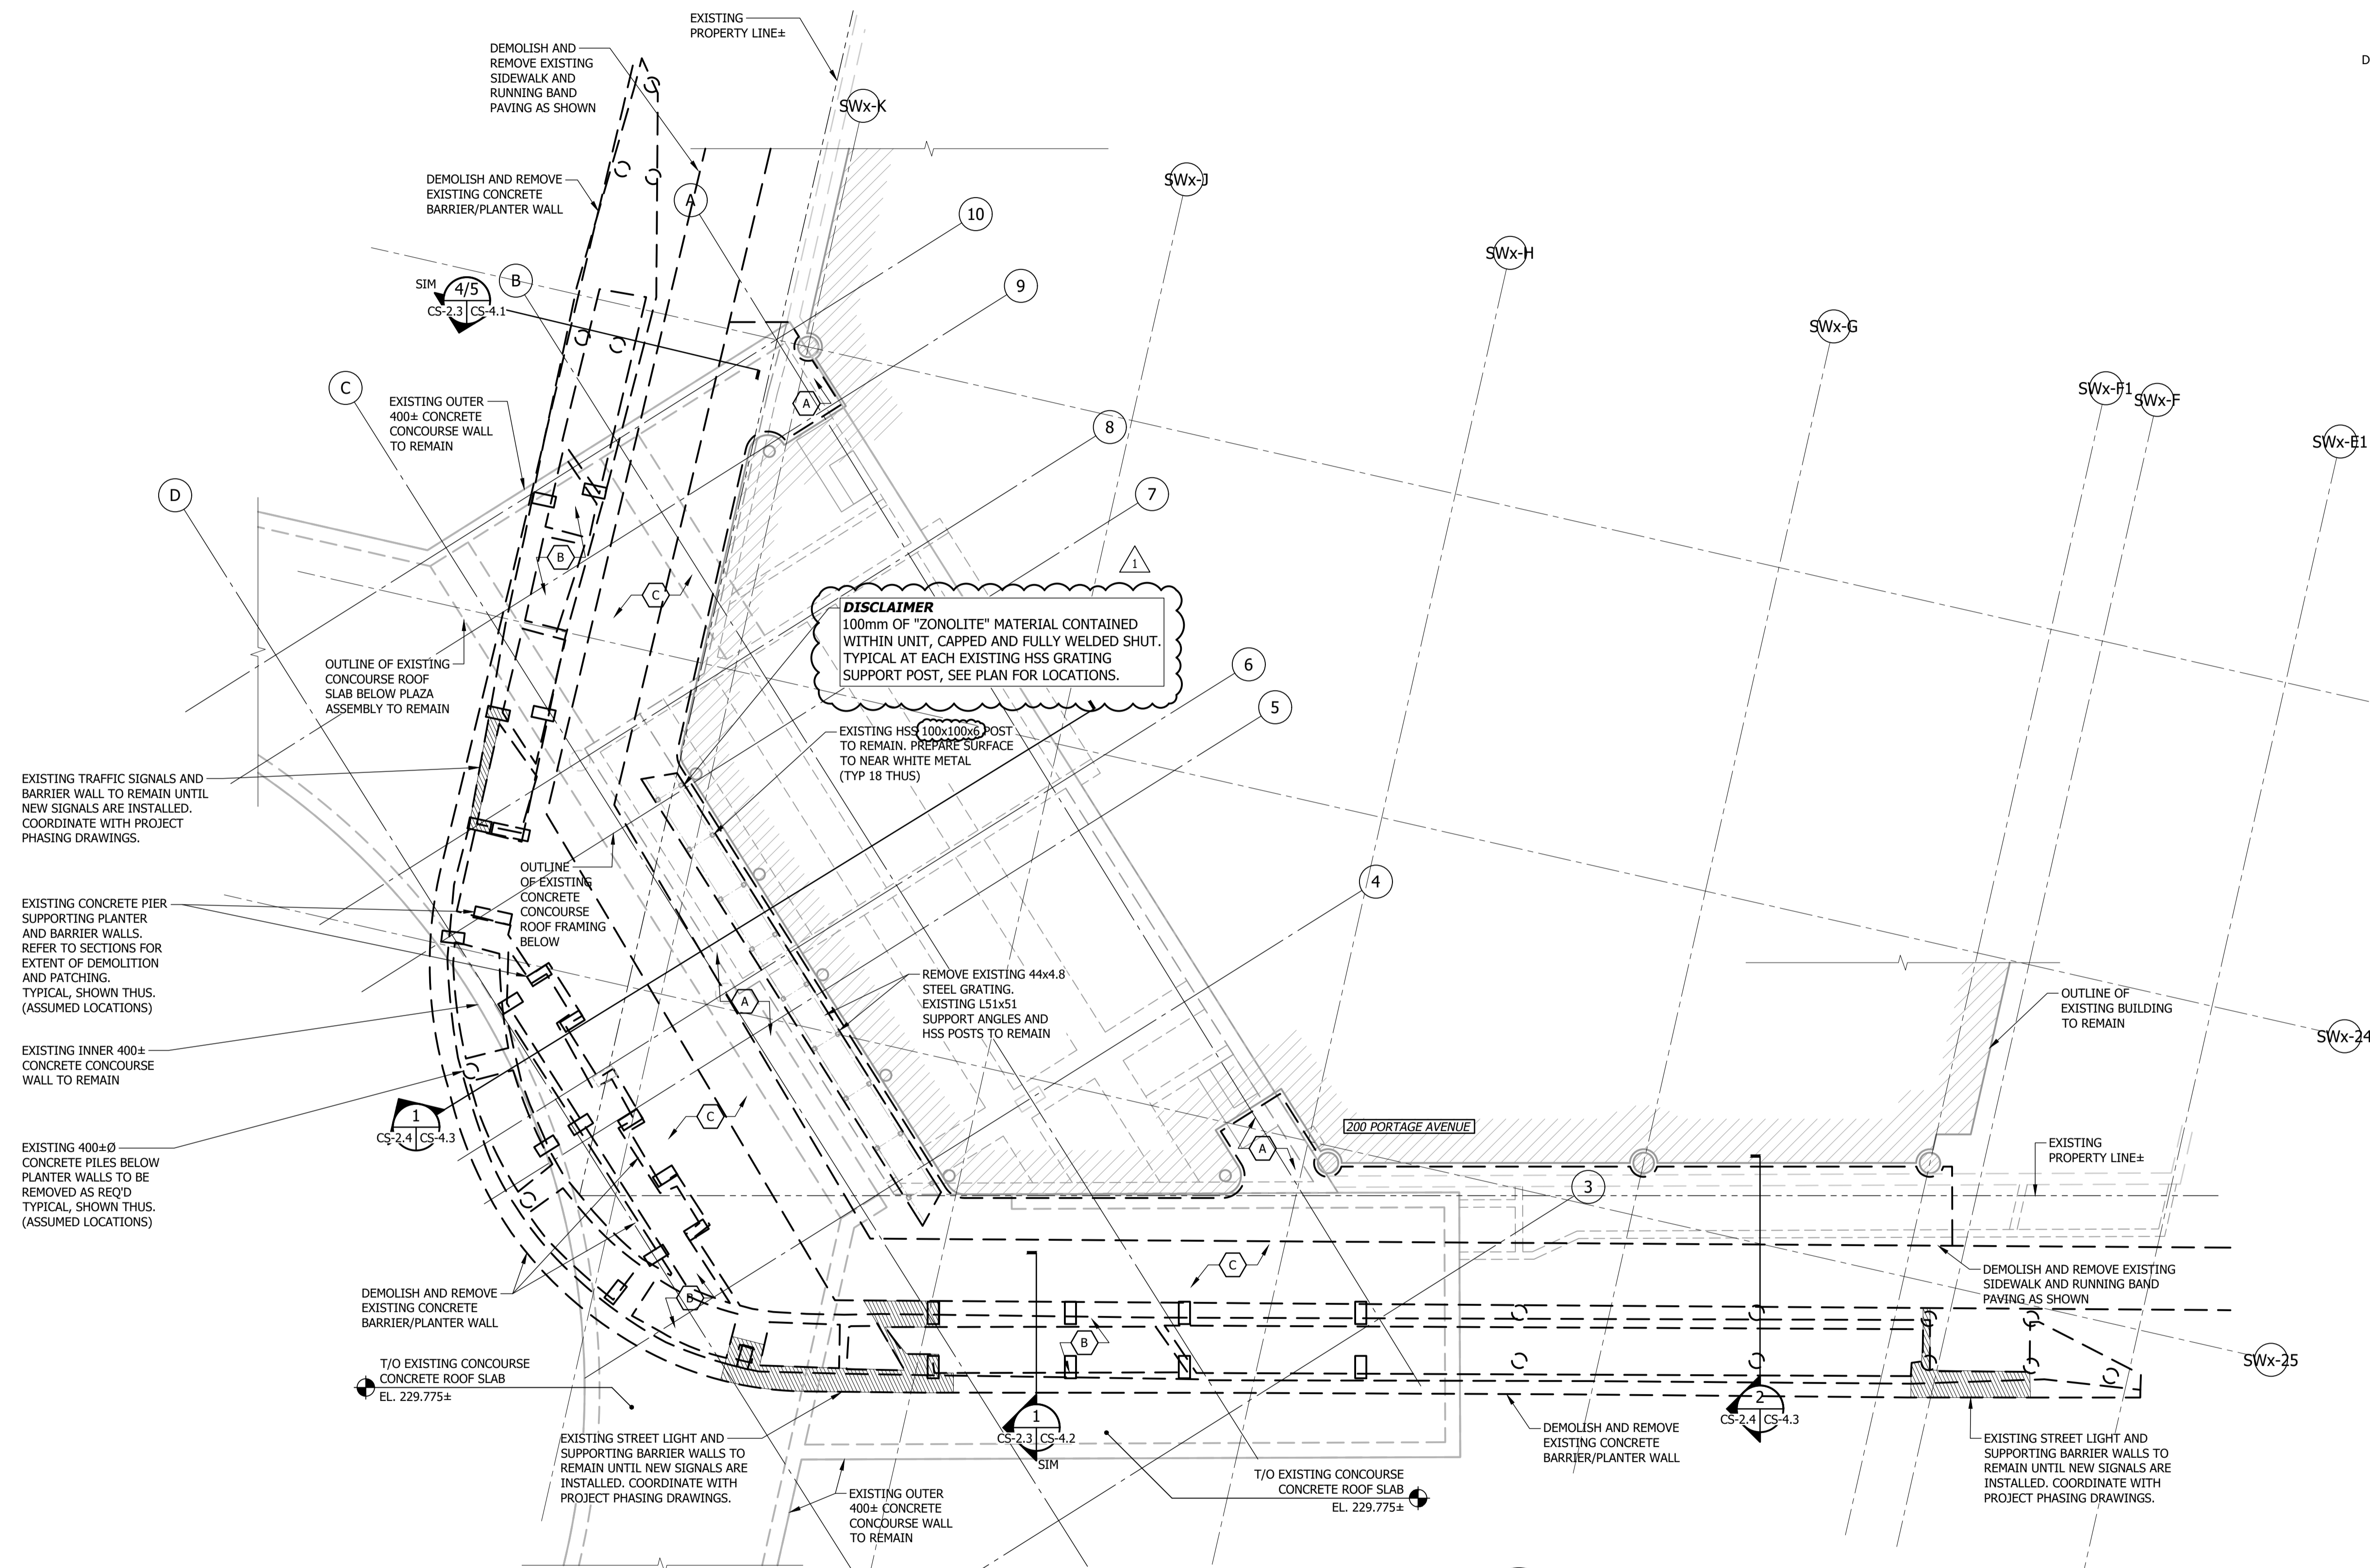


DEMOLITION SCHEDULE

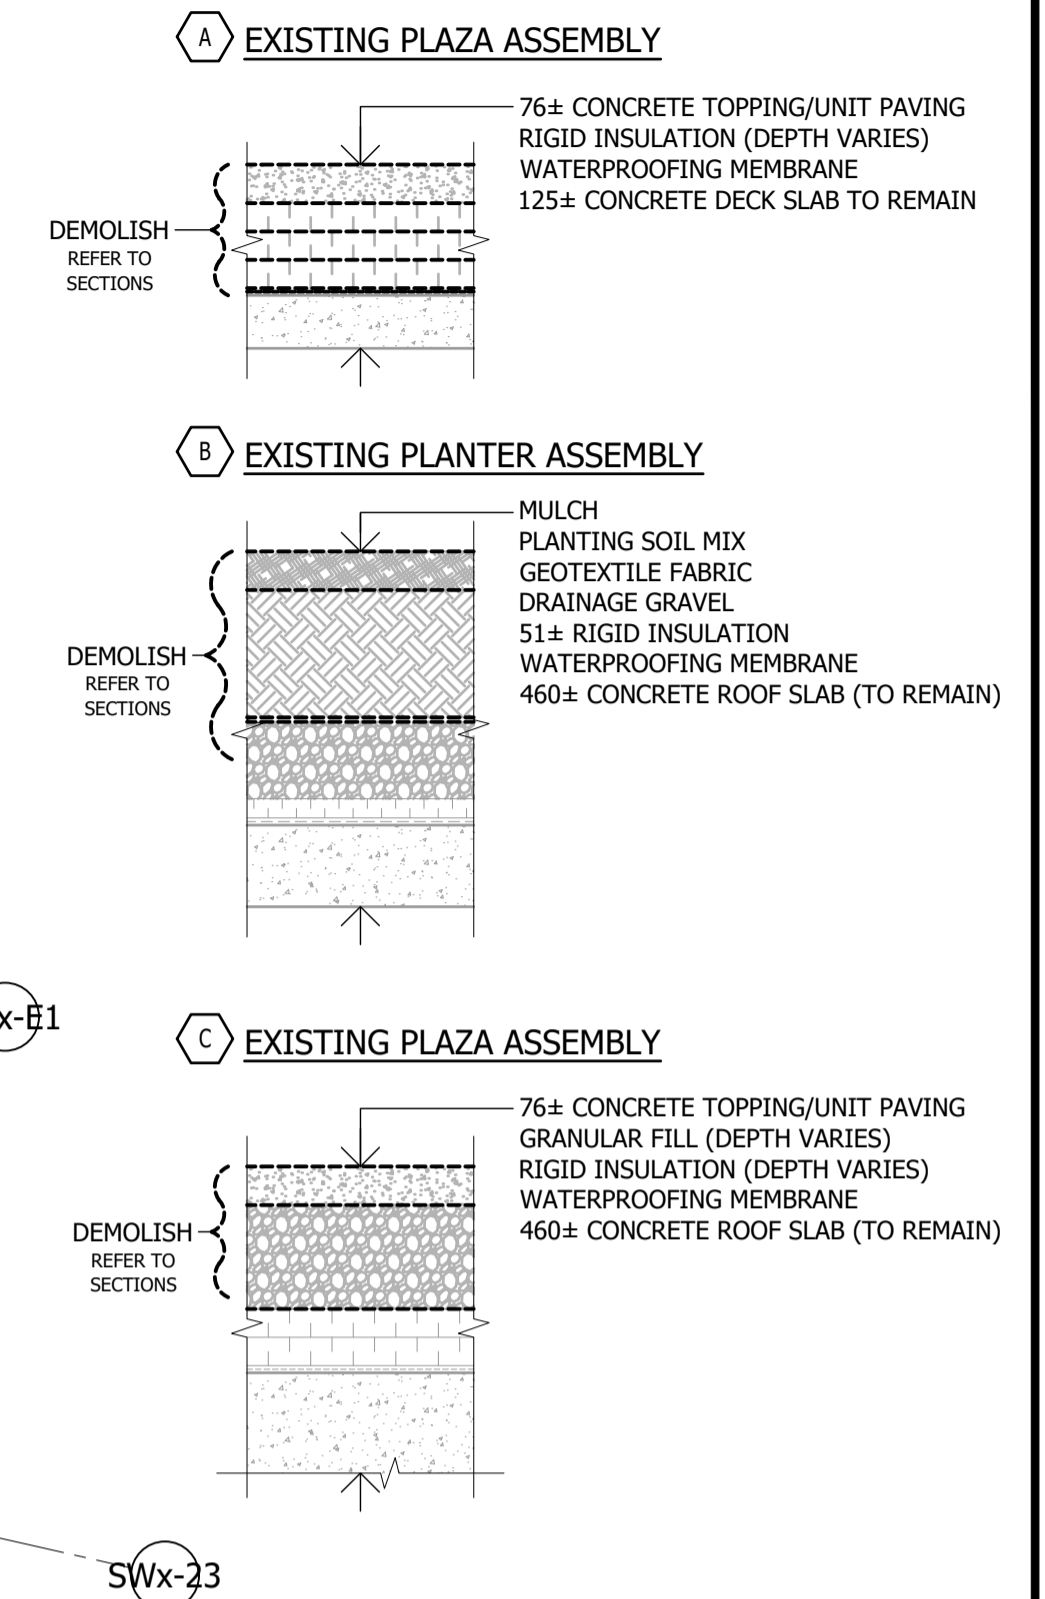

SOUTHWEST CORNER - DEMO PLAN
 1:100

| LEGEND | |
|--------|-----------------------|
| MARK | DESCRIPTION |
| --- | EXTENTS OF DEMOLITION |

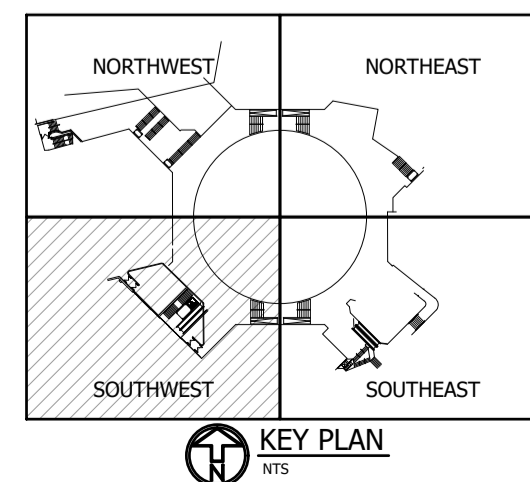

| B.M. ELEV. | DESIGNED BY | DATE | BY |
|------------|---------------|----------|-----|
| | SMC/DJM | 24-09-27 | SMC |
| | DRAWN BY | 24-09-09 | SMC |
| | CHECKED BY | | |
| | APPROVED BY | | |
| | HOR. SCALE | | |
| | VERTICAL | | |
| | NO. REVISIONS | | |

| | |
|-------------|------------|
| DESIGNED BY | SMC/DJM |
| DRAWN BY | MS/SAS |
| CHECKED BY | SMC |
| APPROVED BY | DJM |
| HOR. SCALE | AS NOTED |
| VERTICAL | AS NOTED |
| DATE | 2024-09-27 |

Crosier Kilgour
 Structural Engineering & Building Performance

RELEASED FOR CONSTRUCTION

DATE

| | |
|---------------------------|-----------|
| ENGINEER'S SEAL | |
| CONSULTANT PROJECT NUMBER | 2024-0410 |

THE CITY OF WINNIPEG
 PUBLIC WORKS DEPARTMENT

PORTAGE & MAIN PEDESTRIAN OPENING

SOUTHWEST CORNER DEMOLITION PLAN

CITY DRAWING NUMBER

SHEET OF 25

CONSULTANT DRAWING NUMBER

CS-2.4

C:\Users\veas\OneDrive - Crosier Kilgour\General - 2024-0410 - Portage & Main Pedestrian Reopening\06 Drawings\2024-0410_PORTAGE-MAIN.dwg