



C:\Users\veas\OneDrive - Crosier Kilgour\General - 2024-0410 - Portage & Main Pedestrian Opening\06 Drawings\2024-0410_PORTAGE-MAIN.dwg

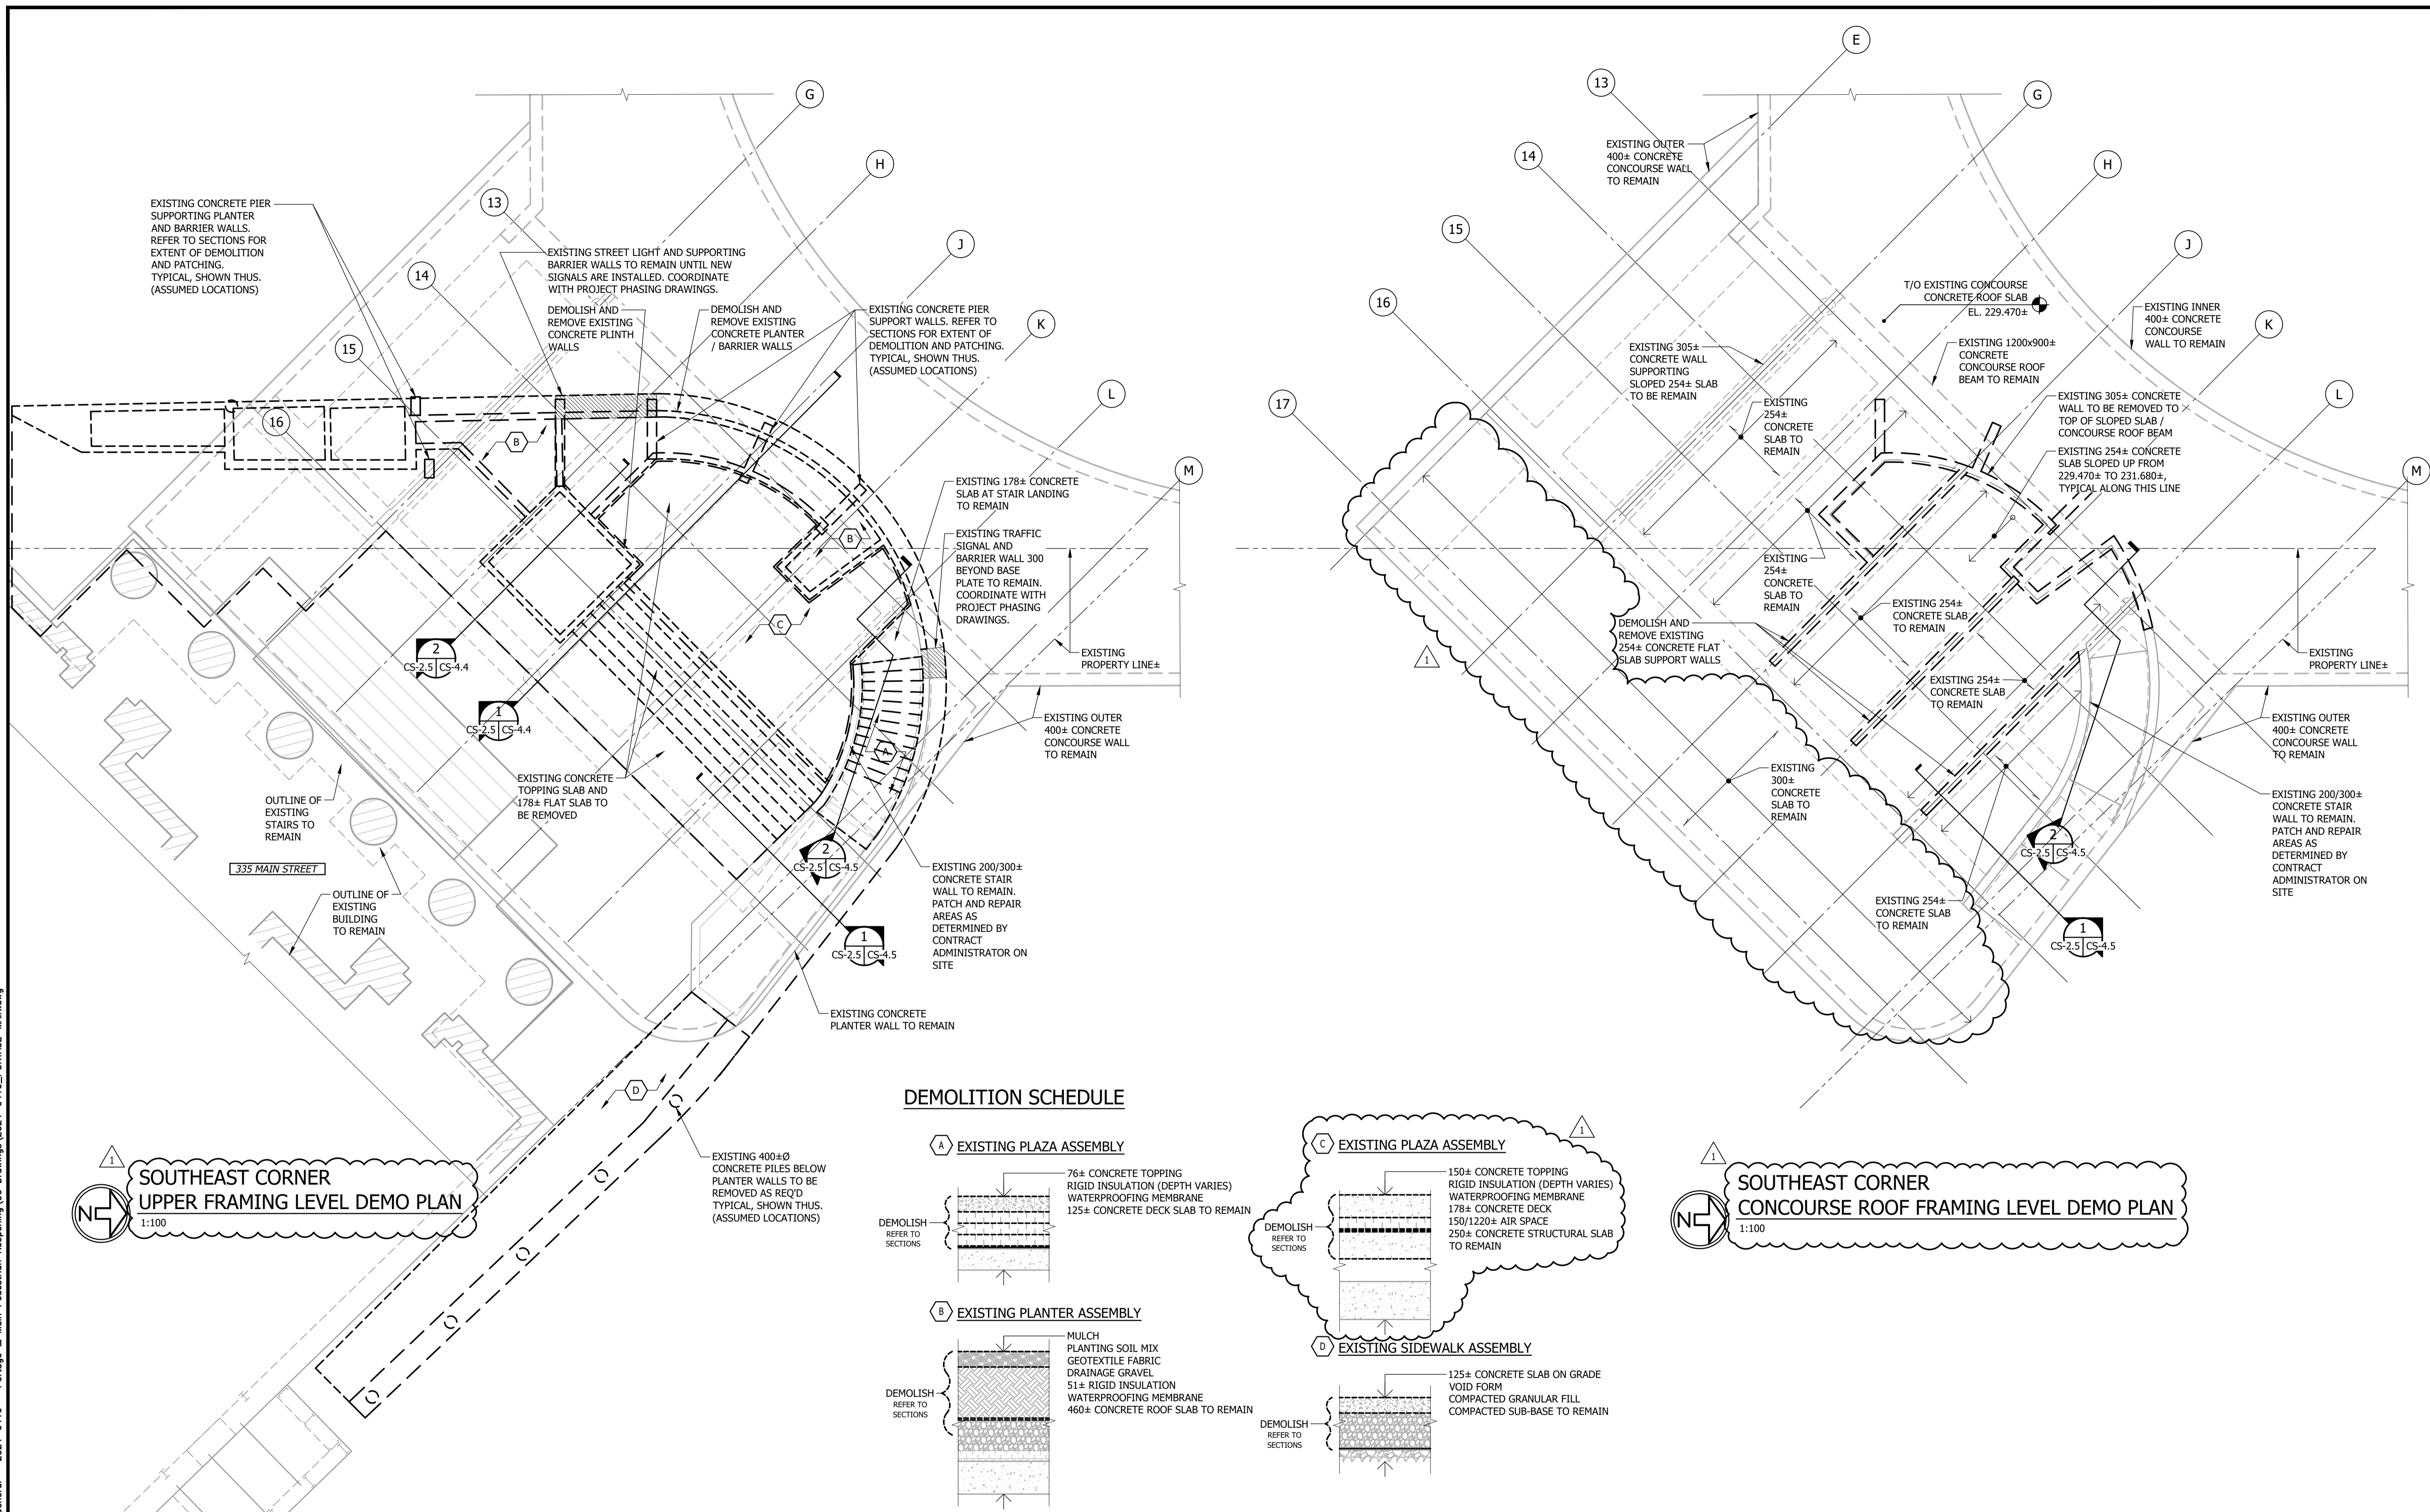


**SOUTHEAST CORNER
UPPER FRAMING LEVEL DEMO PLAN**
1:100

**SOUTHEAST CORNER
CONCOURSE ROOF FRAMING LEVEL DEMO PLAN**
1:100

DEMOLITION SCHEDULE

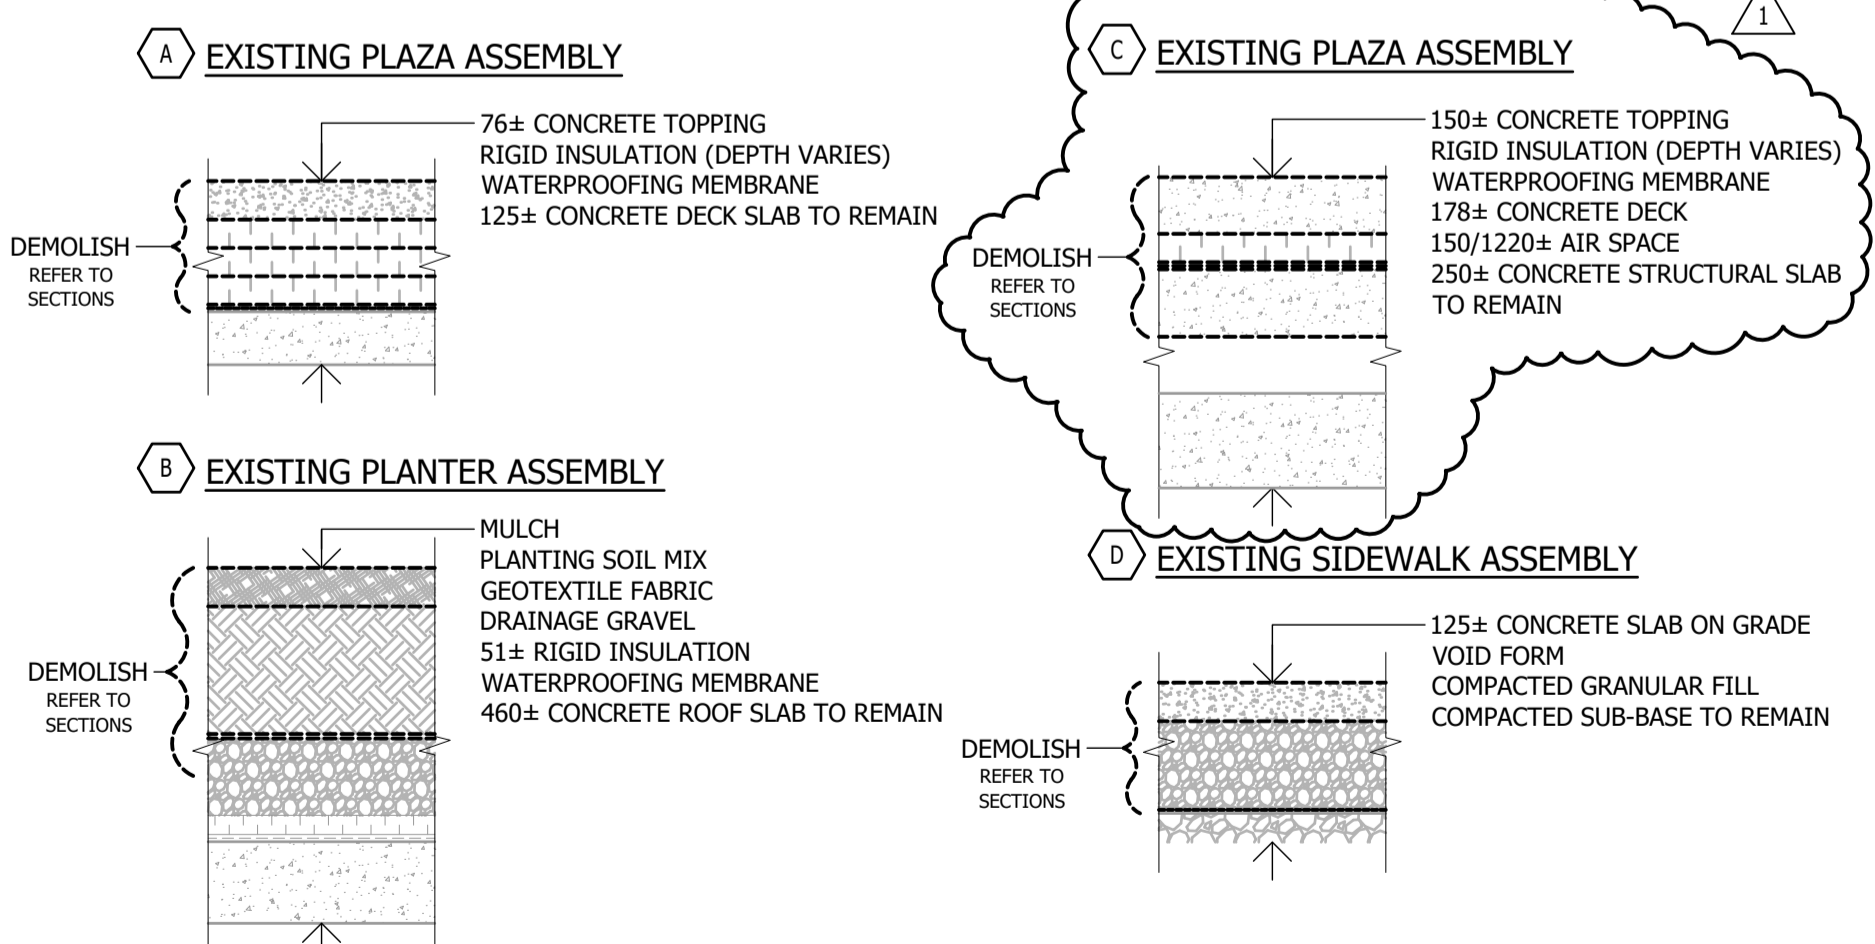

LEGEND	
MARK	DESCRIPTION
---	EXTENTS OF DEMOLITION

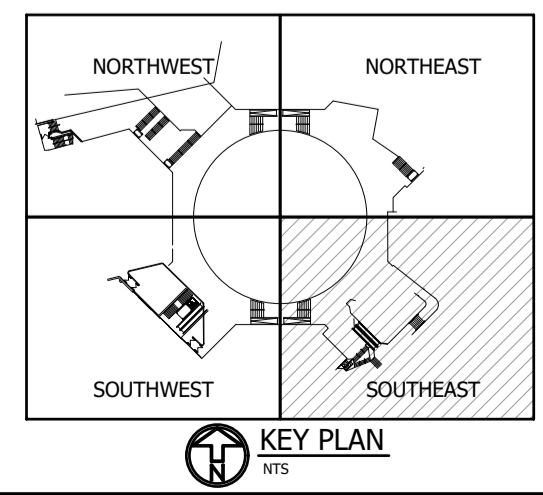

NO.	REVISIONS	DATE	BY
1	ADDENDUM 01	24-09-27	SMC
0	ISSUED FOR TENDER	24-09-09	SMC

B.M. ELEV.	DESIGNED BY	DRAWN BY	CHECKED BY	APPROVED BY	HOR. SCALE	VERTICAL
	SMC/DJM	MS/SAS	SMC	DJM	AS NOTED	AS NOTED

Crosier Kilgour
Structural Engineering & Building Performance

ENGINEER'S SEAL	CONSULTANT PROJECT NUMBER
	2024-0410

THE CITY OF WINNIPEG
PUBLIC WORKS DEPARTMENT

PORTAGE & MAIN PEDESTRIAN OPENING

SOUTHEAST CORNER DEMOLITION PLANS

CITY DRAWING NUMBER: CS-06 OF 25
CONSULTANT DRAWING NUMBER: CS-2.5