



C:\Users\jess\OneDrive - Crosier Kilgour\General - 2024-0410 - Portage & Main Pedestrian Reopening\06 Drawings\2024-0410_PORTAGE-MAIN.dwg

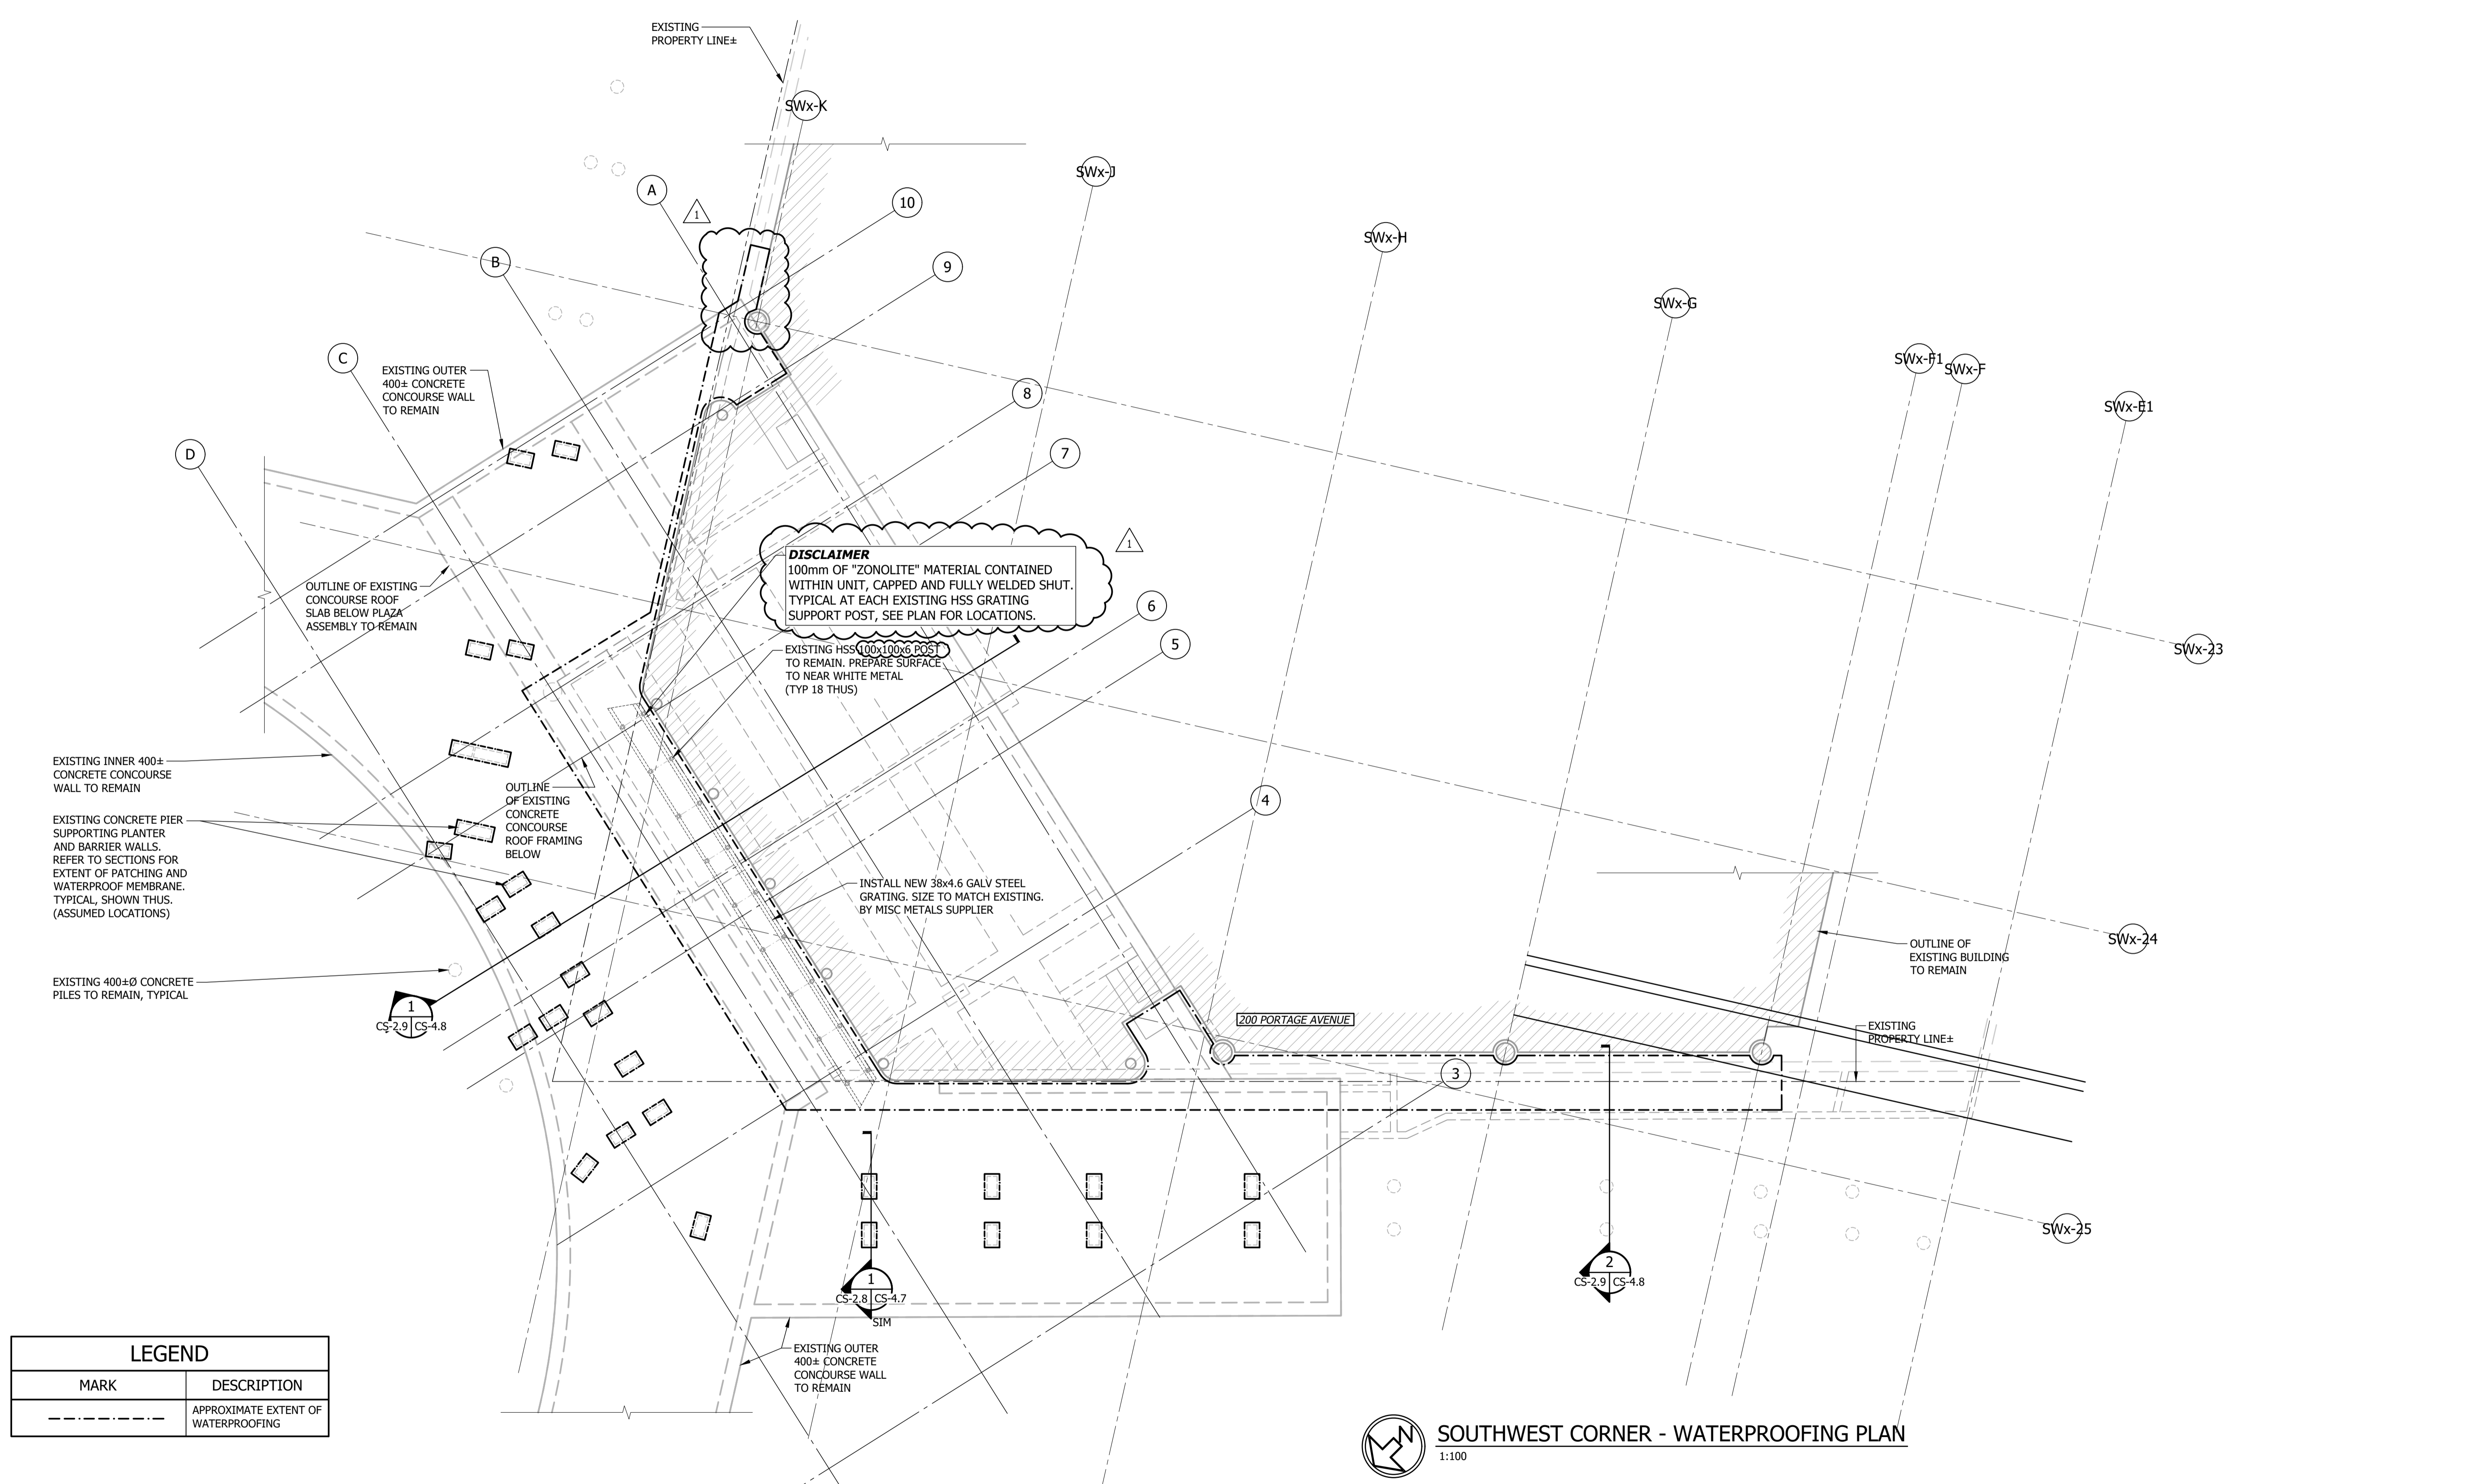

LEGEND	
MARK	DESCRIPTION
---	APPROXIMATE EXTENT OF WATERPROOFING

SOUTHWEST CORNER - WATERPROOFING PLAN
1:100

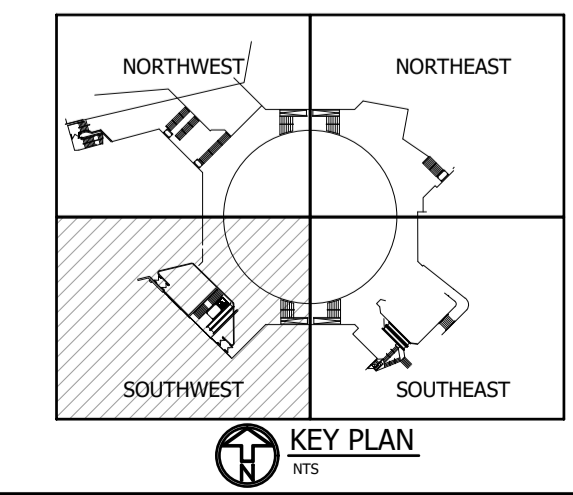

B.M. ELEV.	DESIGNED BY	DATE	BY
	SMC/DJM		
	DRAWN BY		
	MS/SAS		
	CHECKED BY		
	SMC		
	APPROVED BY		
	DJM		
	HOR. SCALE		
	AS NOTED		
	VERTICAL		
	AS NOTED		
NO.	REVISIONS	DATE	BY
1	ADDENDUM 01	24-09-27	SMC
0	ISSUED FOR TENDER	24-09-09	SMC

DATE	BY	DATE	BY
2024-09-27	SMC		
2024-09-27	DJM		

Crosier Kilgour
Structural Engineering & Building Performance

RELEASED FOR CONSTRUCTION

ENGINEER'S SEAL
CONSULTANT PROJECT NUMBER
2024-0410

THE CITY OF WINNIPEG
PUBLIC WORKS DEPARTMENT

PORTAGE & MAIN PEDESTRIAN OPENING

SOUTHWEST CORNER WATERPROOFING PLAN

CITY DRAWING NUMBER: CS-10 OF 25
CONSULTANT DRAWING NUMBER: CS-2.9