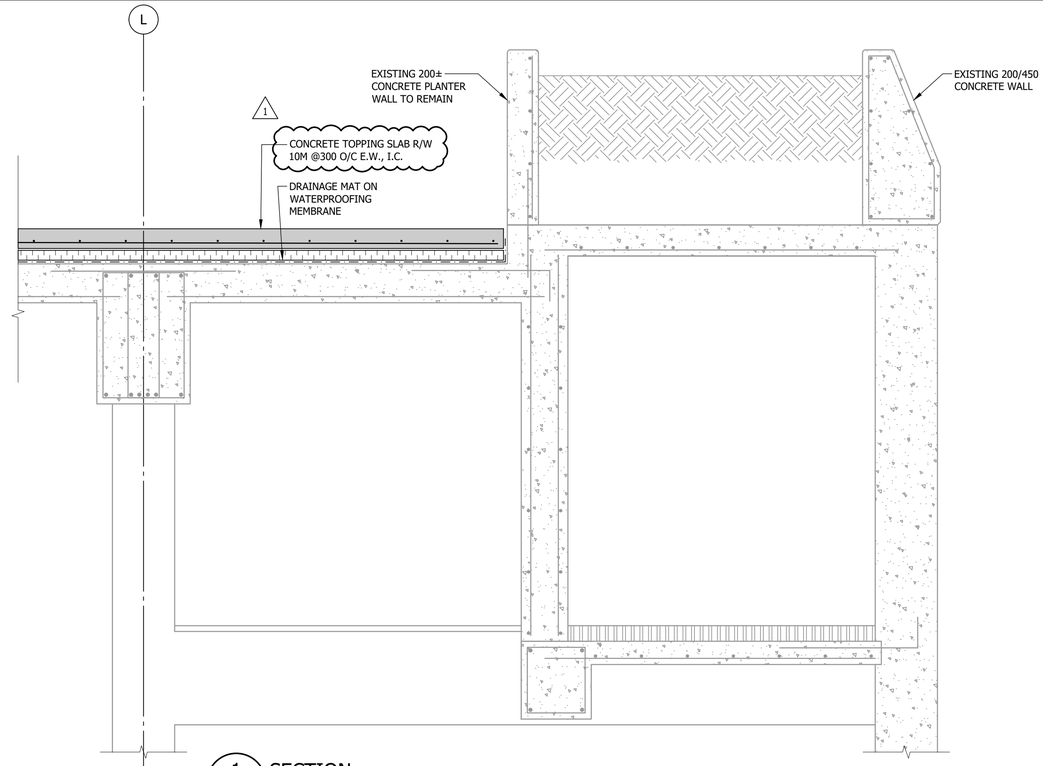

1 SECTION
CS-2.10 CS-4.10 1:20

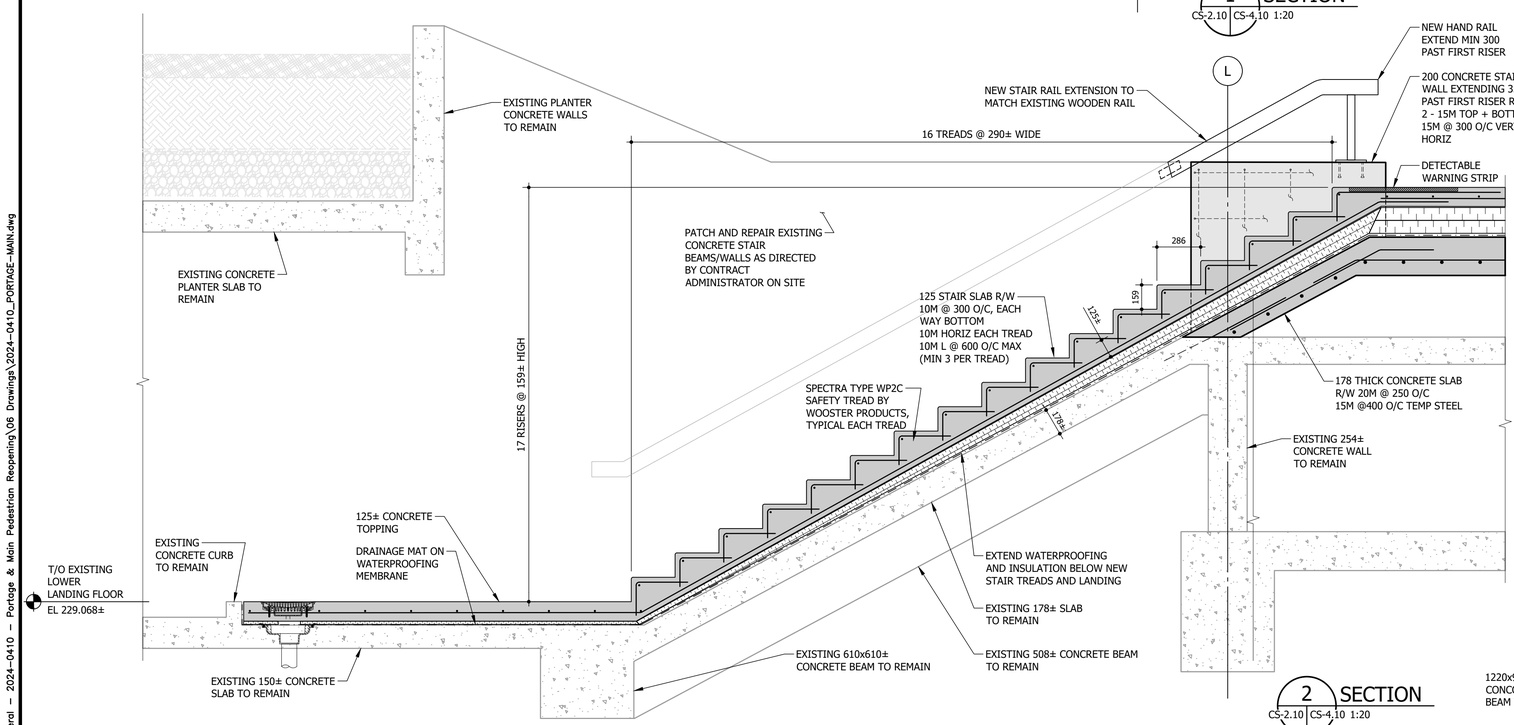

2 SECTION
CS-2.10 CS-4.10 1:20

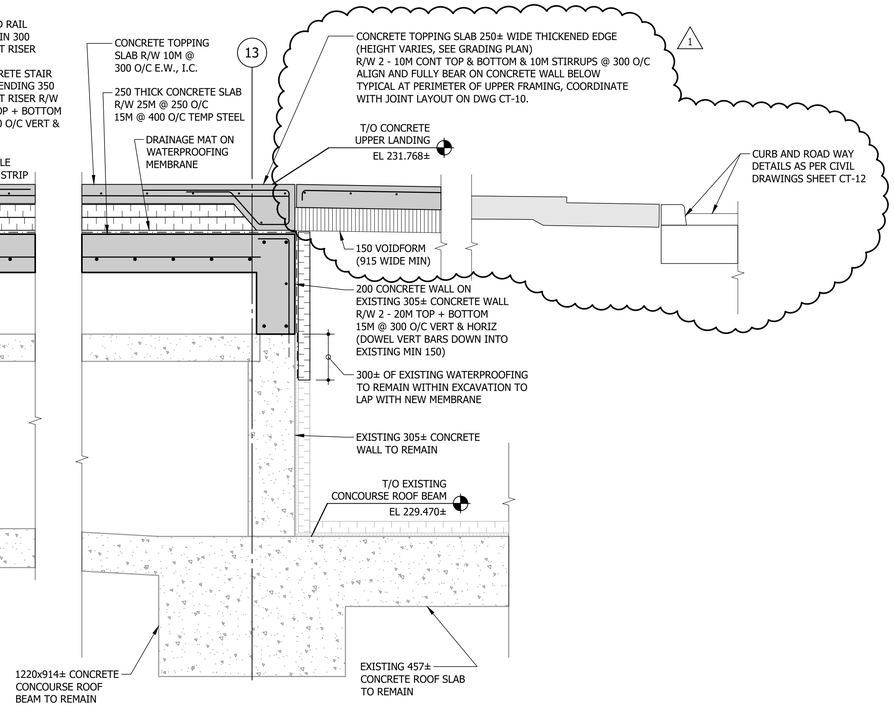

NO.	REVISIONS	DATE	BY
1	ADDENDUM 01	24-09-27	SMC
0	ISSUED FOR TENDER	24-09-09	SMC

B.M. ELEV.

DESIGNED BY	SMC/DJM
DRAWN BY	MS/SAS
CHECKED BY	SMC
APPROVED BY	DJM
HOR. SCALE	AS NOTED
VERTICAL	AS NOTED
DATE	2024–09–27

Crosier Kilgour
Structural Engineering & Building Performance

RELEASED FOR CONSTRUCTION

DATE

ENGINEER'S SEAL

CONSULTANT PROJECT NUMBER
2024-0410

Winnipeg
THE CITY OF WINNIPEG
PUBLIC WORKS DEPARTMENT

PORTAGE & MAIN PEDESTRIAN OPENING

CITY DRAWING NUMBER
SHEET CS-21 OF 25

SECTIONS & DETAILS
SOUTHEAST CORNER

CONSULTANT DRAWING NUMBER
CS-4.10

C:\Users\sas\OneDrive – Crosier Kilgour\General – 2024–0410 – Portage & Main Pedestrian Reopening\06 Drawings\2024–0410_PORTAGE–MAIN.dwg