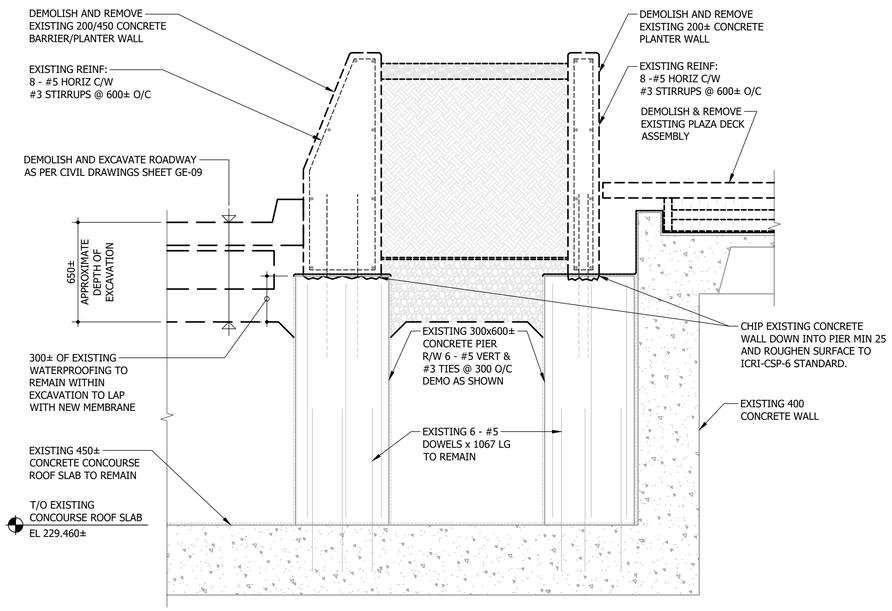

1 SECTION - DEMO
CS-2.3 CS-4.2 1:20

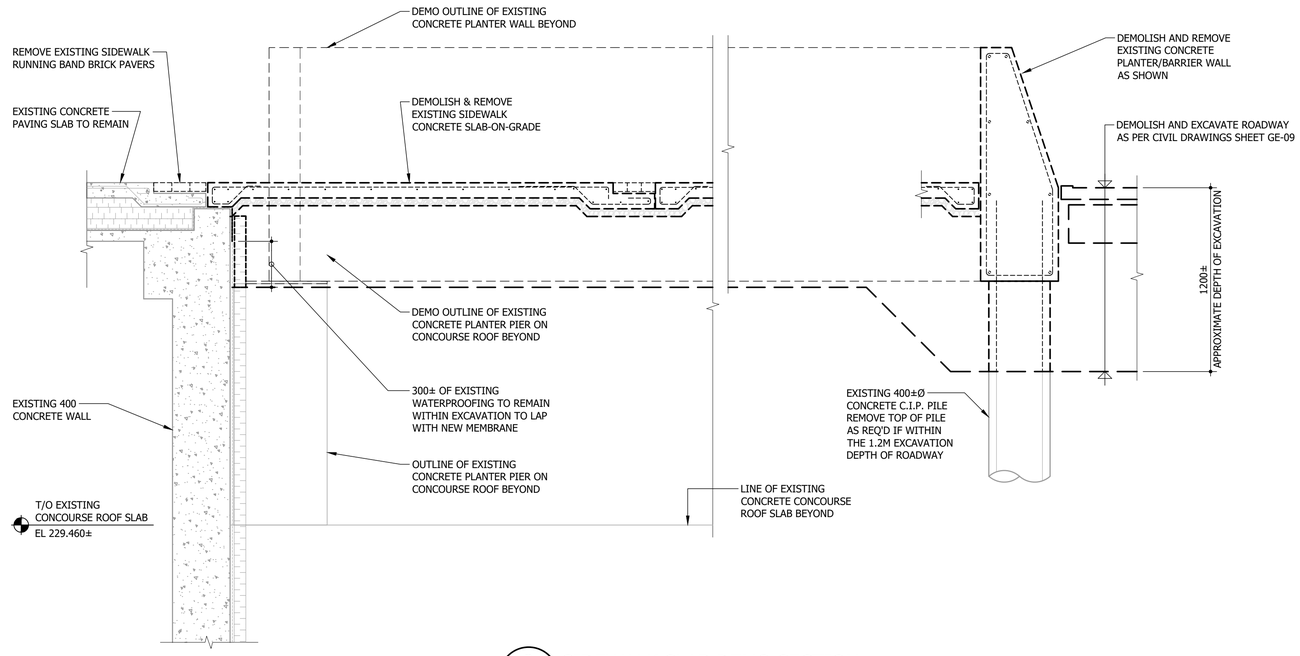

2 SIDEWALK SLAB DEMO SECTION
CS-2.3 CS-4.2 1:20

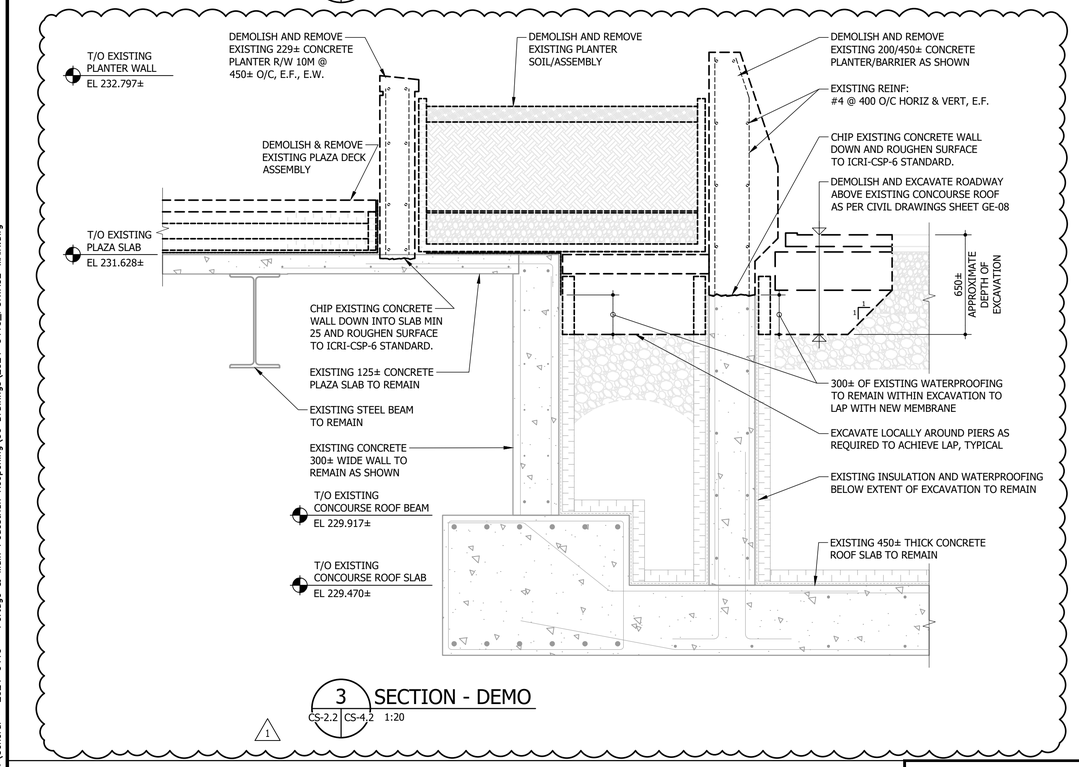

3 SECTION - DEMO
CS-2.2 CS-4.2 1:20

1

C:\Users\sas\OneDrive – Crosier Kilgour\General – 2024-0410 – Portage & Main Pedestrian Reopening\06 Drawings\2024-0410_PORTAGE-MAIN.dwg

NO.	REVISIONS	DATE	BY
1	ADDENDUM 01	24-09-27	SMC
0	ISSUED FOR TENDER	24-09-09	SMC

B.M. ELEV.

DESIGNED BY	SMC/DJM
DRAWN BY	MS/SAS
CHECKED BY	SMC
APPROVED BY	DJM
HOR. SCALE	AS NOTED
VERTICAL	AS NOTED
DATE	2024–09–27

Crosier Kilgour
Structural Engineering & Building Performance

RELEASED FOR CONSTRUCTION
DATE

ENGINEER'S SEAL

CONSULTANT PROJECT NUMBER
2024-0410

Winnipeg
THE CITY OF WINNIPEG
PUBLIC WORKS DEPARTMENT

PORTAGE & MAIN PEDESTRIAN OPENING

CITY DRAWING NUMBER
SHEET CS-13 OF 25

SECTIONS & DETAILS
NORTHEAST CORNER

CONSULTANT DRAWING NUMBER
CS-4.2