


1 SECTION
CS-2.8 | CS-4.7 | 1:20

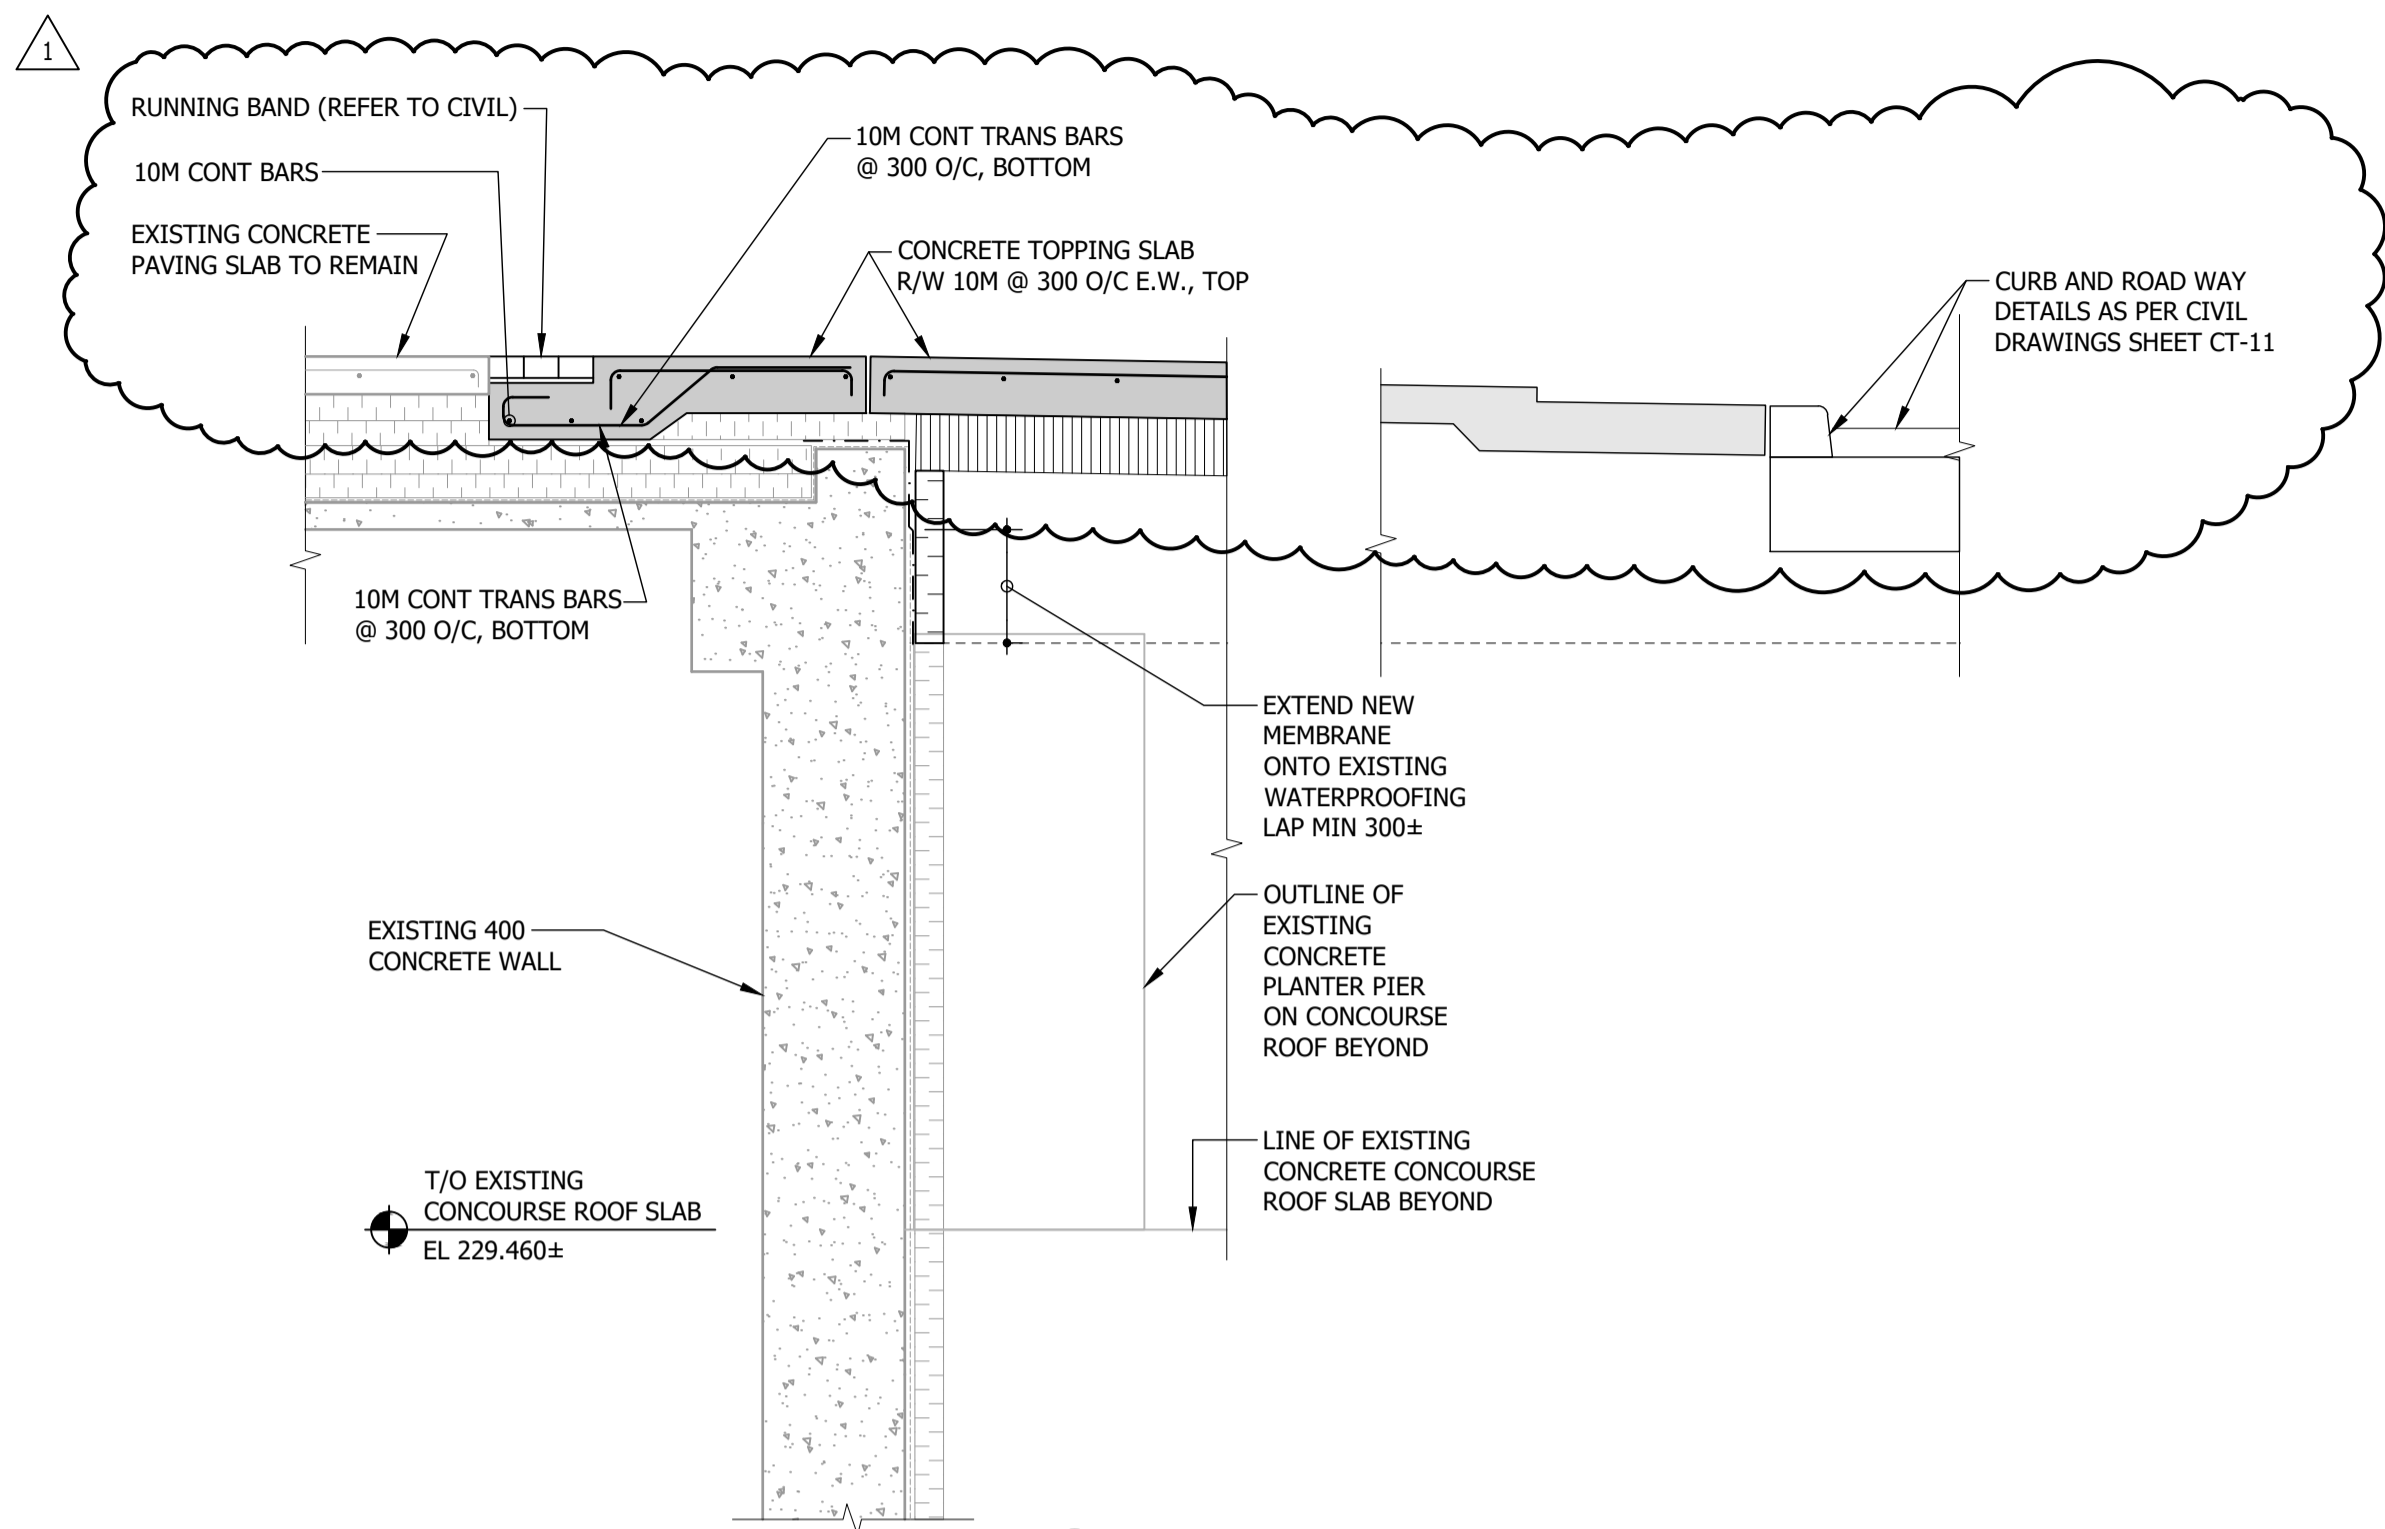

2 SECTION
CS-2.8 | CS-4.7 | 1:20

C:\Users\veas\OneDrive - Crosier Kilgour\General - 2024-0410 - Portage & Main Pedestrian Resealing\06 Drawings\2024-0410_PORTAGE-MAIN.dwg

B.M. ELEV.	DESIGNED BY	DATE	BY
	SMC/DJM		
	DRAWN BY		MS/SAS
	CHECKED BY		SMC
	APPROVED BY		DJM
1	ADDENDUM 01	24-09-27	SMC
0	ISSUED FOR TENDER	24-09-09	SMC
NO.	REVISIONS	DATE	BY
		2024-09-27	

HOR. SCALE	AS NOTED
VERTICAL	AS NOTED
DATE	2024-09-27

Crosier Kilgour
Structural Engineering & Building Performance

RELEASED FOR CONSTRUCTION

DATE

ENGINEER'S SEAL
CONSULTANT PROJECT NUMBER
2024-0410

THE CITY OF WINNIPEG
PUBLIC WORKS DEPARTMENT

PORTAGE & MAIN PEDESTRIAN OPENING

SECTIONS & DETAILS
NORTHEAST CORNER

CITY DRAWING NUMBER	
SHEET OF	CS-18 OF 25
CONSULTANT DRAWING NUMBER	CS-4.7