



C:\Users\veas\OneDrive - Crosier Kilgour\General - 2024-0410 - Portage & Main Pedestrian Reopening\06 Drawings\2024-0410_PORTAGE-MAIN.dwg

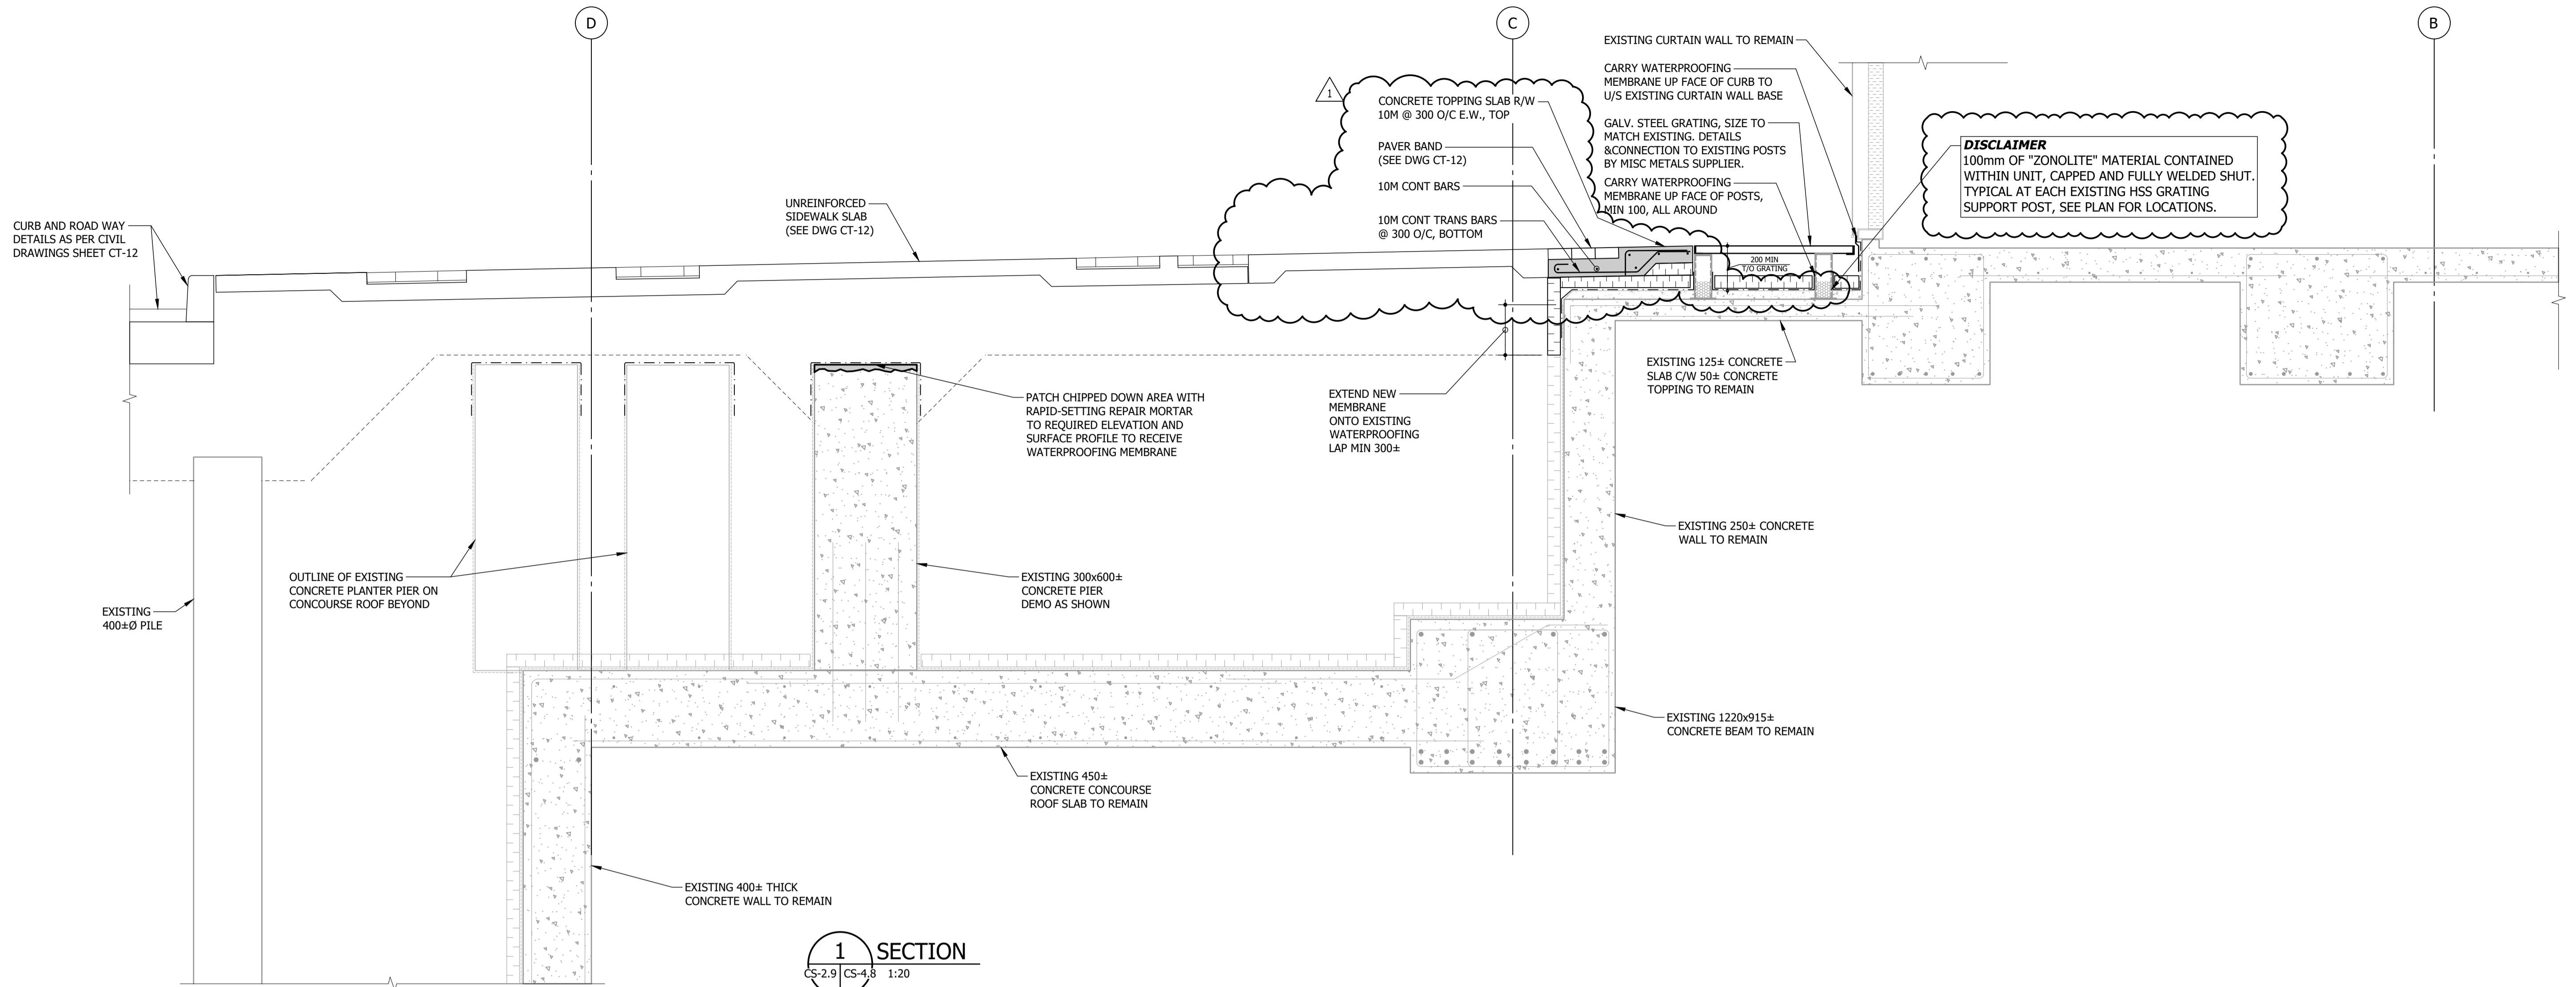

1 SECTION
CS-2.9 | CS-4.8 | 1:20

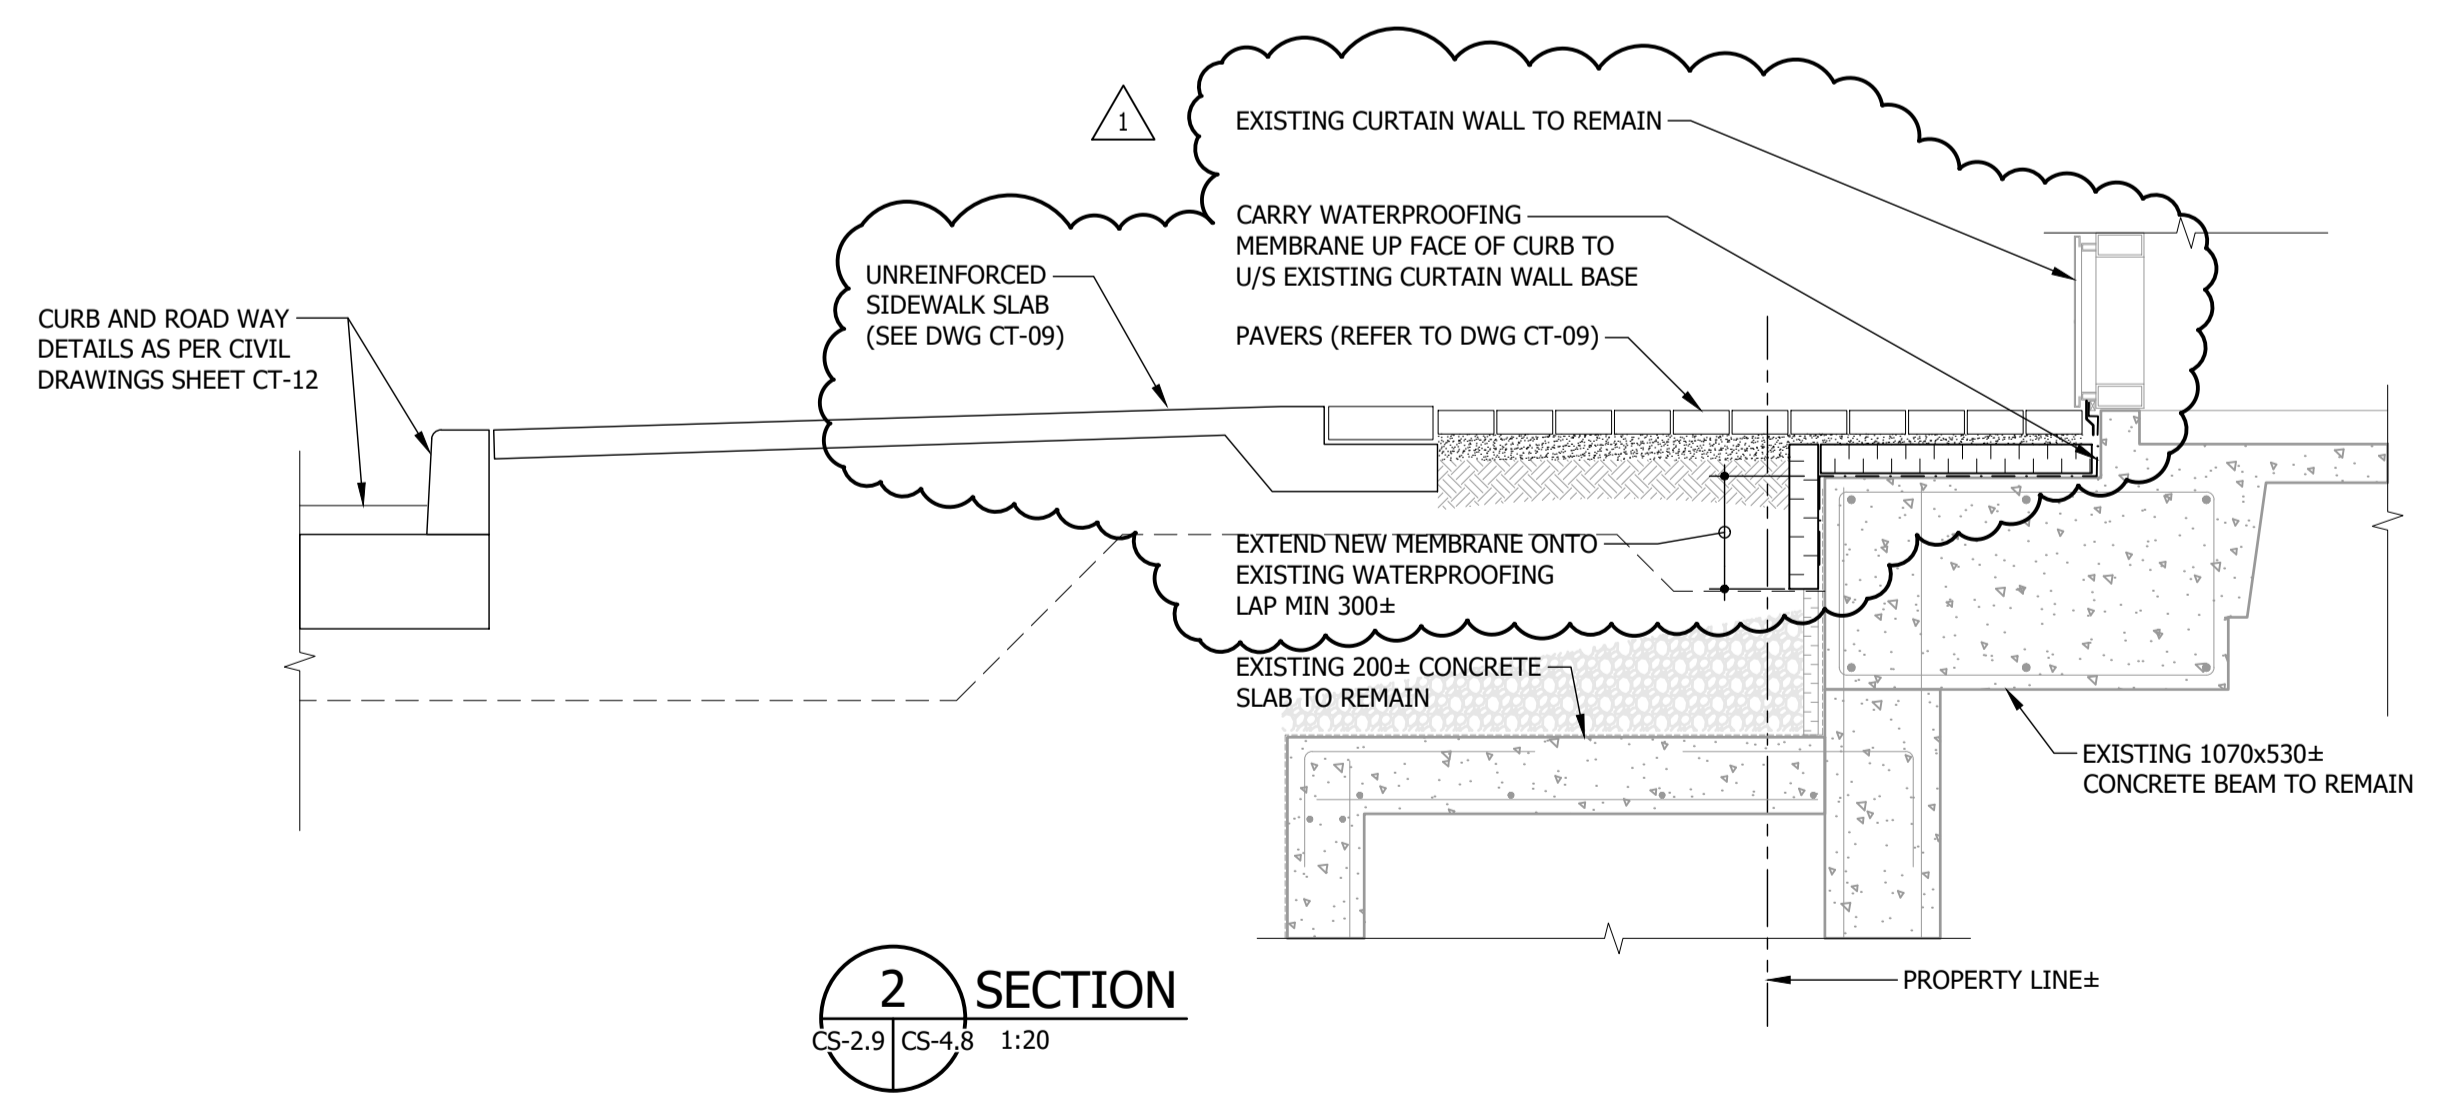

2 SECTION
CS-2.9 | CS-4.8 | 1:20

B.M. ELEV.	DESIGNED BY	SMC/DJM
	DRAWN BY	MS/SAS
	CHECKED BY	SMC
	APPROVED BY	DJM
1	ADDENDUM 01	24-09-27 SMC
0	ISSUED FOR TENDER	24-09-09 SMC
NO.	REVISIONS	DATE BY DATE

HOR. SCALE	AS NOTED
VERTICAL	AS NOTED
DATE	2024-09-27

Crosier Kilgour
Structural Engineering & Building Performance

RELEASED FOR CONSTRUCTION

ENGINEER'S SEAL	
CONSULTANT PROJECT NUMBER	2024-0410

THE CITY OF WINNIPEG
PUBLIC WORKS DEPARTMENT

PORTAGE & MAIN PEDESTRIAN OPENING

SECTIONS & DETAILS
SOUTHWEST CORNER

CITY DRAWING NUMBER	
SHEET OF	CS-19 OF 25
CONSULTANT DRAWING NUMBER	CS-4.8