
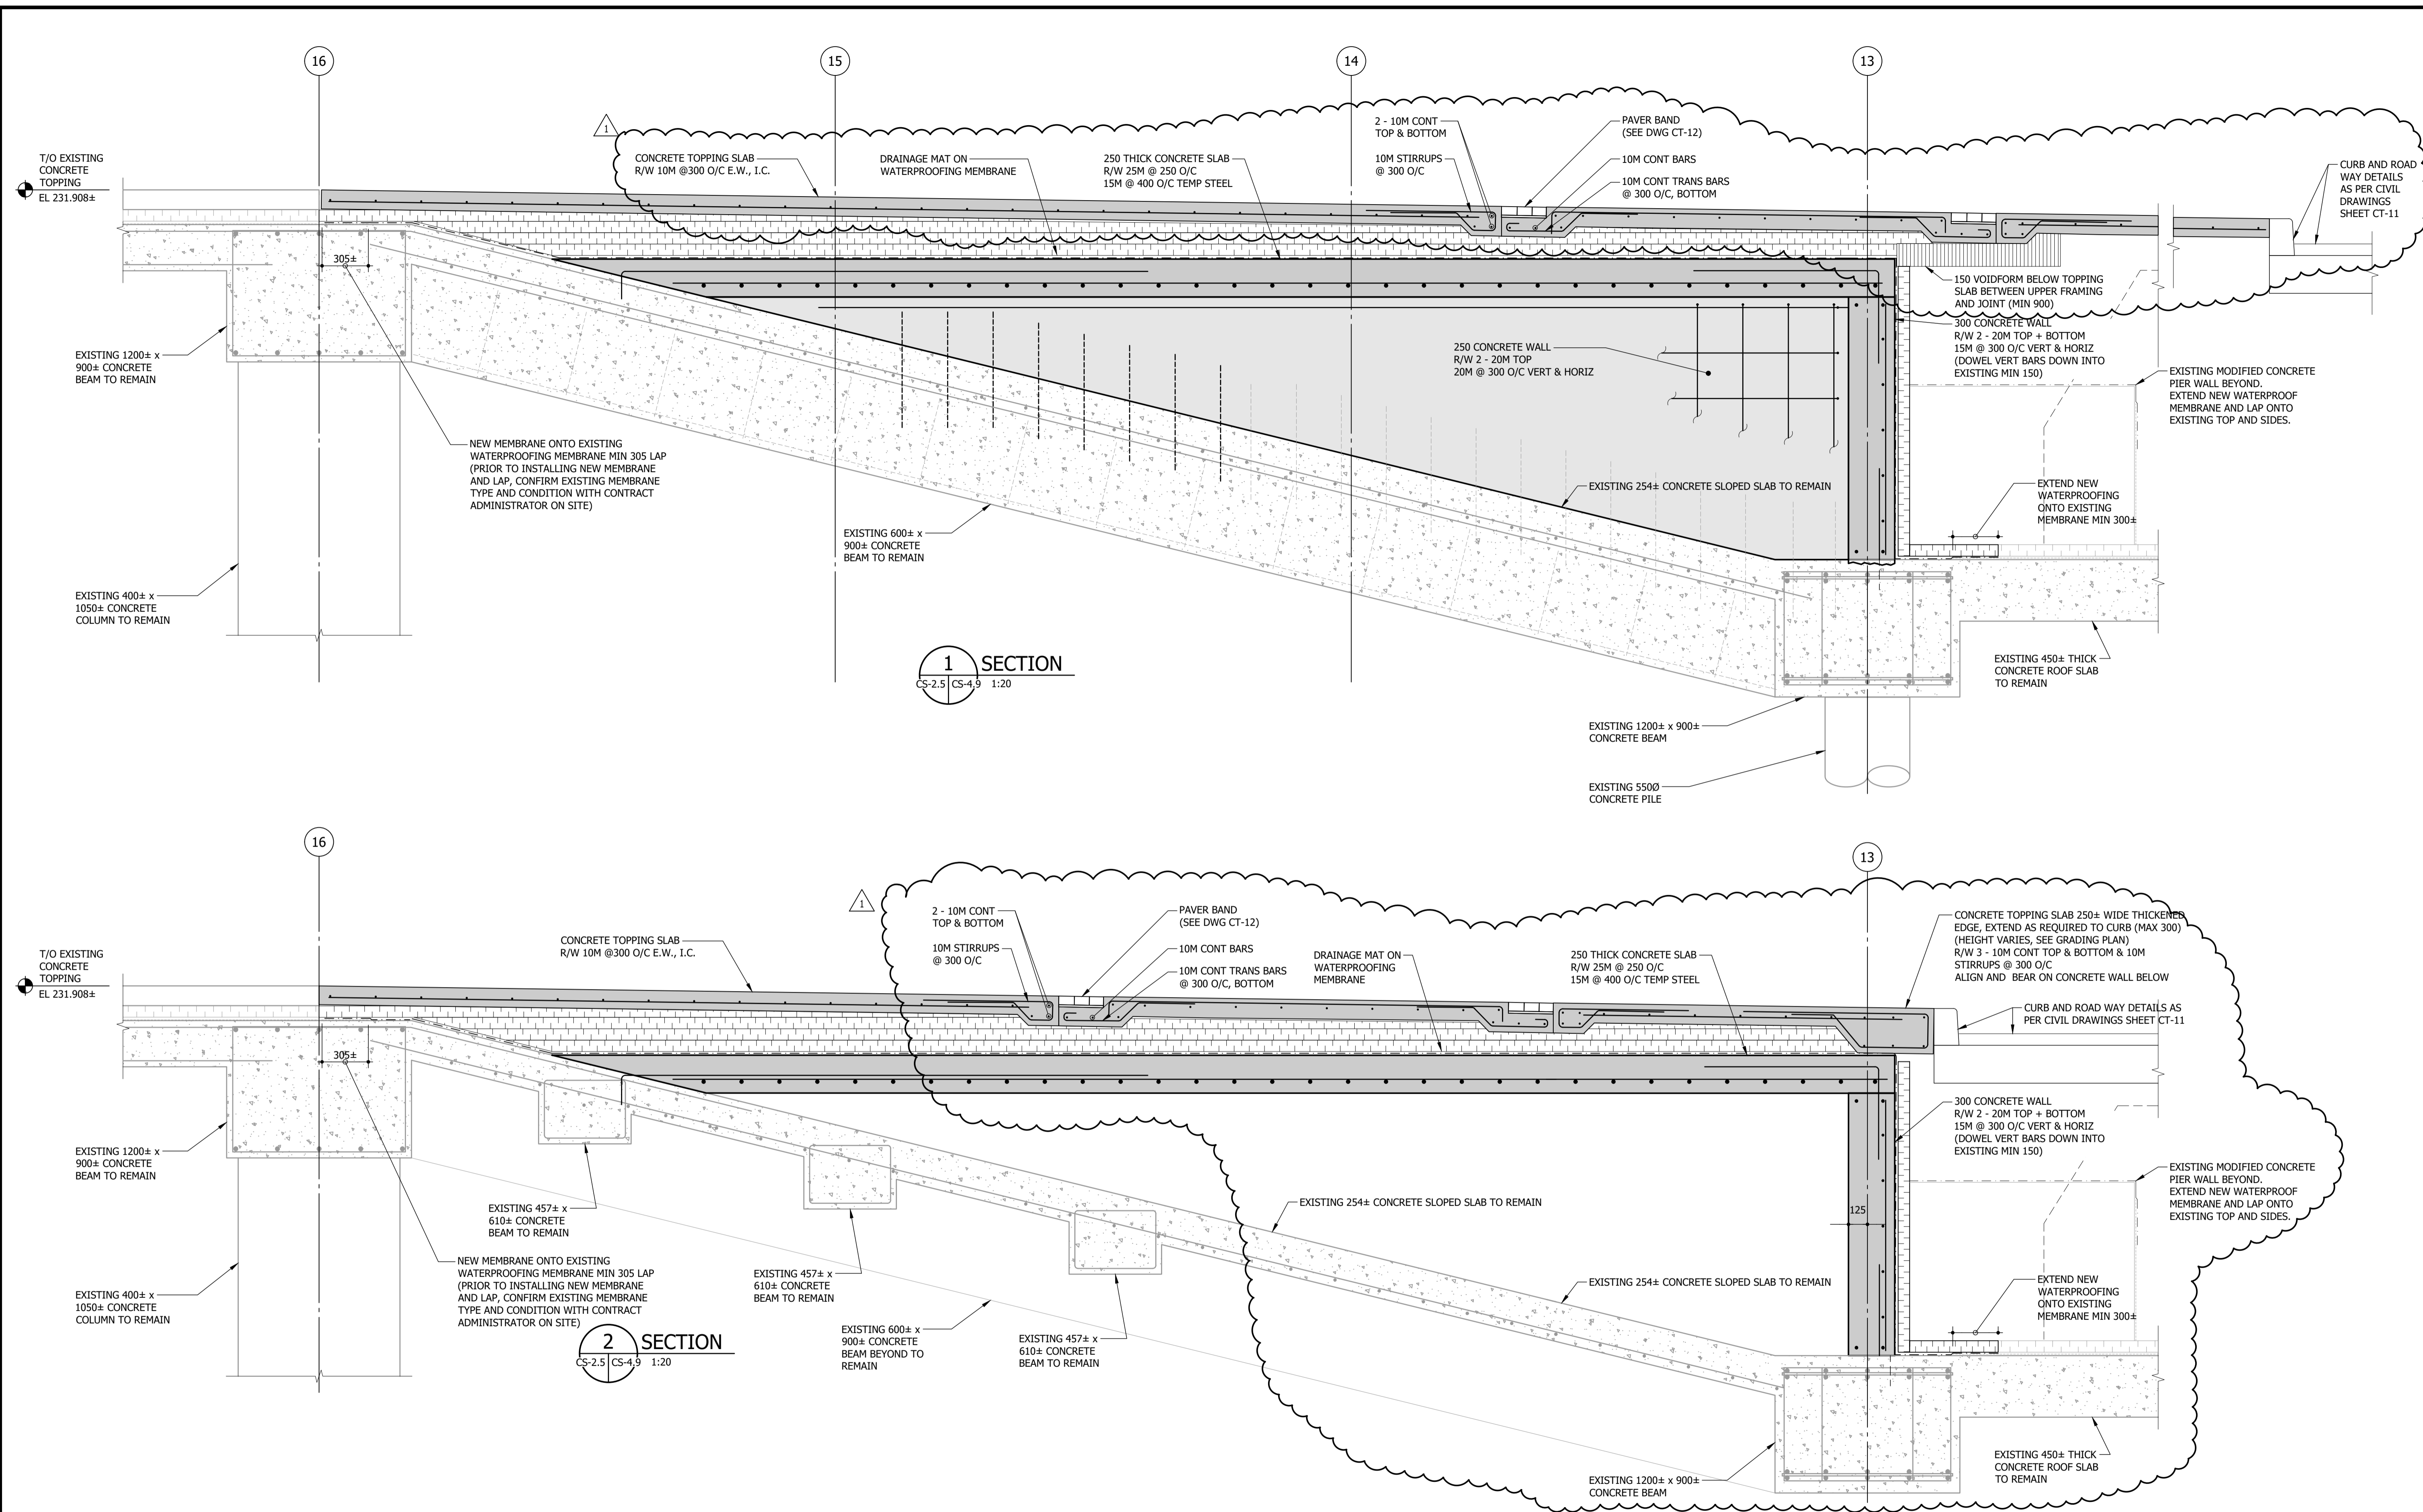



C:\Users\jess\OneDrive - Crosier Kilgour\General - 2024-0410 - Portage & Main Pedestrian Reopening\06 Drawings\2024-0410\_PORTAGE-MAIN.dwg

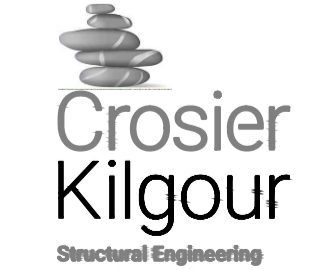

**1 SECTION**  
CS-2.5 | CS-4.9 | 1:20

**2 SECTION**  
CS-2.5 | CS-4.9 | 1:20

B.M. ELEV.		DESIGNED BY	SMC/DJM	 Structural Engineering & Building Performance	ENGINEER'S SEAL	 <b>THE CITY OF WINNIPEG</b> PUBLIC WORKS DEPARTMENT	
		DRAWN BY	MS/SAS		PORTAGE & MAIN PEDESTRIAN OPENING CITY DRAWING NUMBER		
		CHECKED BY	SMC			SHEET OF CS-20 OF 25	
		APPROVED BY	DJM		CONSULTANT DRAWING NUMBER CS-4.9		
1	ADDENDUM 01	24-09-27	SMC	HOR. SCALE	AS NOTED	RELEASED FOR CONSTRUCTION	CONSULTANT PROJECT NUMBER 2024-0410
0	ISSUED FOR TENDER	24-09-09	SMC	VERTICAL	AS NOTED	DATE	
NO.	REVISIONS	DATE	BY	DATE	2024-09-27	DATE	